


JOHNSTOWN COAL AND COKE CO

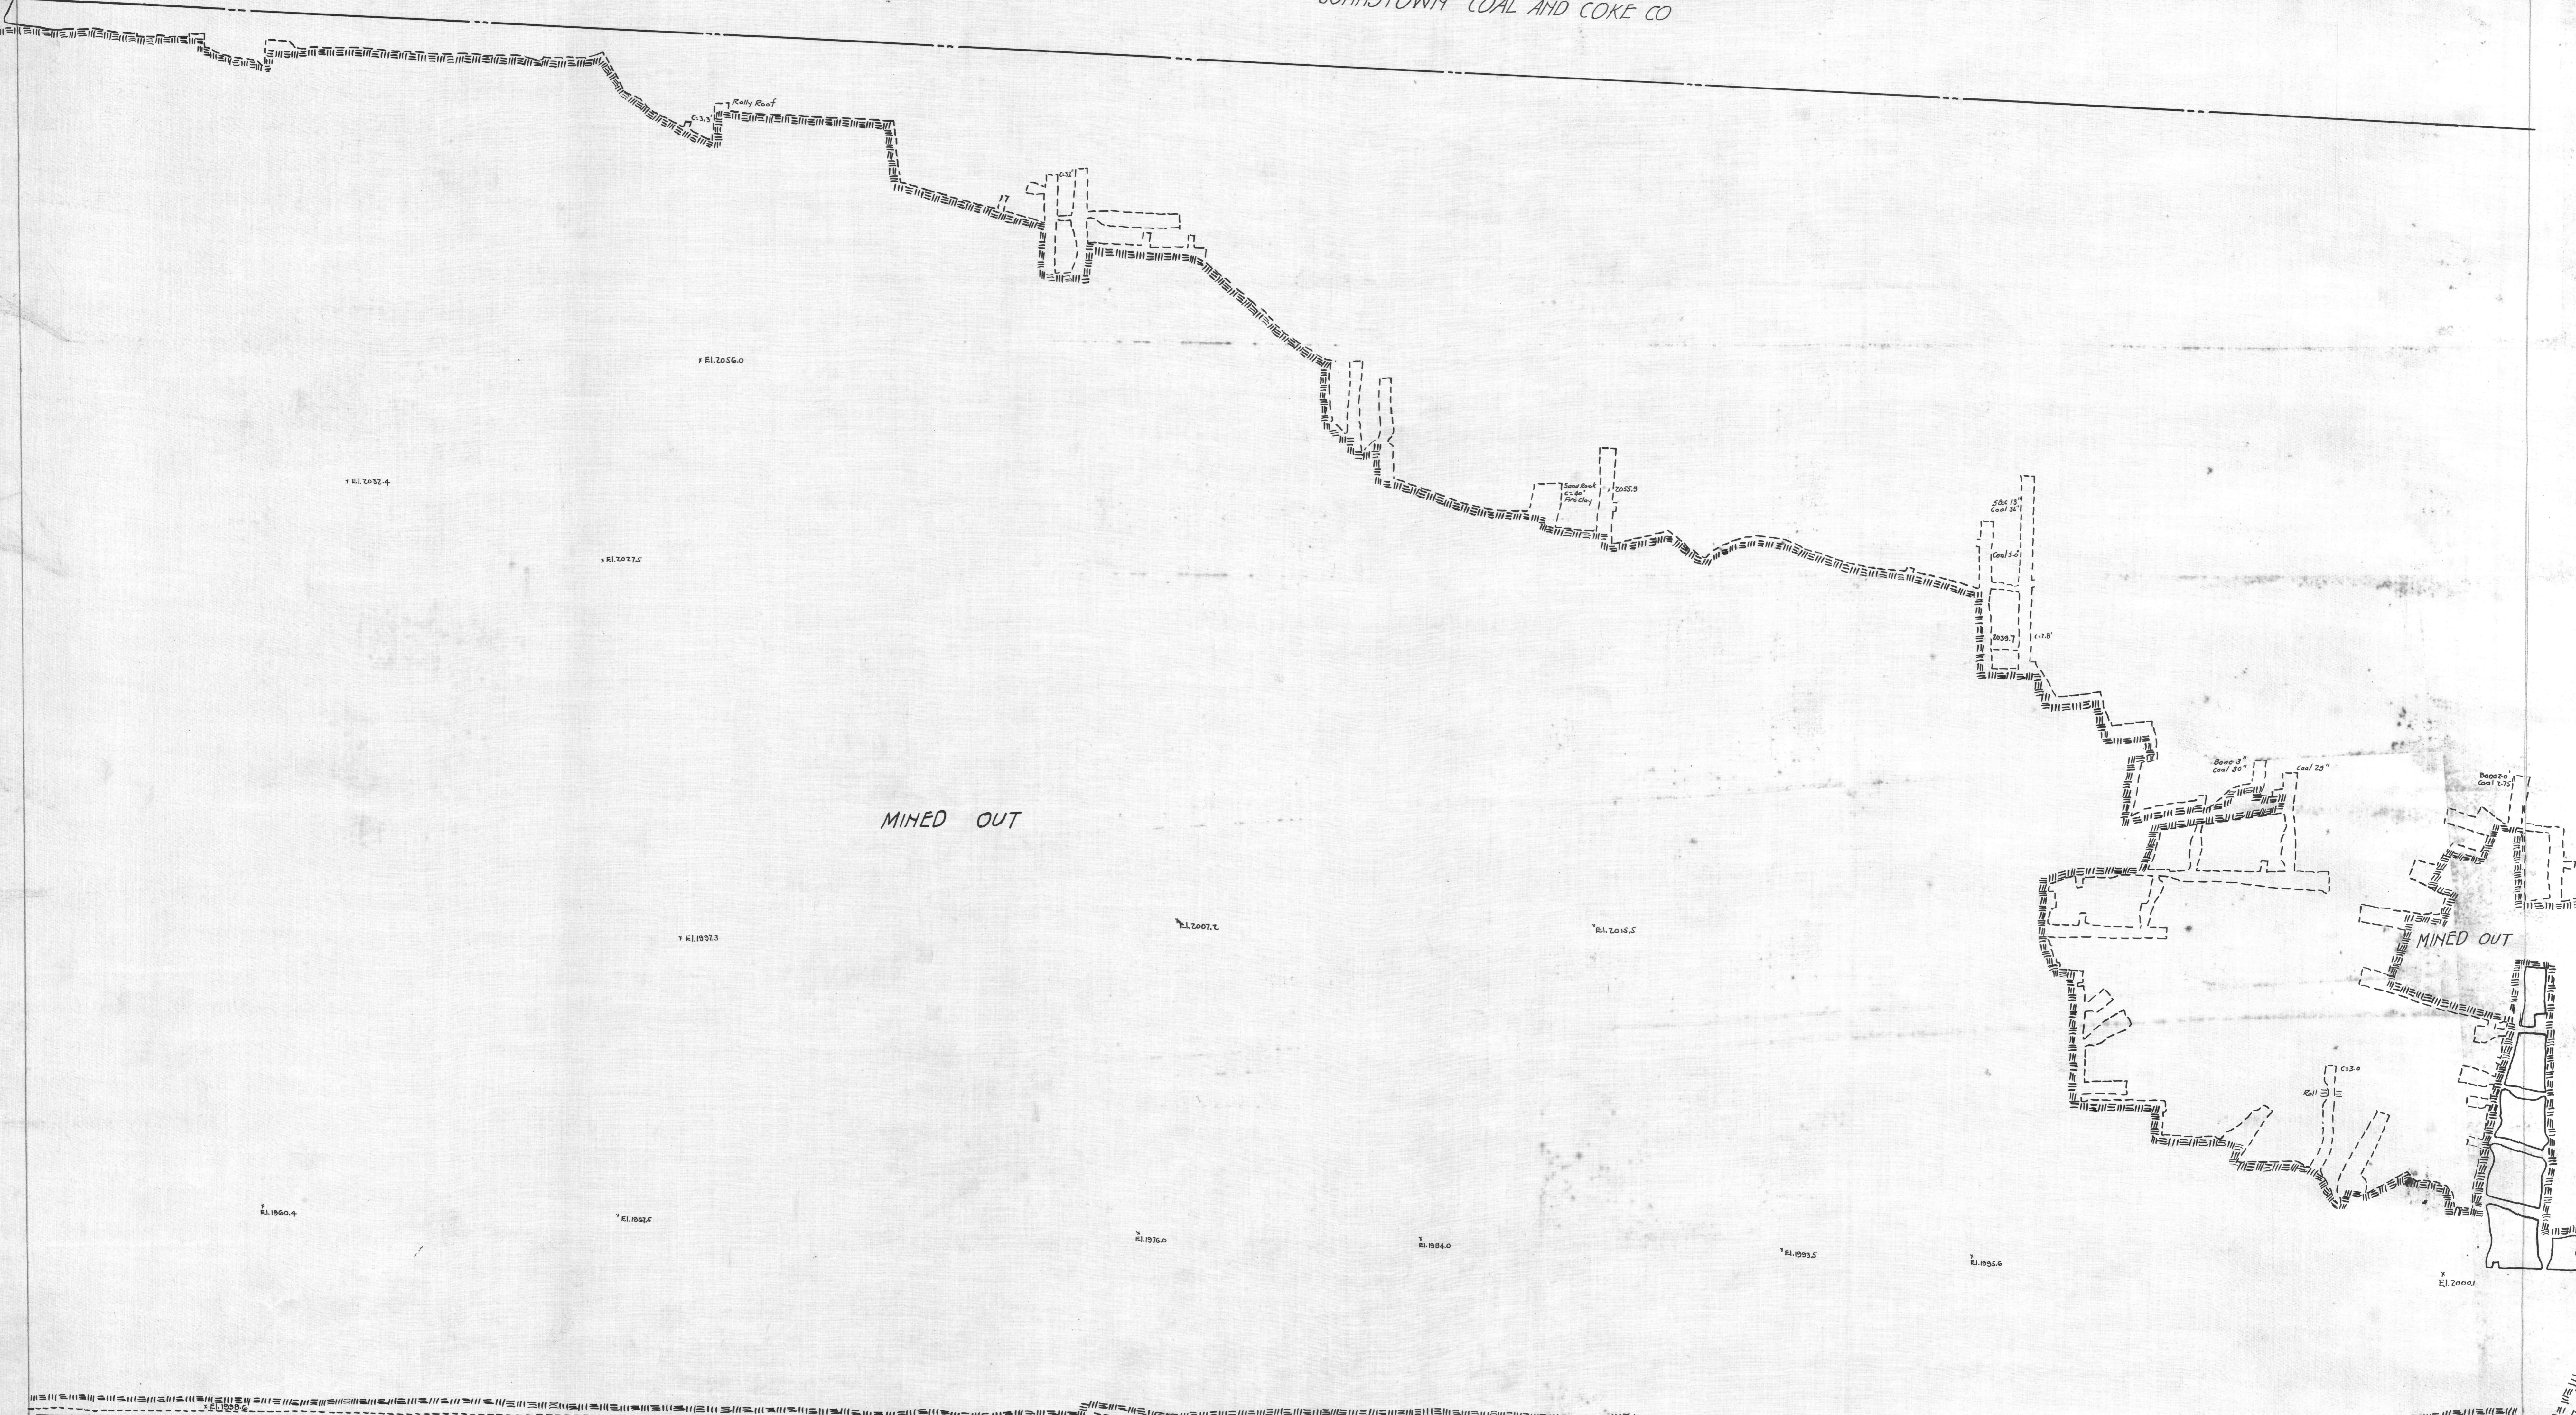

MINED OUT

MINED OUT