


53 ACRES RECEIVED BY MORRISON & STEVENS IN EXCHANGE FOR
A. V. BARKER TRACT

MAP OF
DYSART No 2 MINE
ON LANDS OF
J. S. MORRISON & A. A. STEVENS
UNDER LEASE TO
SUGAR RUN COAL MINING CO.
DEAN TOWNSHIP, CAMBRIA COUNTY, PENNA.

SCALE: 1"=100'

J. S. SILLYMAN & CO.
ENGINEERS
CID20-1

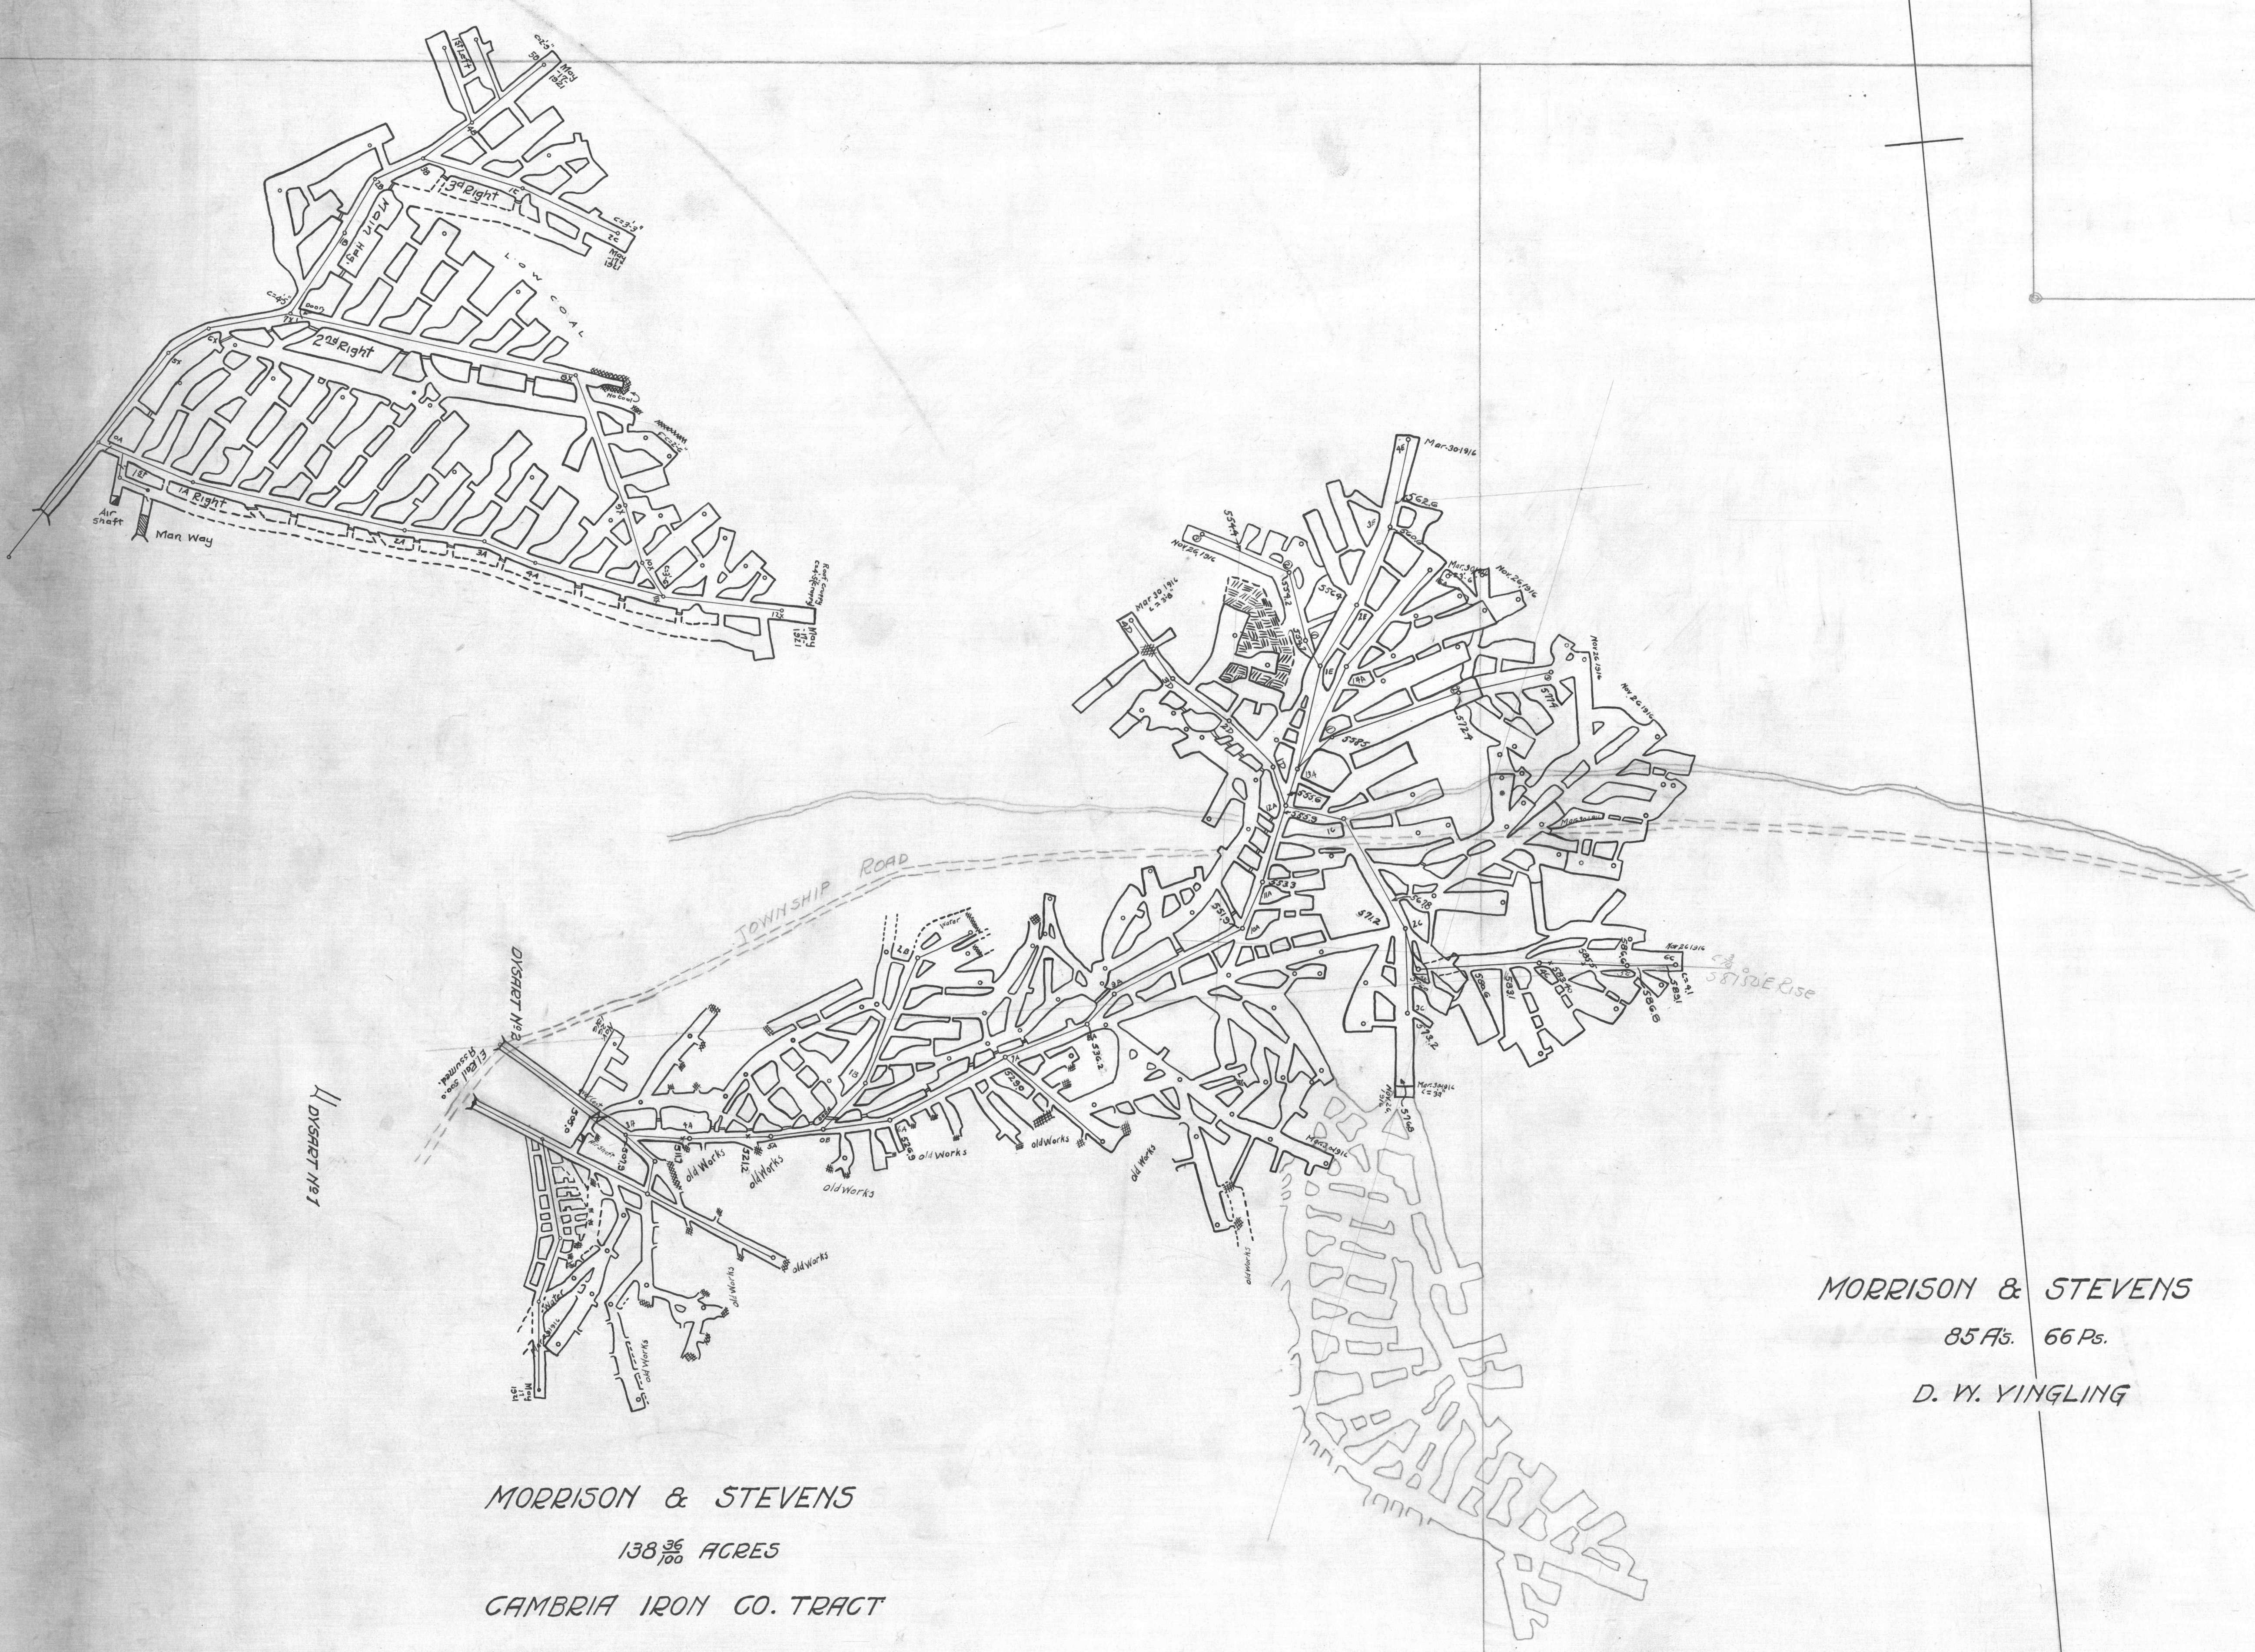

MORRISON & STEVENS
130 ACRES
CAMBRIA IRON CO. TRACT

MORRISON & STEVENS
85 Acs. 66 Ps.
D. W. YINGLING

MORRISON & STEVENS
47 Acs. 124 Ps.
D. W. YINGLING

DEAN TOWNSHIP DUFF