


MORRISON & STEVENS  
130 1/2 ACRES  
CAMBRIA IRON CO. TRACT

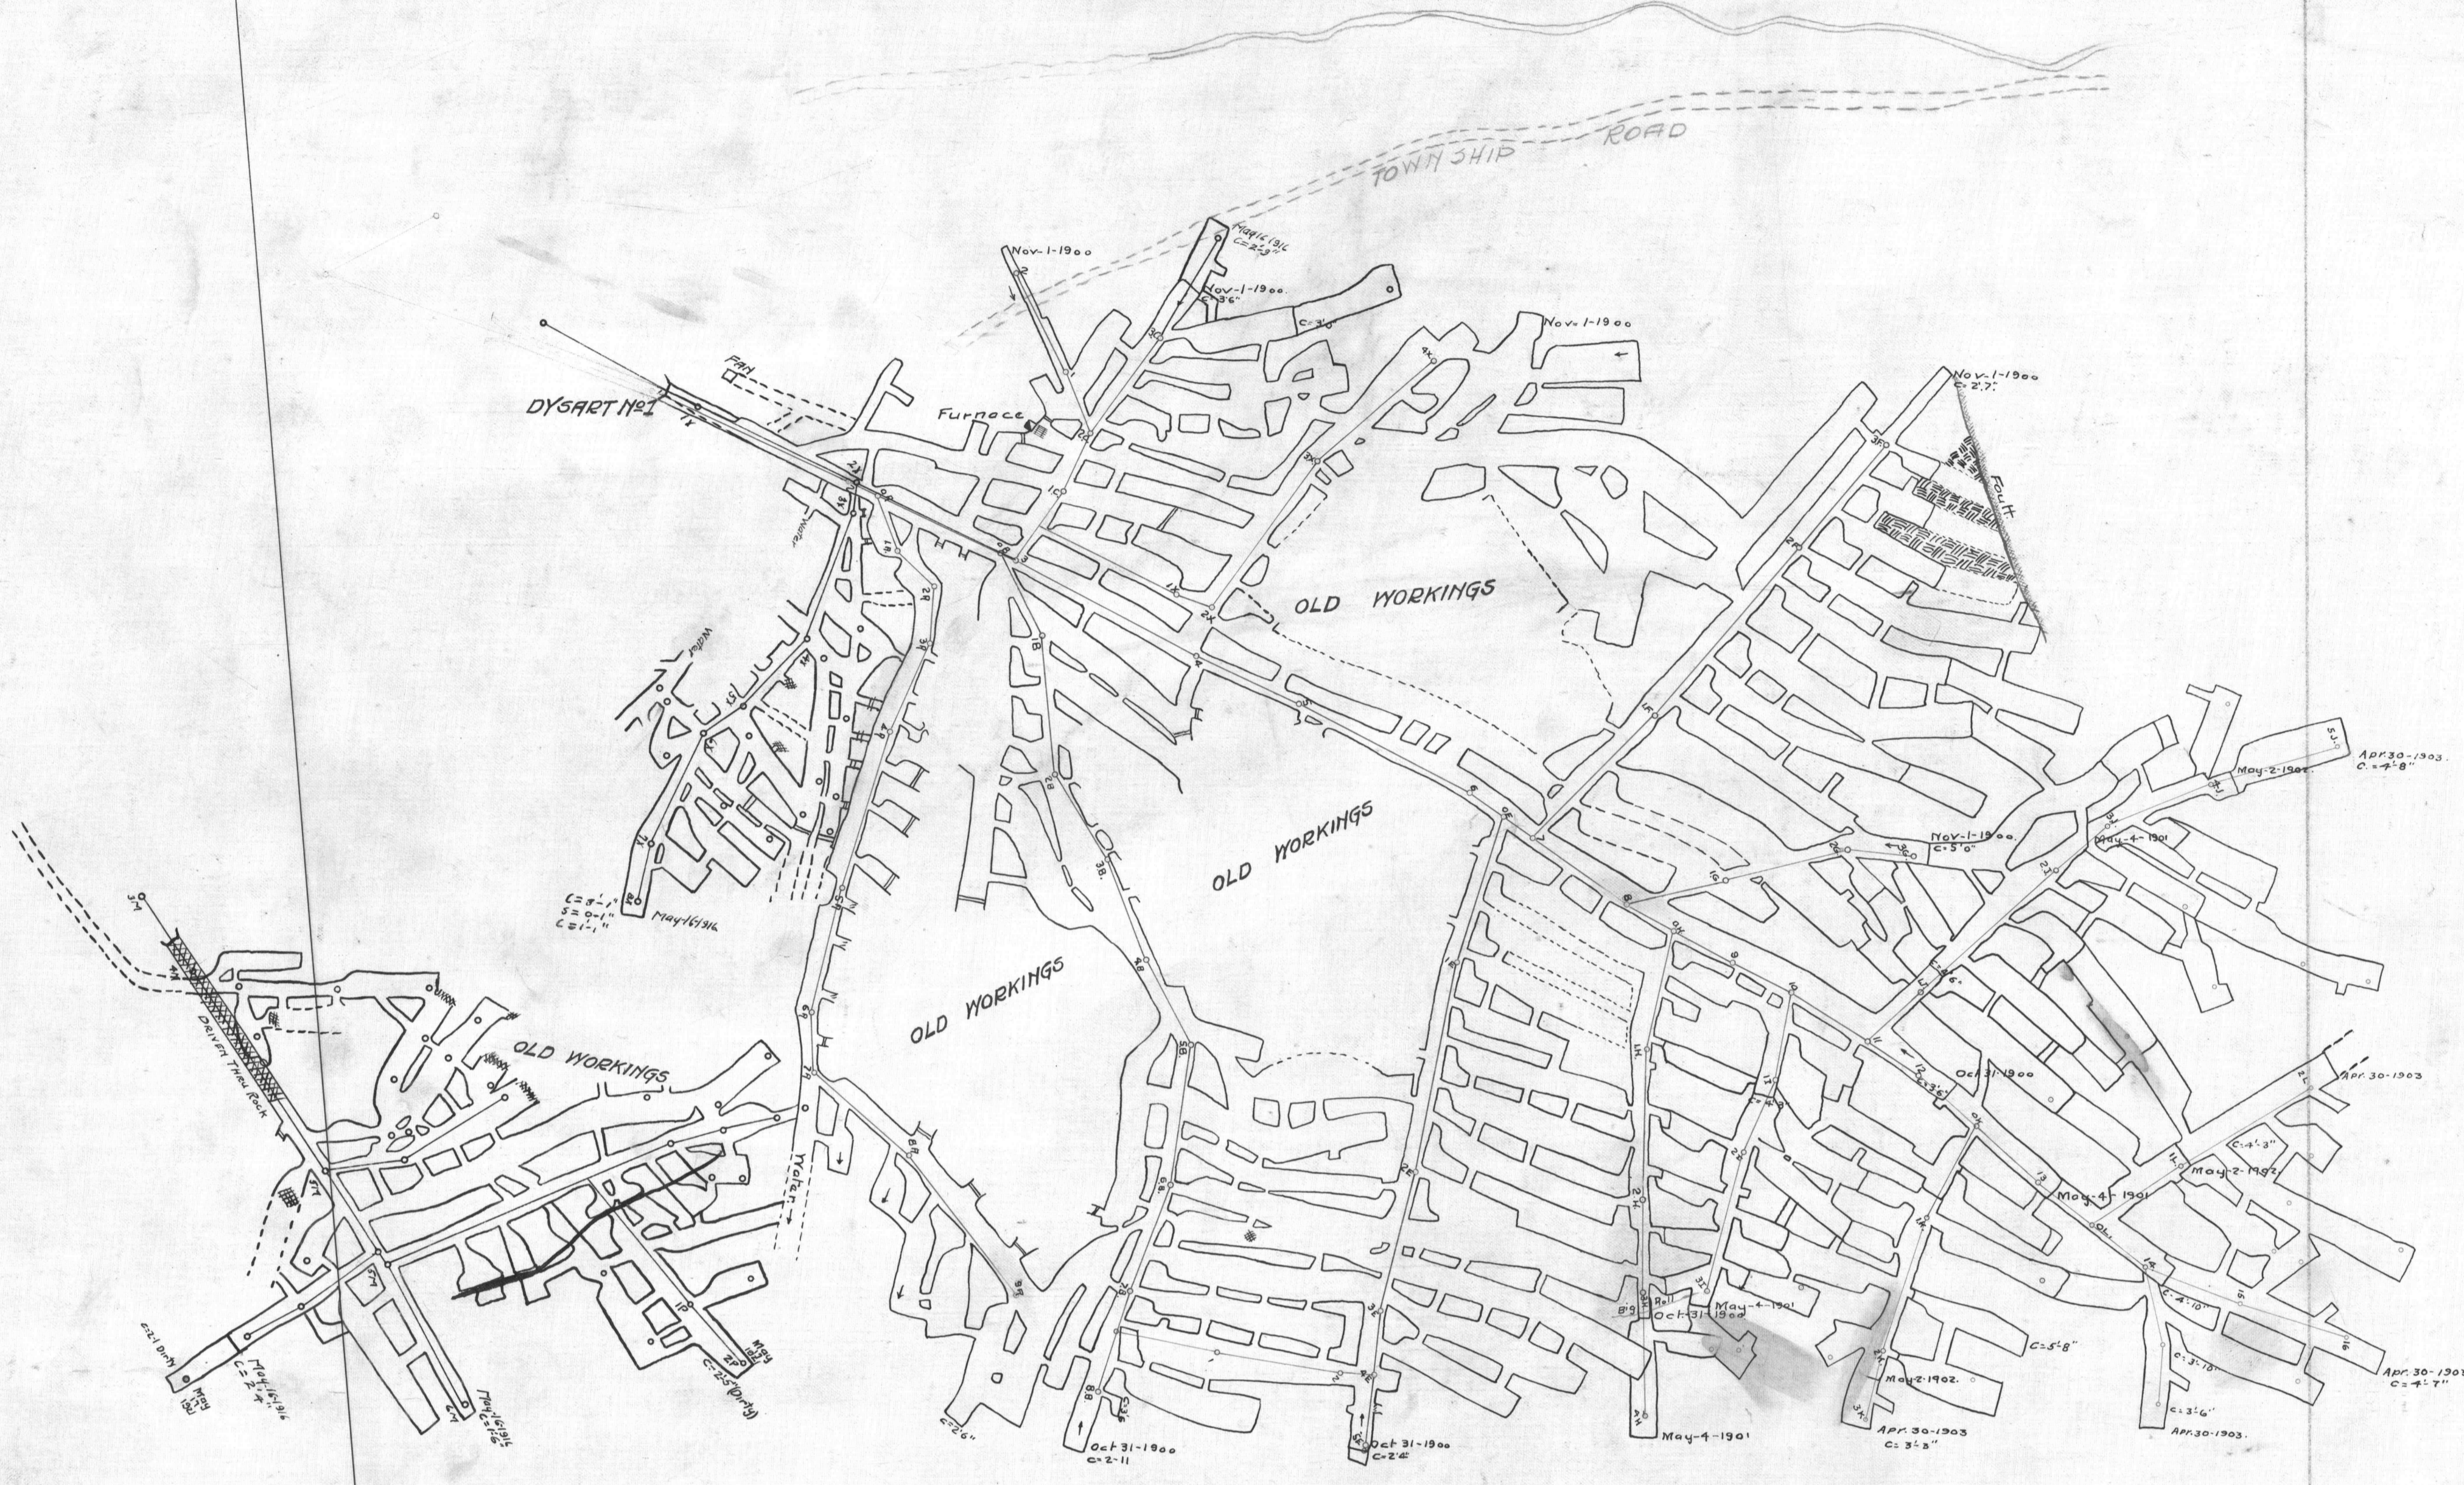

MORRISON & STEVENS  
85 AS. 66 PS.  
D. W. YINGLING

MORRISON & STEVENS  
47 AS. 124 PS.  
D. W. YINGLING

NOTE :- IN NOVEMBER 1915 THIS MINE WAS LEASED BY THE SUGAR RUN COAL MINING CO. FROM MORRISON & STEVENS,  
AND ALL ACCESSIBLE WORKINGS WERE SURVEYED BY US IN MAY 1916, AND ADDED TO THIS MAP.

J.S. SILLIMAN & CO.  
ENGINEERS.

Map of  
**RICHLAND COLLIERY**  
OPERATED BY THE  
**CRESSON & CLEARFIELD COAL & COKE CO.**

LOCATED AT  
Dysart, Cambria County, Pa.

Scale: 1" = 100'

Jos. S. Silliman & Co.  
Engineers

NOTE :- THIS IS THE MINE ON THE LOWER SEAM AND IS KNOWN AS DYSART NO. 1