

167

**MAP SHOWING MINING OPERATIONS**  
**IN THE 'E' SEAM**  
 OF  
**W. H. PIPER & CO.**

WASHINGTON TWP, CAMBRIA COUNTY, PENNA.  
 SCALE: 1" = 100'



Jos. S. SILLIMAN & CO.  
 ENGINEERS  
 PITTSBURGH, PENNA.

C1E7-1

SURVEY REVISED TO

I, Richard L. Westley, Registered  
 Engineer, Do hereby Certify That  
 This is Correct Copy of Mine  
 Workings

*R. L. Westley*  
 Reg. Engineer

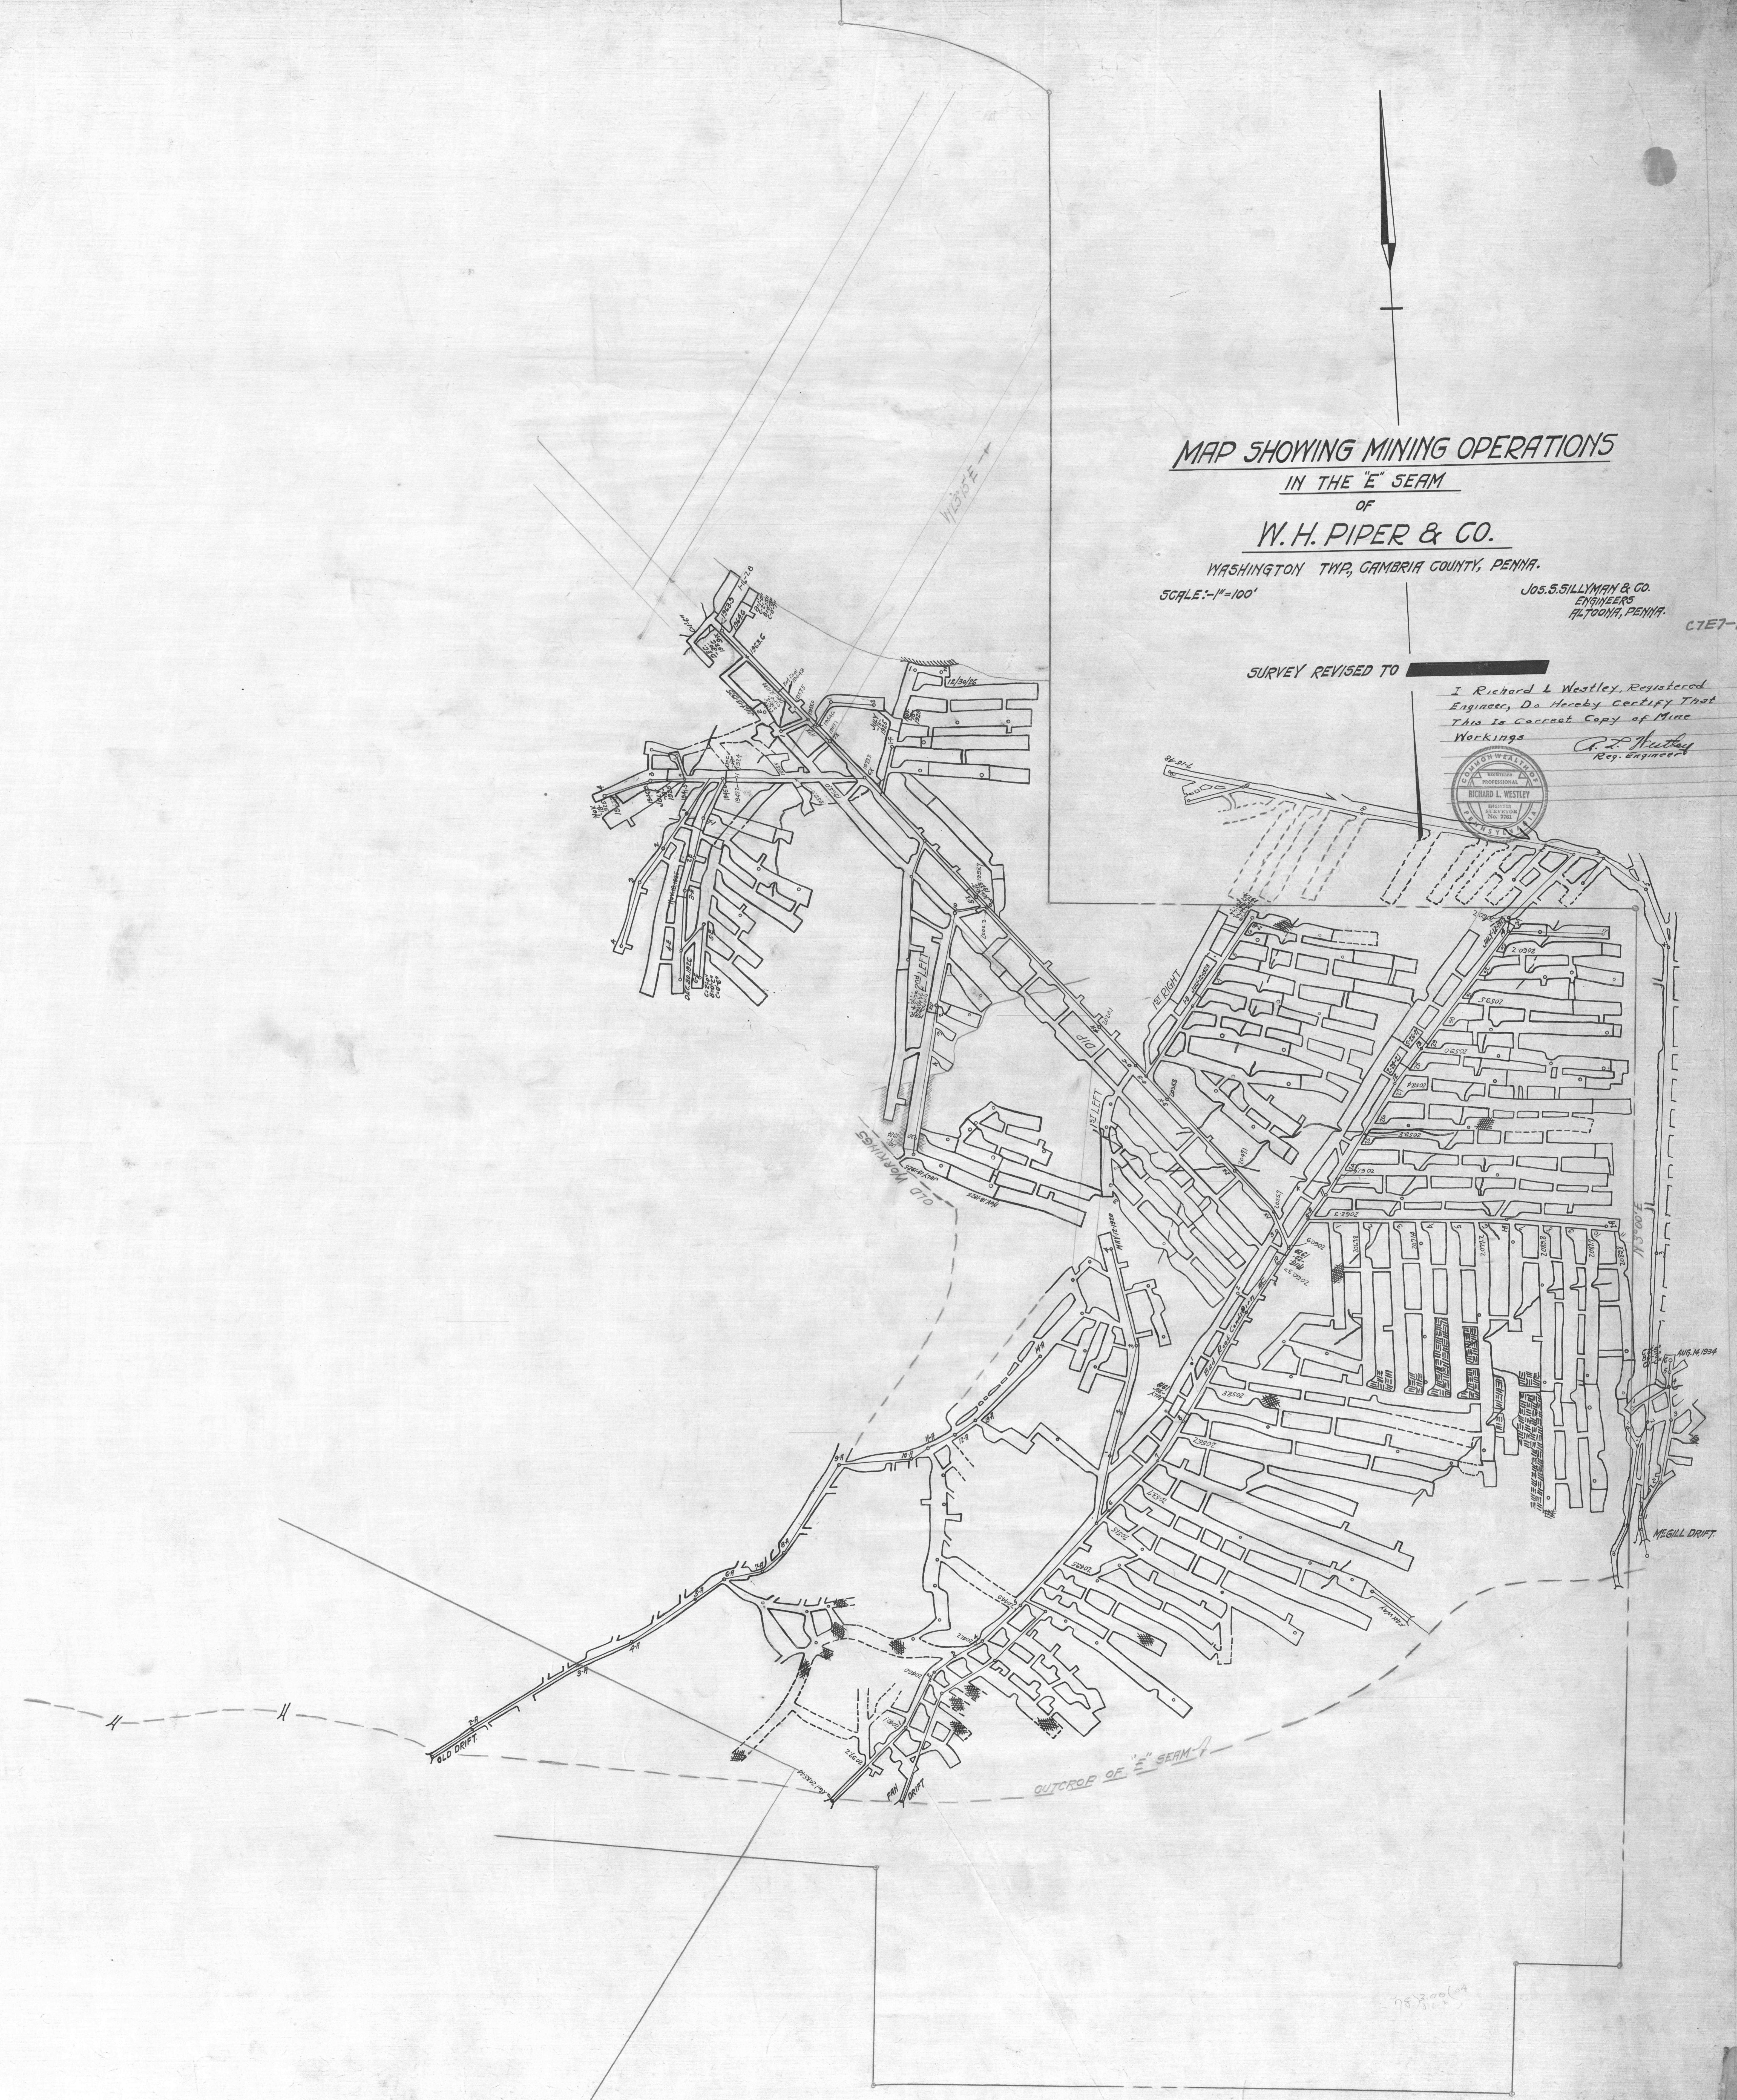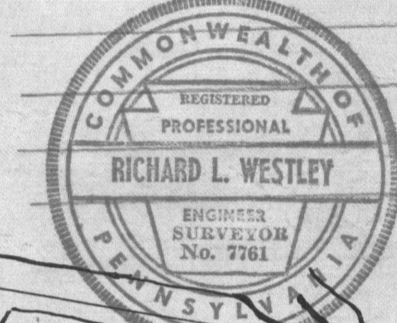

PREMIUM  
GREY

I-8 121