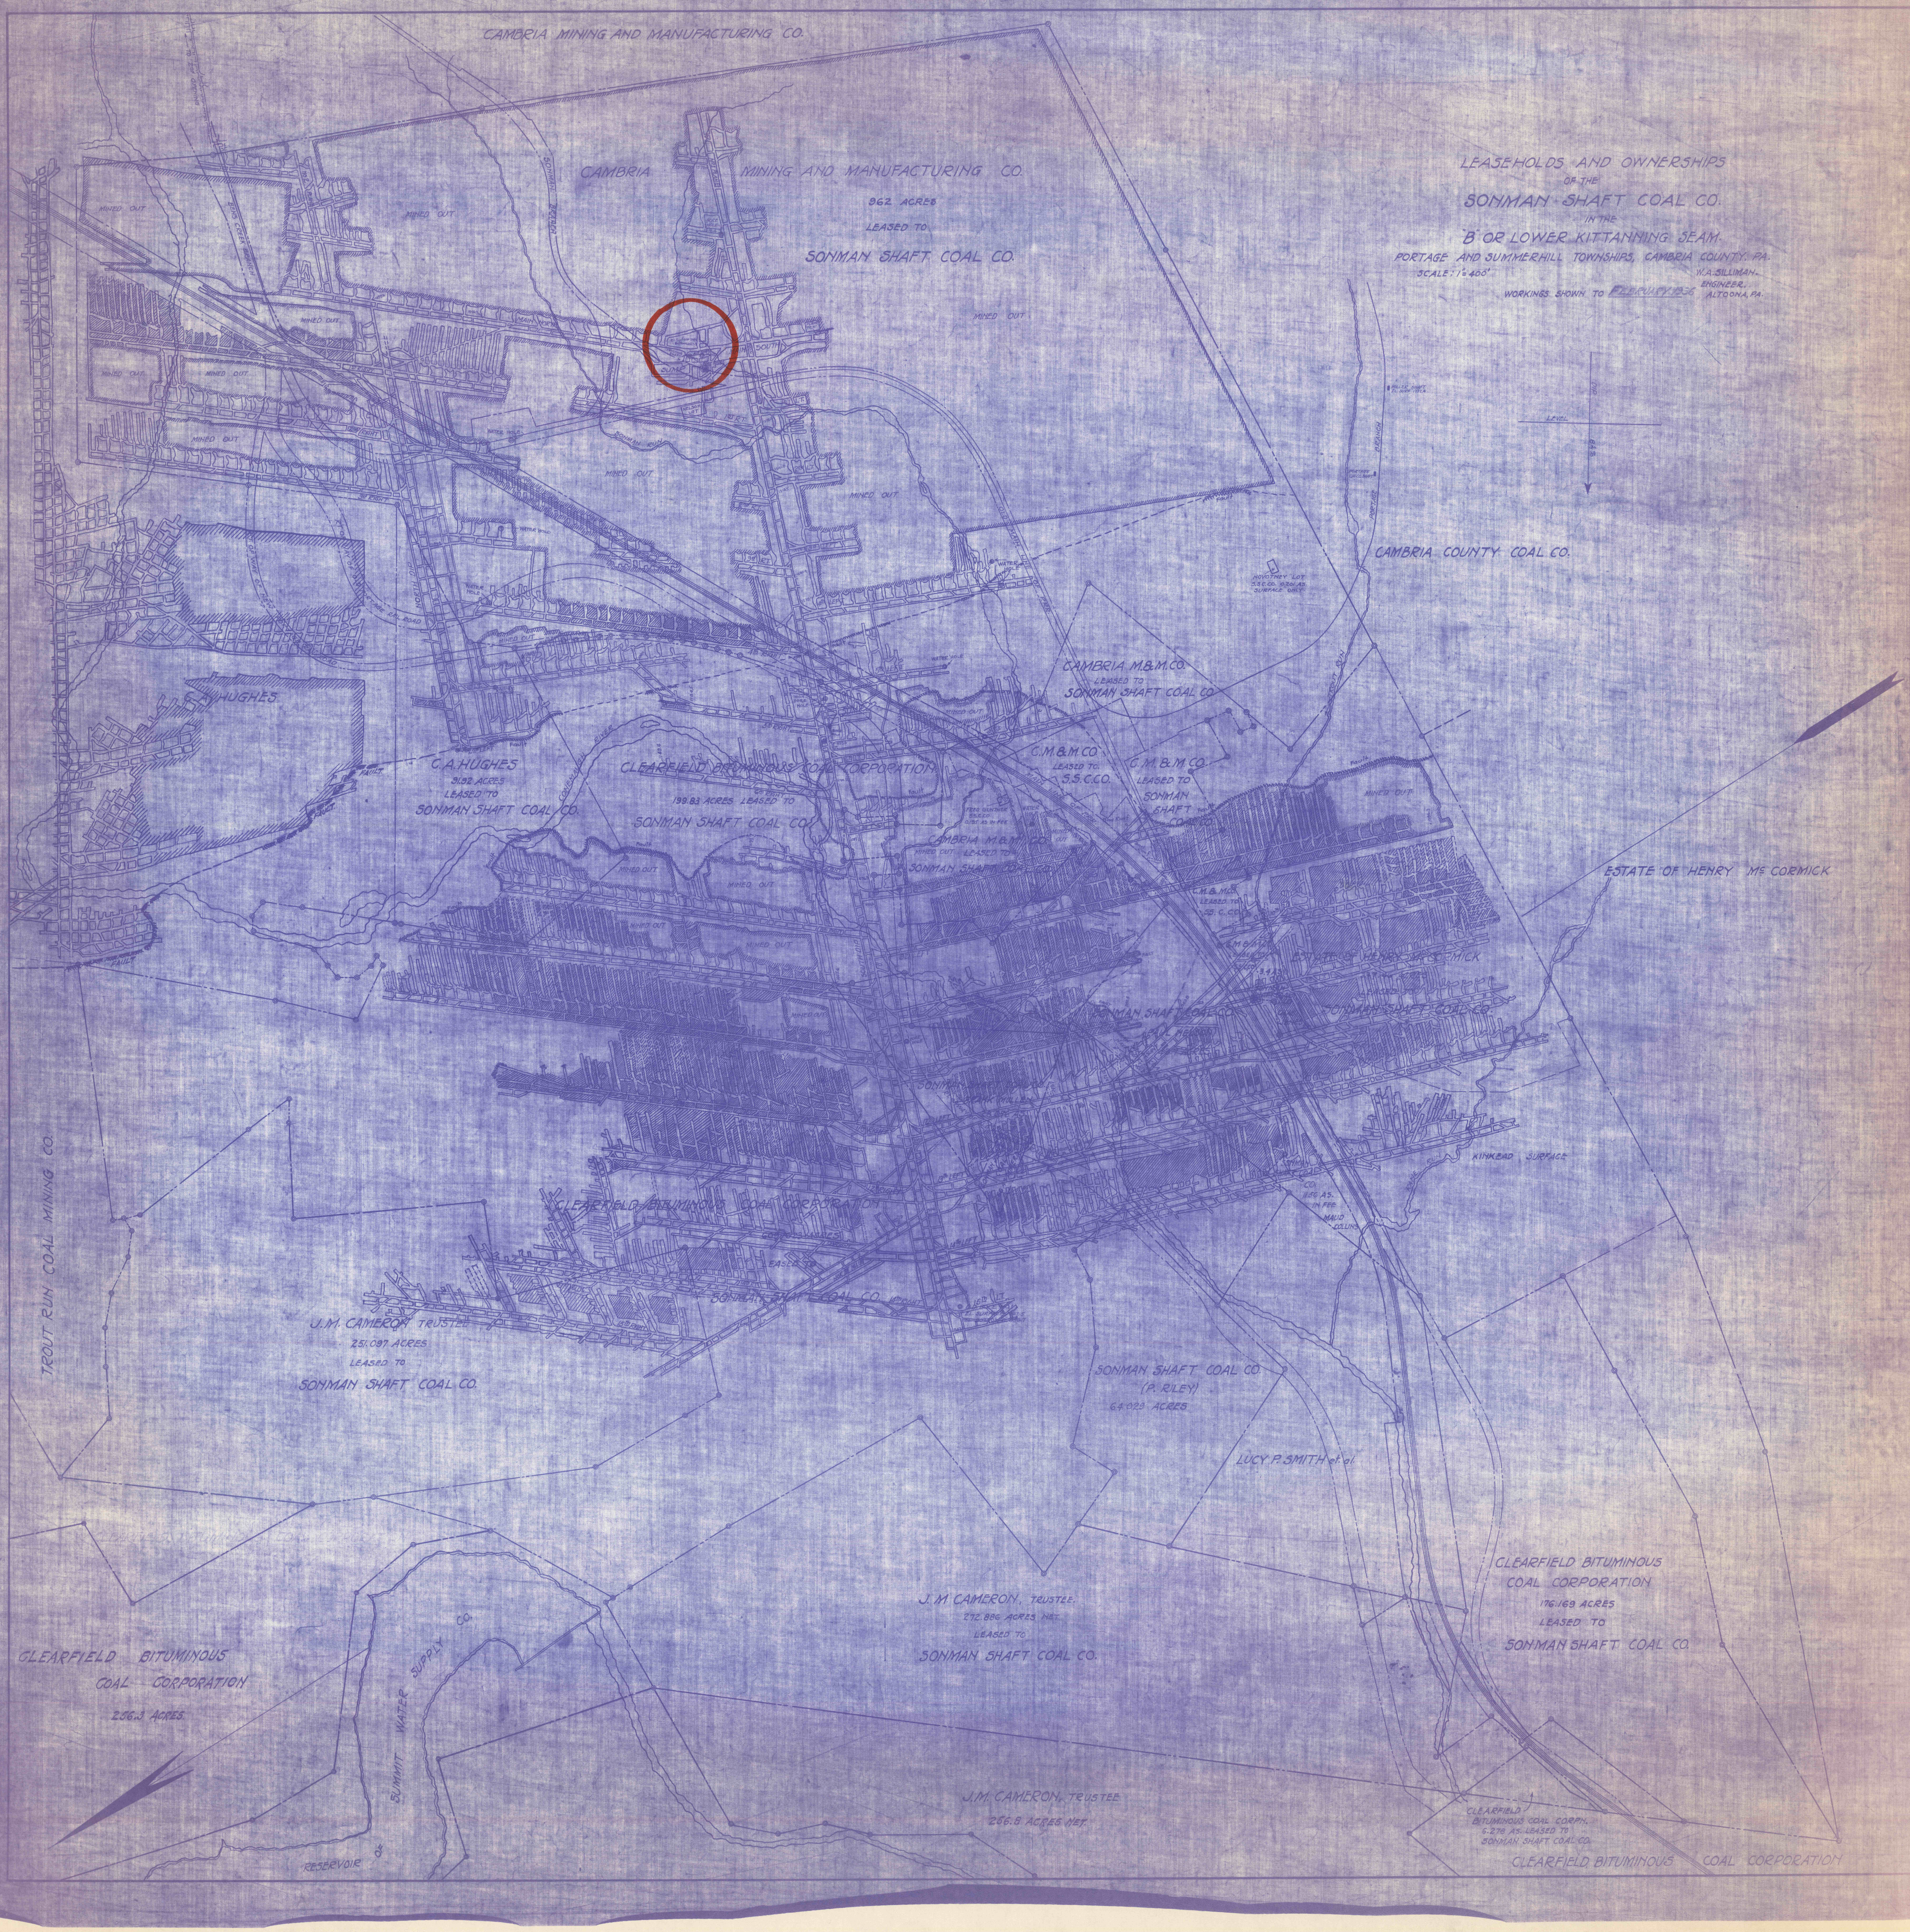

LEASEHOLDS AND OWNERSHIPS
OF THE
SONMAN SHAFT COAL CO.
IN THE
"B" OR LOWER KITTANNING SEAM.
PORTAGE AND SUMMERHILL TOWNSHIPS, CAMBRIA COUNTY, PA.

SCALE: 1" = 400'

W.A. SILLIMAN.
ENGINEER.
ALTOONA, PA.

WORKINGS SHOWN TO FEBRUARY 1936

CAMBRIA MINING AND MANUFACTURING CO.
CAMBRIA MINING AND MANUFACTURING CO.
962 ACRES
LEASED TO
SONMAN SHAFT COAL CO.
TO 2ND OPENING
BENS CREEK BRANCH
SONMAN BRANCH
MINED OUT
MAIN NORTH
SOUTH
SUMP
NELSON LOT
1ST RT.
2ND RIGHT
3RD RIGHT
WATER HOLE
SONMAN RUN
NORTH DIP
PORTAGE RAIL ROAD
3RD RT.
4TH LEFT
4TH RIGHT
5TH RIGHT
5TH LEFT
INSIDE BORE HOLE
OLD MAIN LINE OF P.R.R.
FAULT
NOVOTNEY LOT
S.S.C.CO. 0.201 AS.
SURFACE ONLY
MILLER SHAFT
PORTAGE CH.CO. SHAFT
PORTAGE BRANCH
TROUT RUN
LEVEL
DIP
CAMBRIA COUNTY COAL CO.
CAMBRIA M.&M.CO.
LEASED TO
SONMAN SHAFT COAL CO.
C.A.HUGHES
C.A.HUGHES
91.92 ACRES
LEASED TO
SONMAN SHAFT COAL CO.
CONEMAUGH RIVER
CLEARFIELD BITUMINOUS COAL CORPORATION
199.83 ACRES LEASED TO
SONMAN SHAFT COAL CO.
FRED GUNTHER
S.S.C.CO.
0.195 AS. IN FEE
C.M.&M.CO.
LEASED TO
S.S.C.CO.
C.M.&M.CO.
LEASED TO
SONMAN
SHAFT
COAL CO.
CAMBRIA M.&M.CO.
LEASED TO
SONMAN SHAFT COAL CO.
C.M.&M.CO.
LEASED TO
S.S.C.CO.
ESTATE OF HENRY MC CORMICK
ESTATE OF HENRY MC CORMICK
LEASED TO
SONMAN SHAFT COAL CO.
SONMAN SHAFT COAL CO.
PAUL HENRY
SONMAN SHAFT COAL CO.
FRANK PHILLEN
SOUTH DIP
6TH RIGHT
12TH RIGHT
13TH LEFT
14TH LEFT
14TH RIGHT
15TH RIGHT
15TH LT.
KINKEAD SURFACE
SONMAN SHAFT COAL CO.
11.56 AS.
IN FEE
MAUD COLLINS
CLEARFIELD BITUMINOUS COAL CORPORATION
LEASED TO
SONMAN SHAFT COAL CO.
TROUT RUN COAL MINING CO.
J.M. CAMERON TRUSTEE
251.097 ACRES
LEASED TO
SONMAN SHAFT COAL CO.
SONMAN SHAFT COAL CO.
(P. RILEY)
64.029 ACRES
LUCY P. SMITH et. al.
J.M. CAMERON, TRUSTEE.
272.886 ACRES NET
LEASED TO
SONMAN SHAFT COAL CO.
CLEARFIELD BITUMINOUS
COAL CORPORATION
176.169 ACRES
LEASED TO
SONMAN SHAFT COAL CO.
CLEARFIELD BITUMINOUS
COAL CORPORATION
256.3 ACRES.
SUMMIT WATER SUPPLY CO.
RESERVOIR OF
J.M. CAMERON, TRUSTEE
256.8 ACRES NET
CLEARFIELD
BITUMINOUS COAL CORPN.
6.278 AS. LEASED TO
SONMAN SHAFT COAL CO.
CLEARFIELD BITUMINOUS COAL CORPORATION