


LEASEHOLDS OF THE SONMAN SHAFT COAL CO.

IN THE 'C' PRIME AND 'D' SEAMS
SHOWING WORKINGS IN ADJOINING TERRITORY

SCALE - 1" = 400'

J.S. SULLIVAN & CO.
ENGINEERS

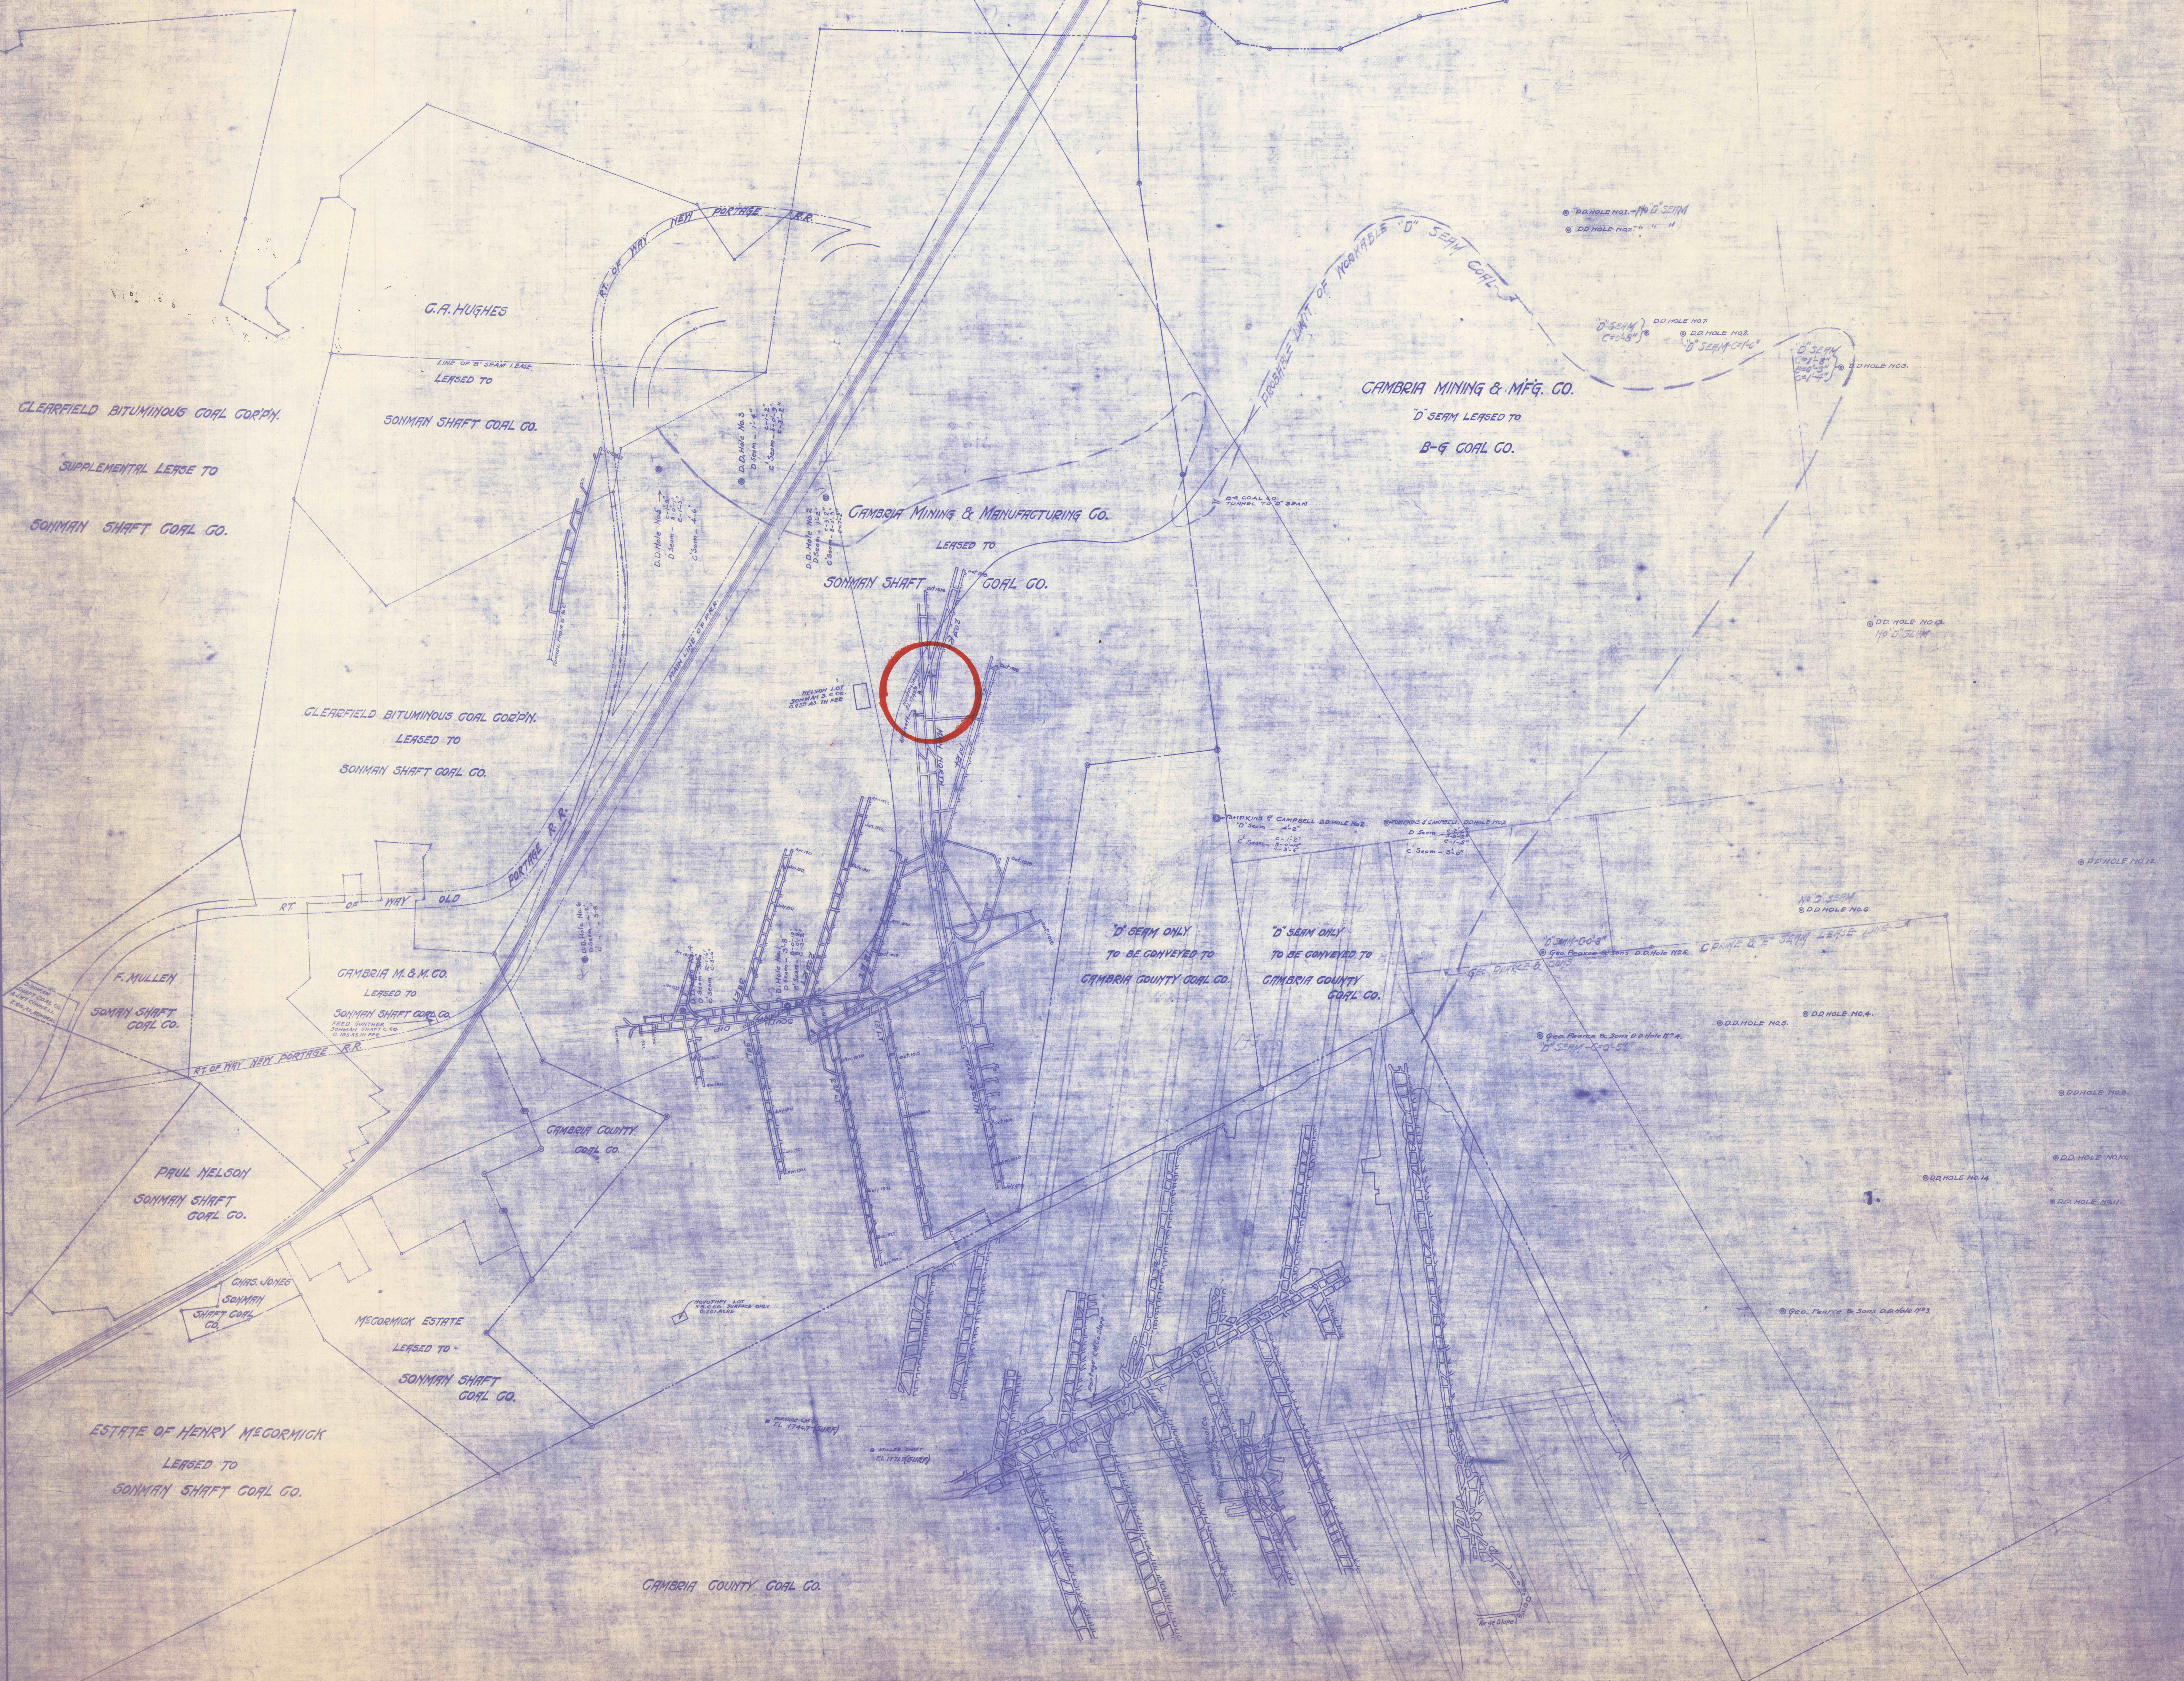

162

162