


C-A-12

C-A-12

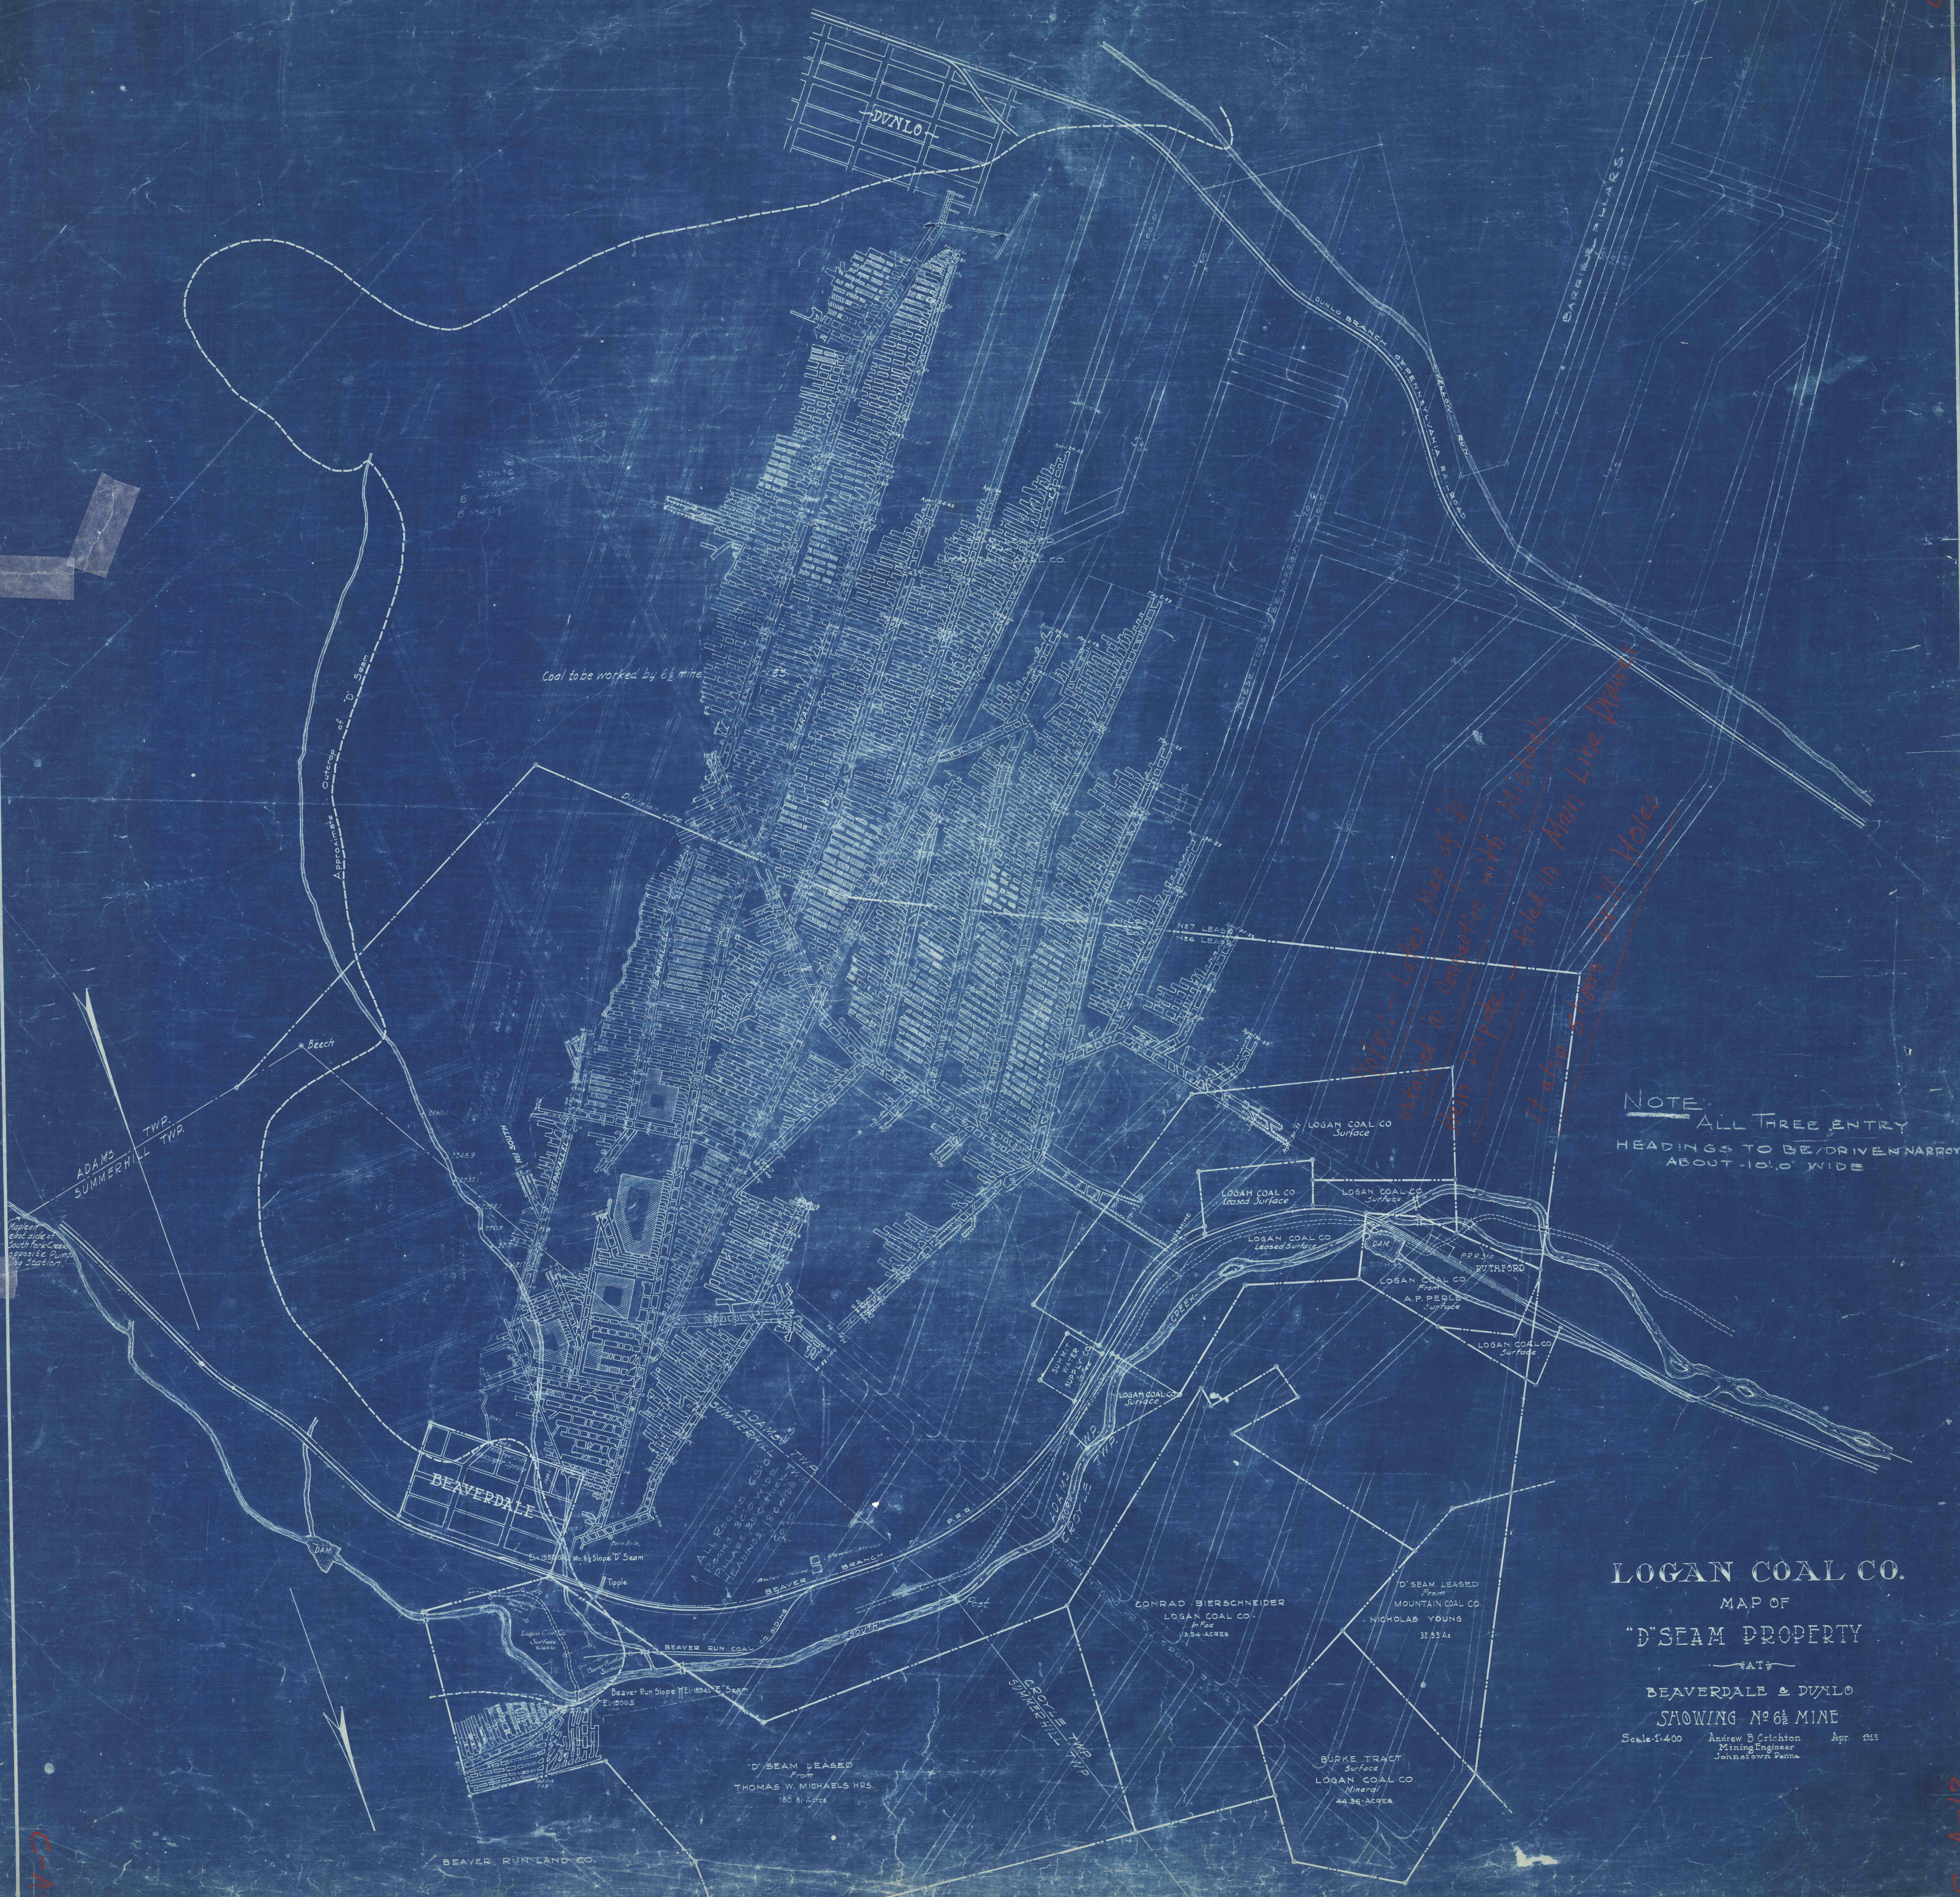

NOTE: ALL THREE ENTRY HEADINGS TO BE DRIVEN NARROW ABOUT 10.0' WIDE

LOGAN COAL CO.
MAP OF
"D" SEAM PROPERTY

BEAVERDALE & DUNLO
SHOWING No 6 1/2 MINE

Scale: 1:400 Andrew D Critchton Mining Engineer Apr. 1915
Johnstown Penna.

C-A-12

C-A-12