

C-A-12


C-A-12

To be released by  
LOGAN COAL CO

# LOGAN COAL COMPANY MAP OF N° 2 WAGNER MINE

Scale: 1 inch = 400 feet. January 1912.

ANDREW B. CRICHTON, ENG.  
JOHNSTOWN PA.

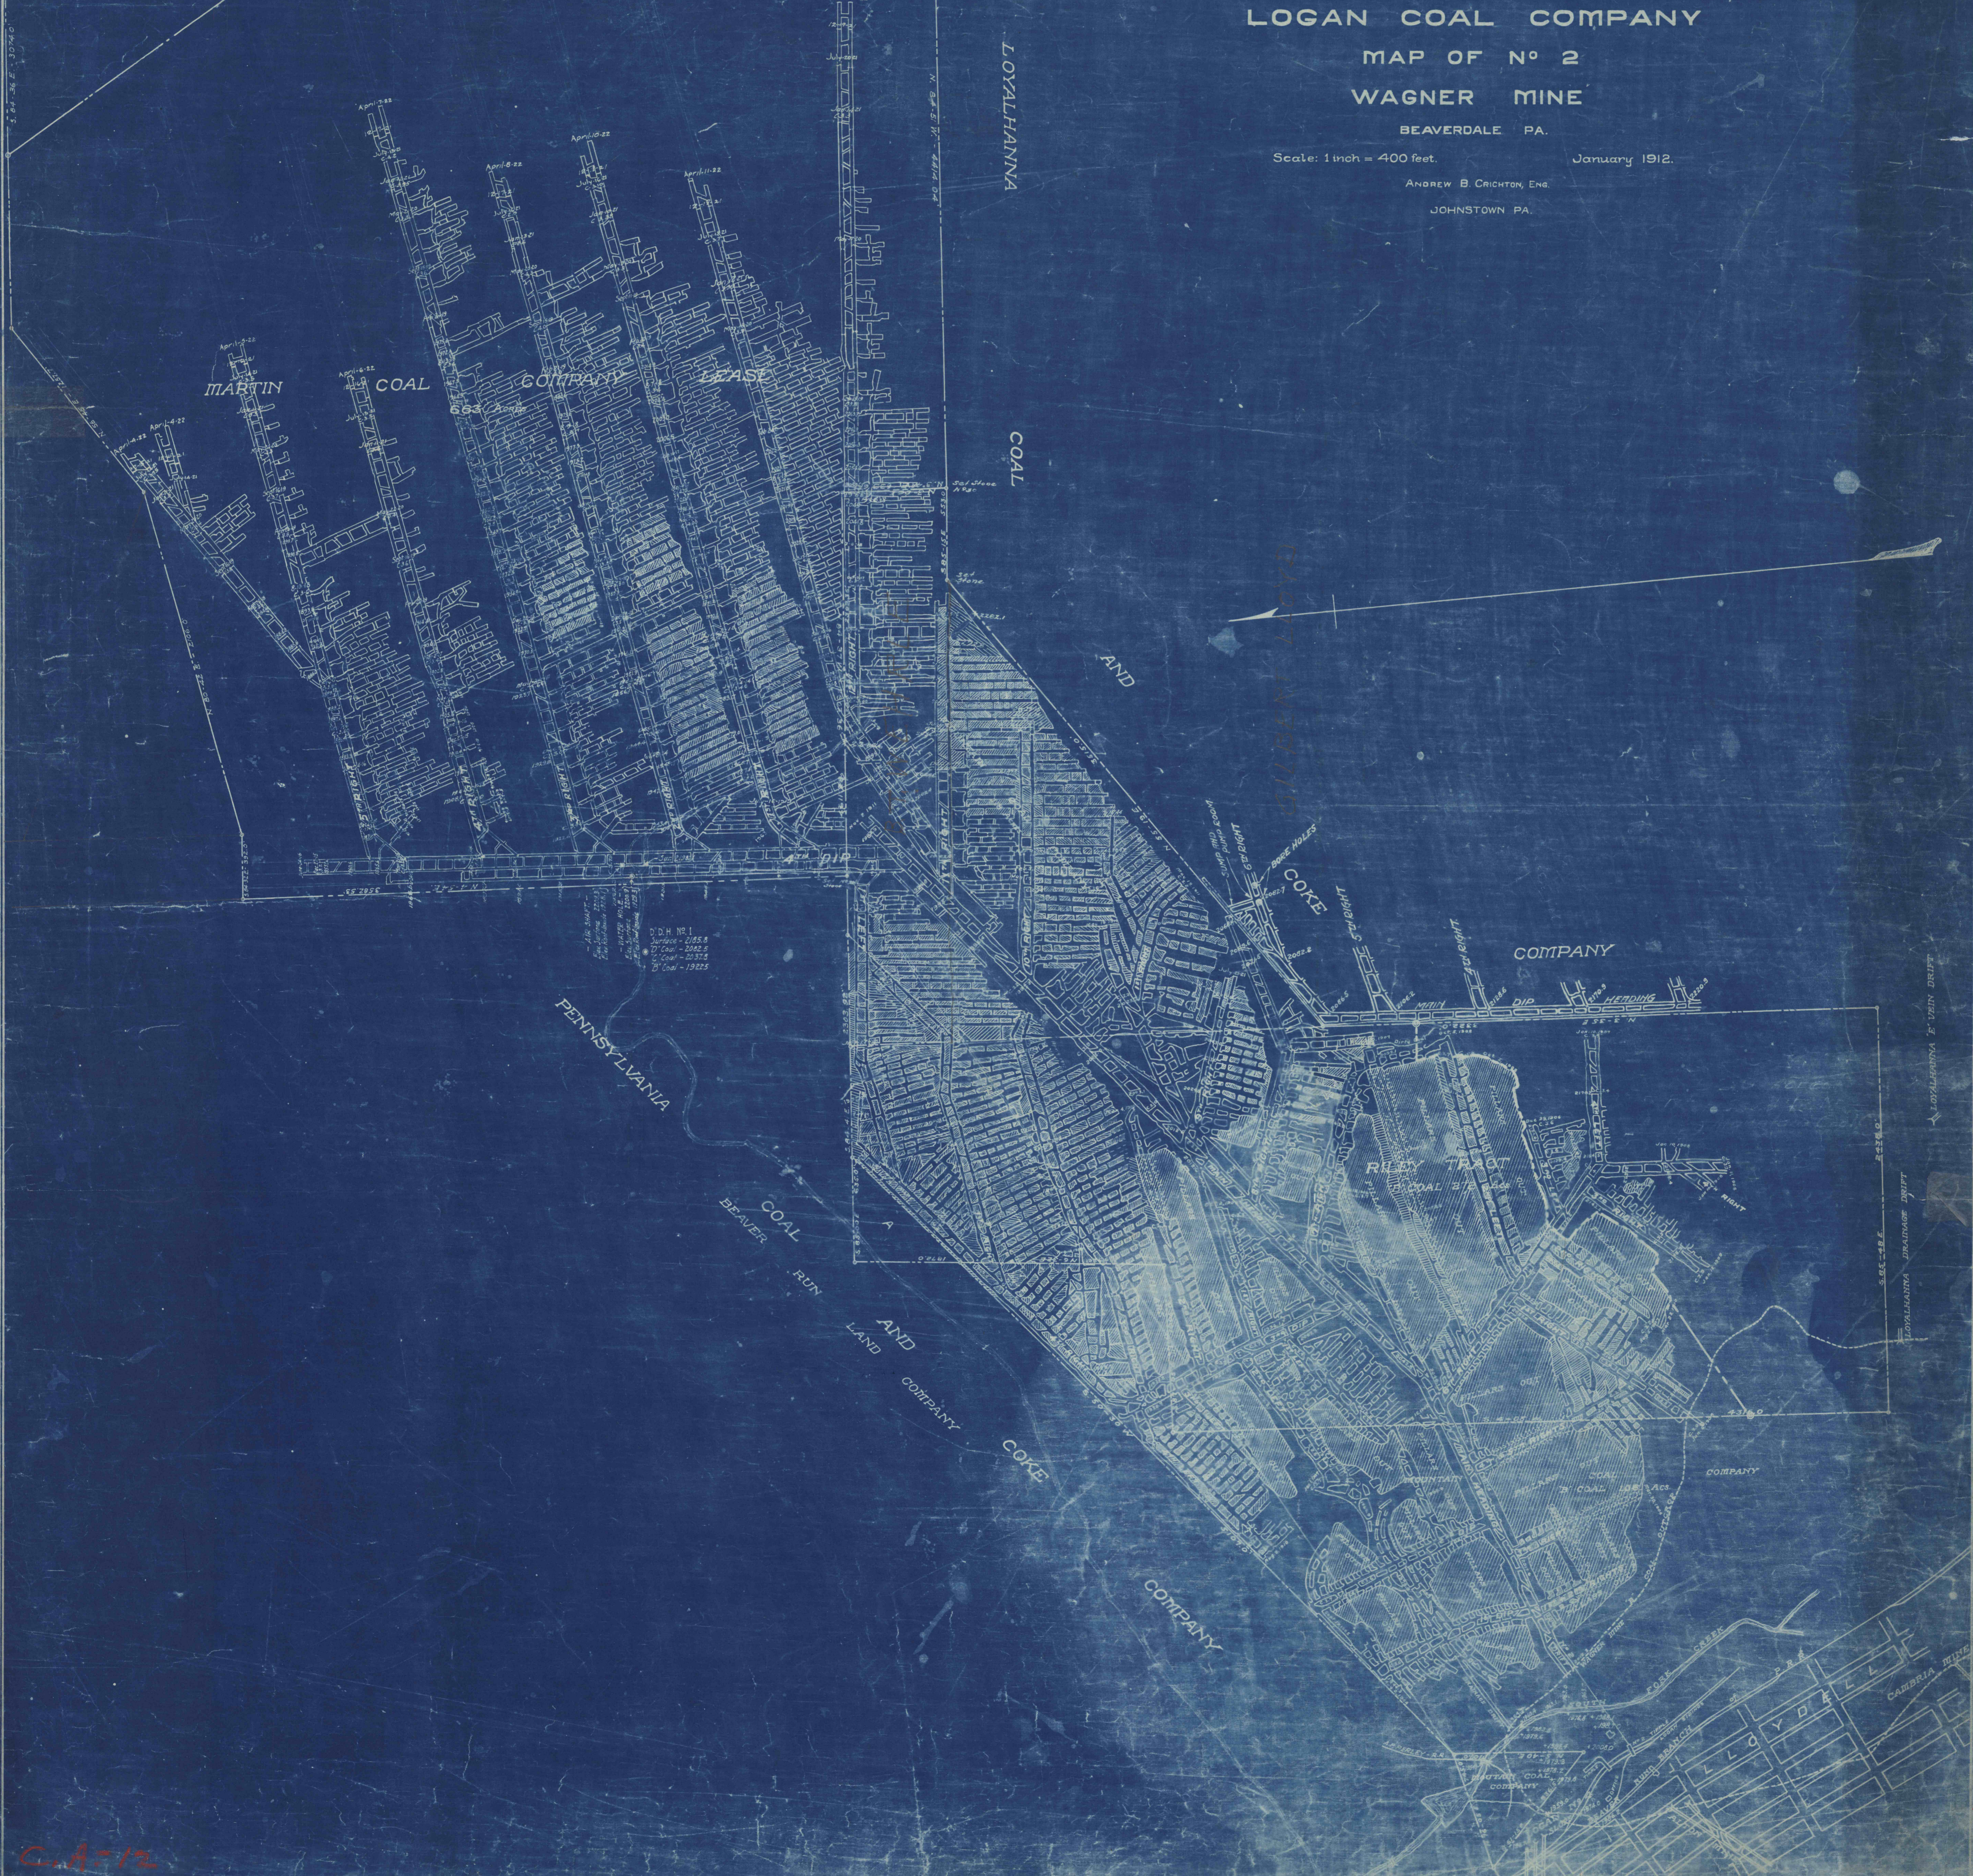

C.A-12

C.A-12