

MAP OF
DRIFT ON E SEAM


OPERATED BY G. J. MAZENKO.

FLINTON, CAMBRIA Co., PA.

ALTOONA PA.

Geo. S. Pillsbury & Co.

SCALE: 1 IN. = 100 FT.

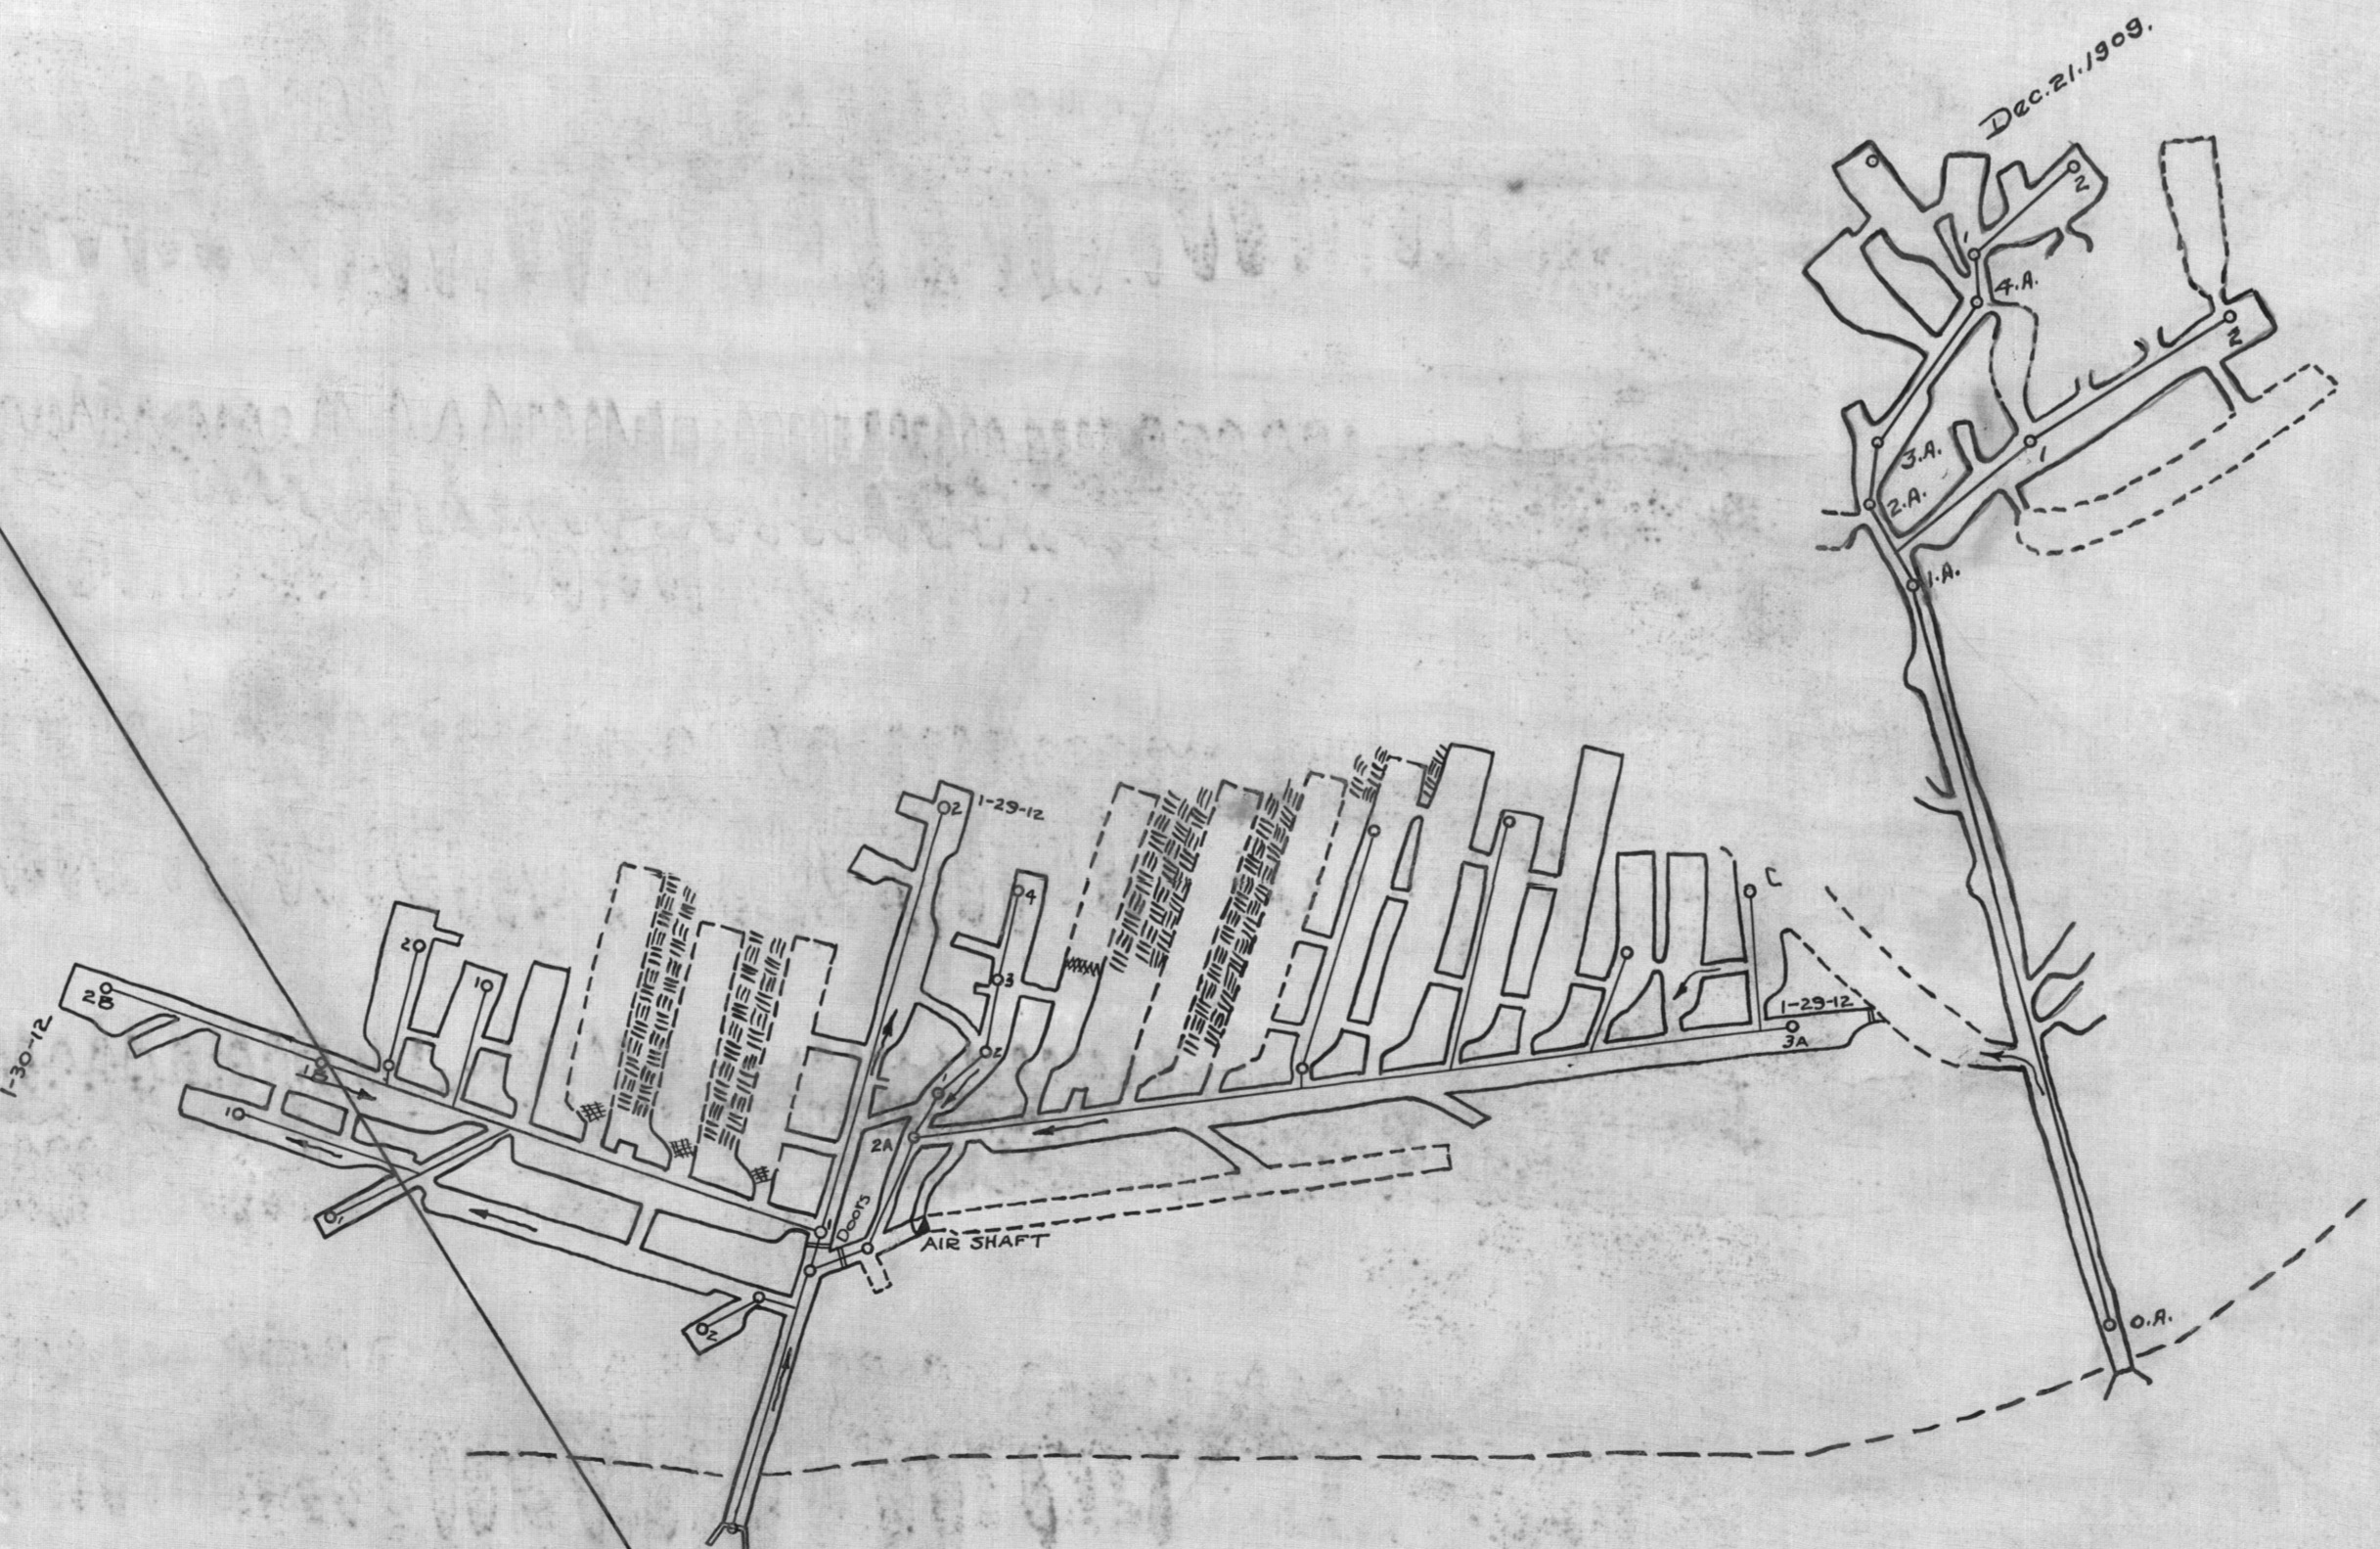

67F17-1