


TOTAL AREA NOT MINED OVER = 206 ⁸/₁₀ A.S.

CRISTE	"	"	"	51 ⁴ / ₁₀ "
C. A. HUGHES	"	"	"	39 ⁶ / ₁₀ "
DUNN	"	"	"	97 ³ / ₁₀ "
BRADLEY	"	"	"	18 ⁵ / ₁₀ "

W. H. PIPER & CO.

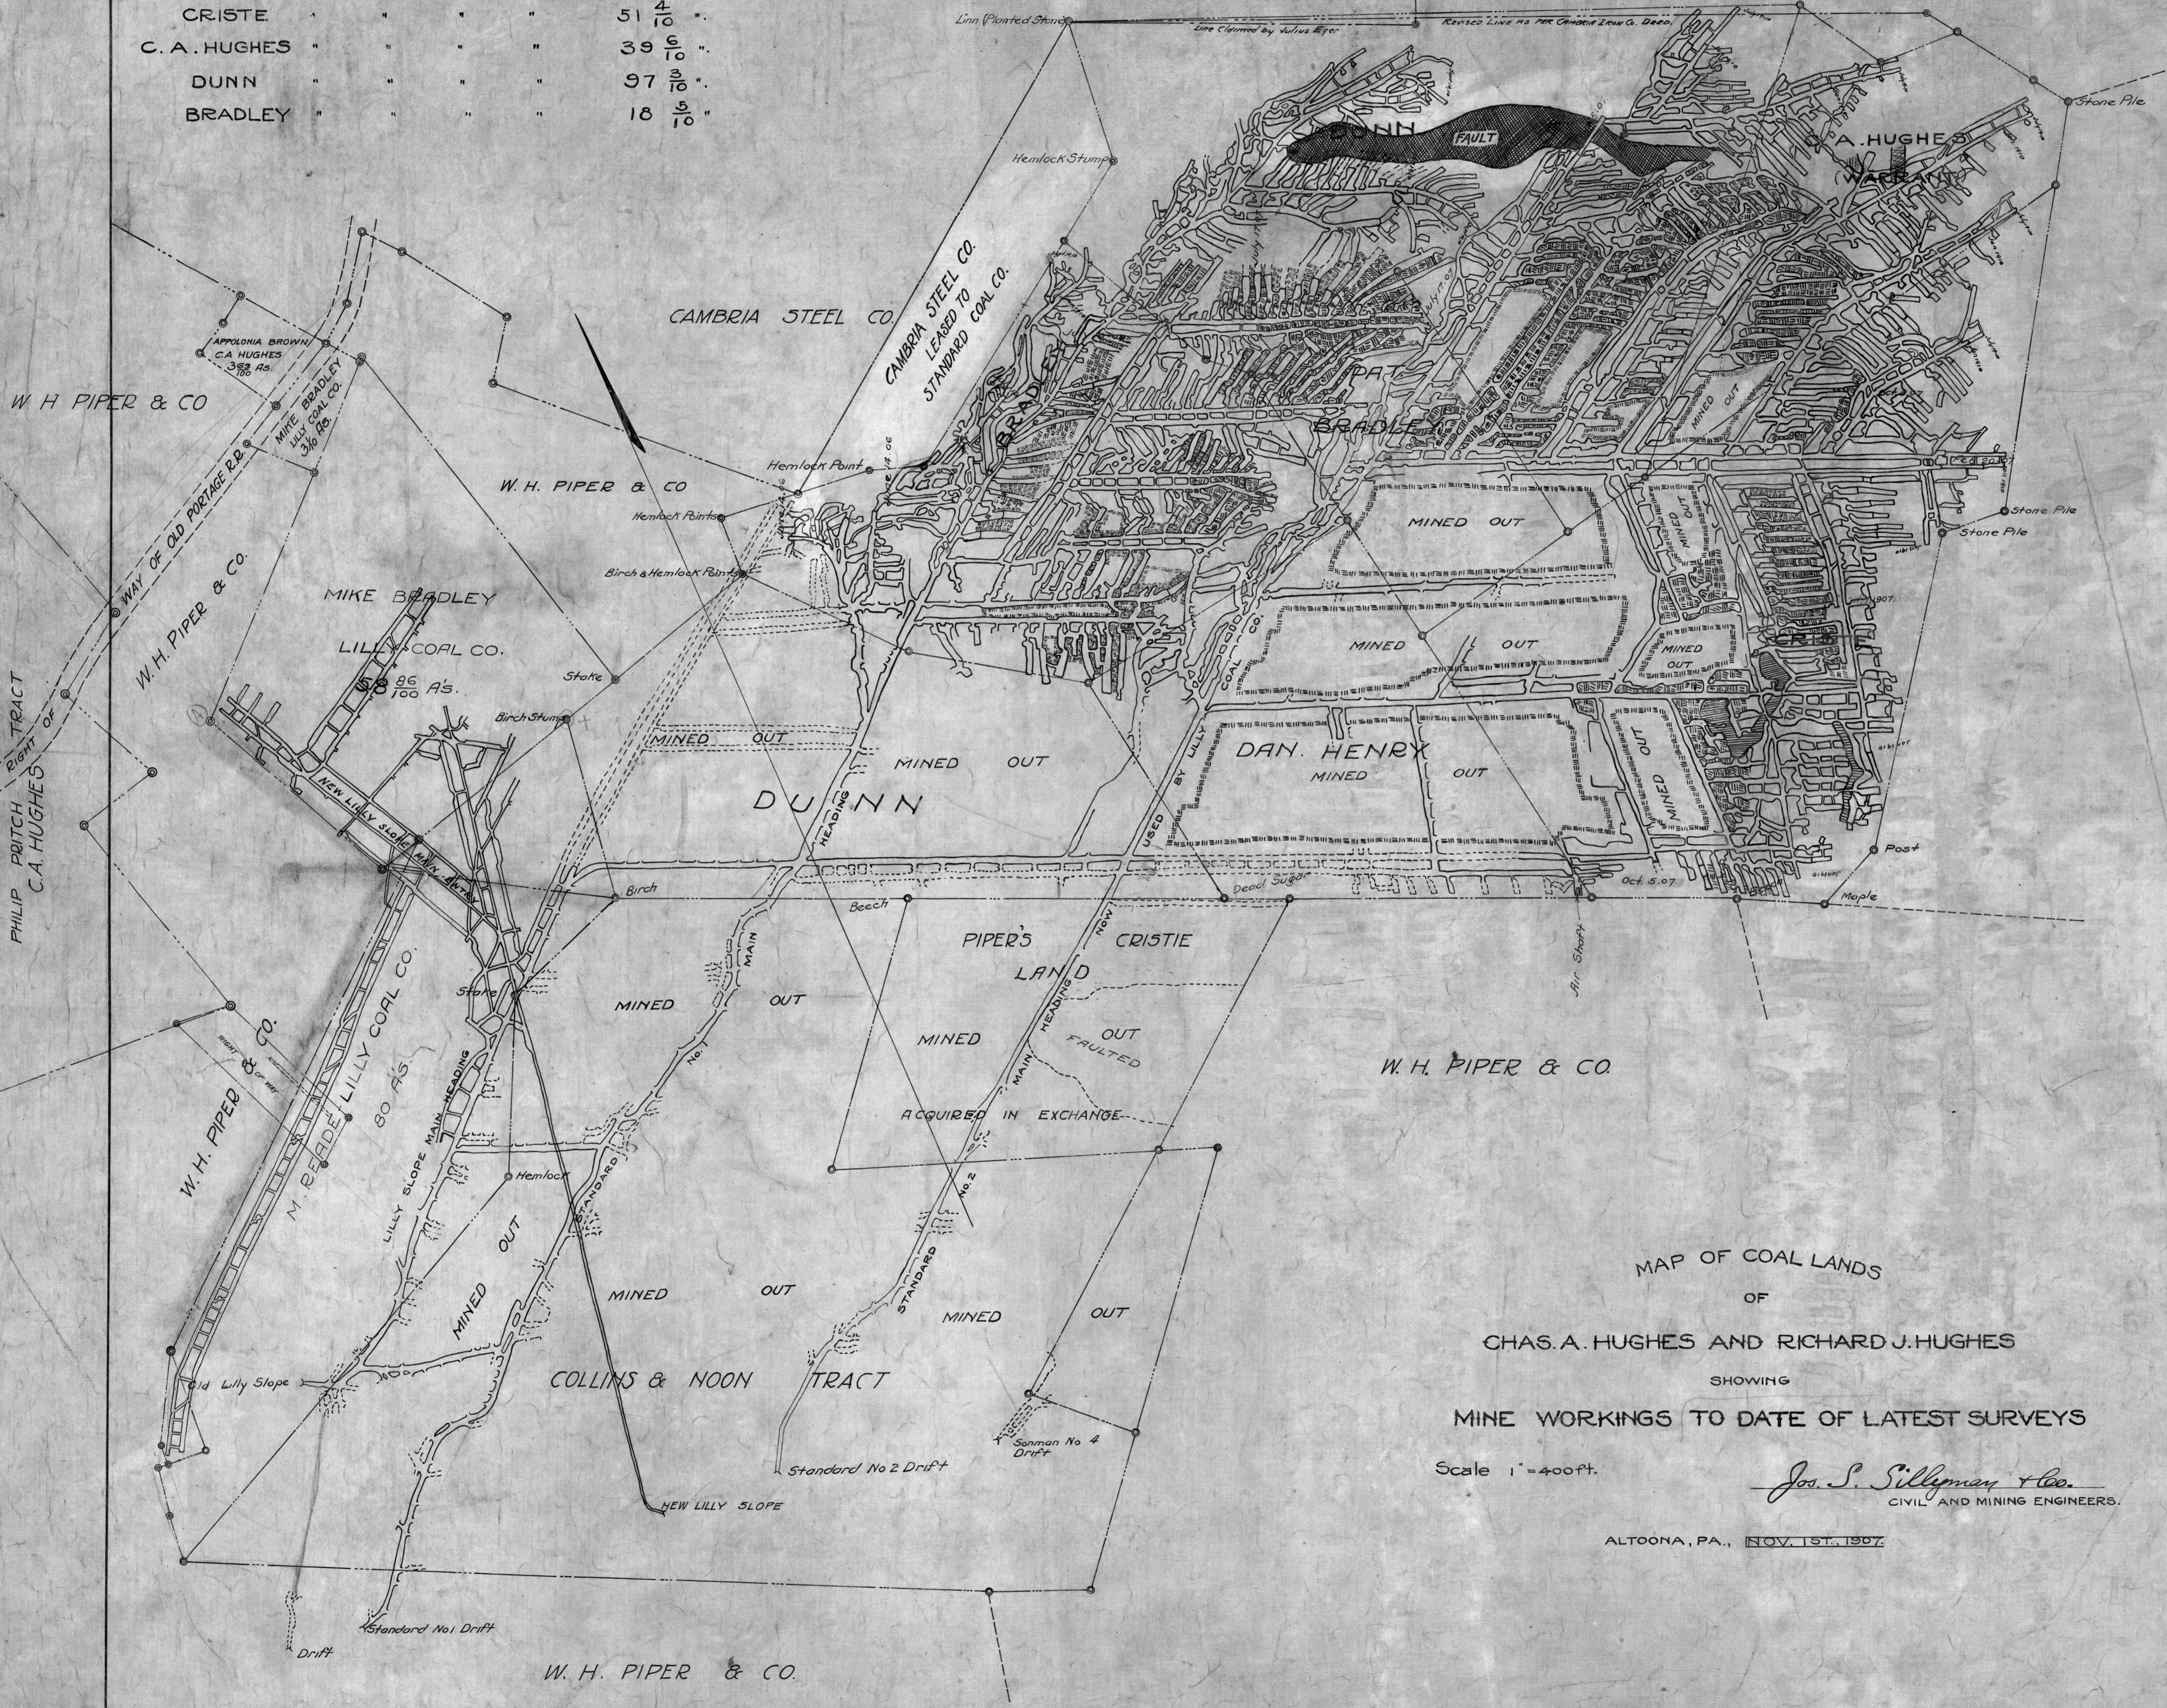

MAP OF COAL LANDS
OF
CHAS. A. HUGHES AND RICHARD J. HUGHES
SHOWING
MINE WORKINGS TO DATE OF LATEST SURVEYS

Scale 1"=400ft.

Jos. S. Sillyman & Co.
CIVIL AND MINING ENGINEERS.

ALTOONA, PA., NOV. 1ST, 1907.

W. H. PIPER & CO.