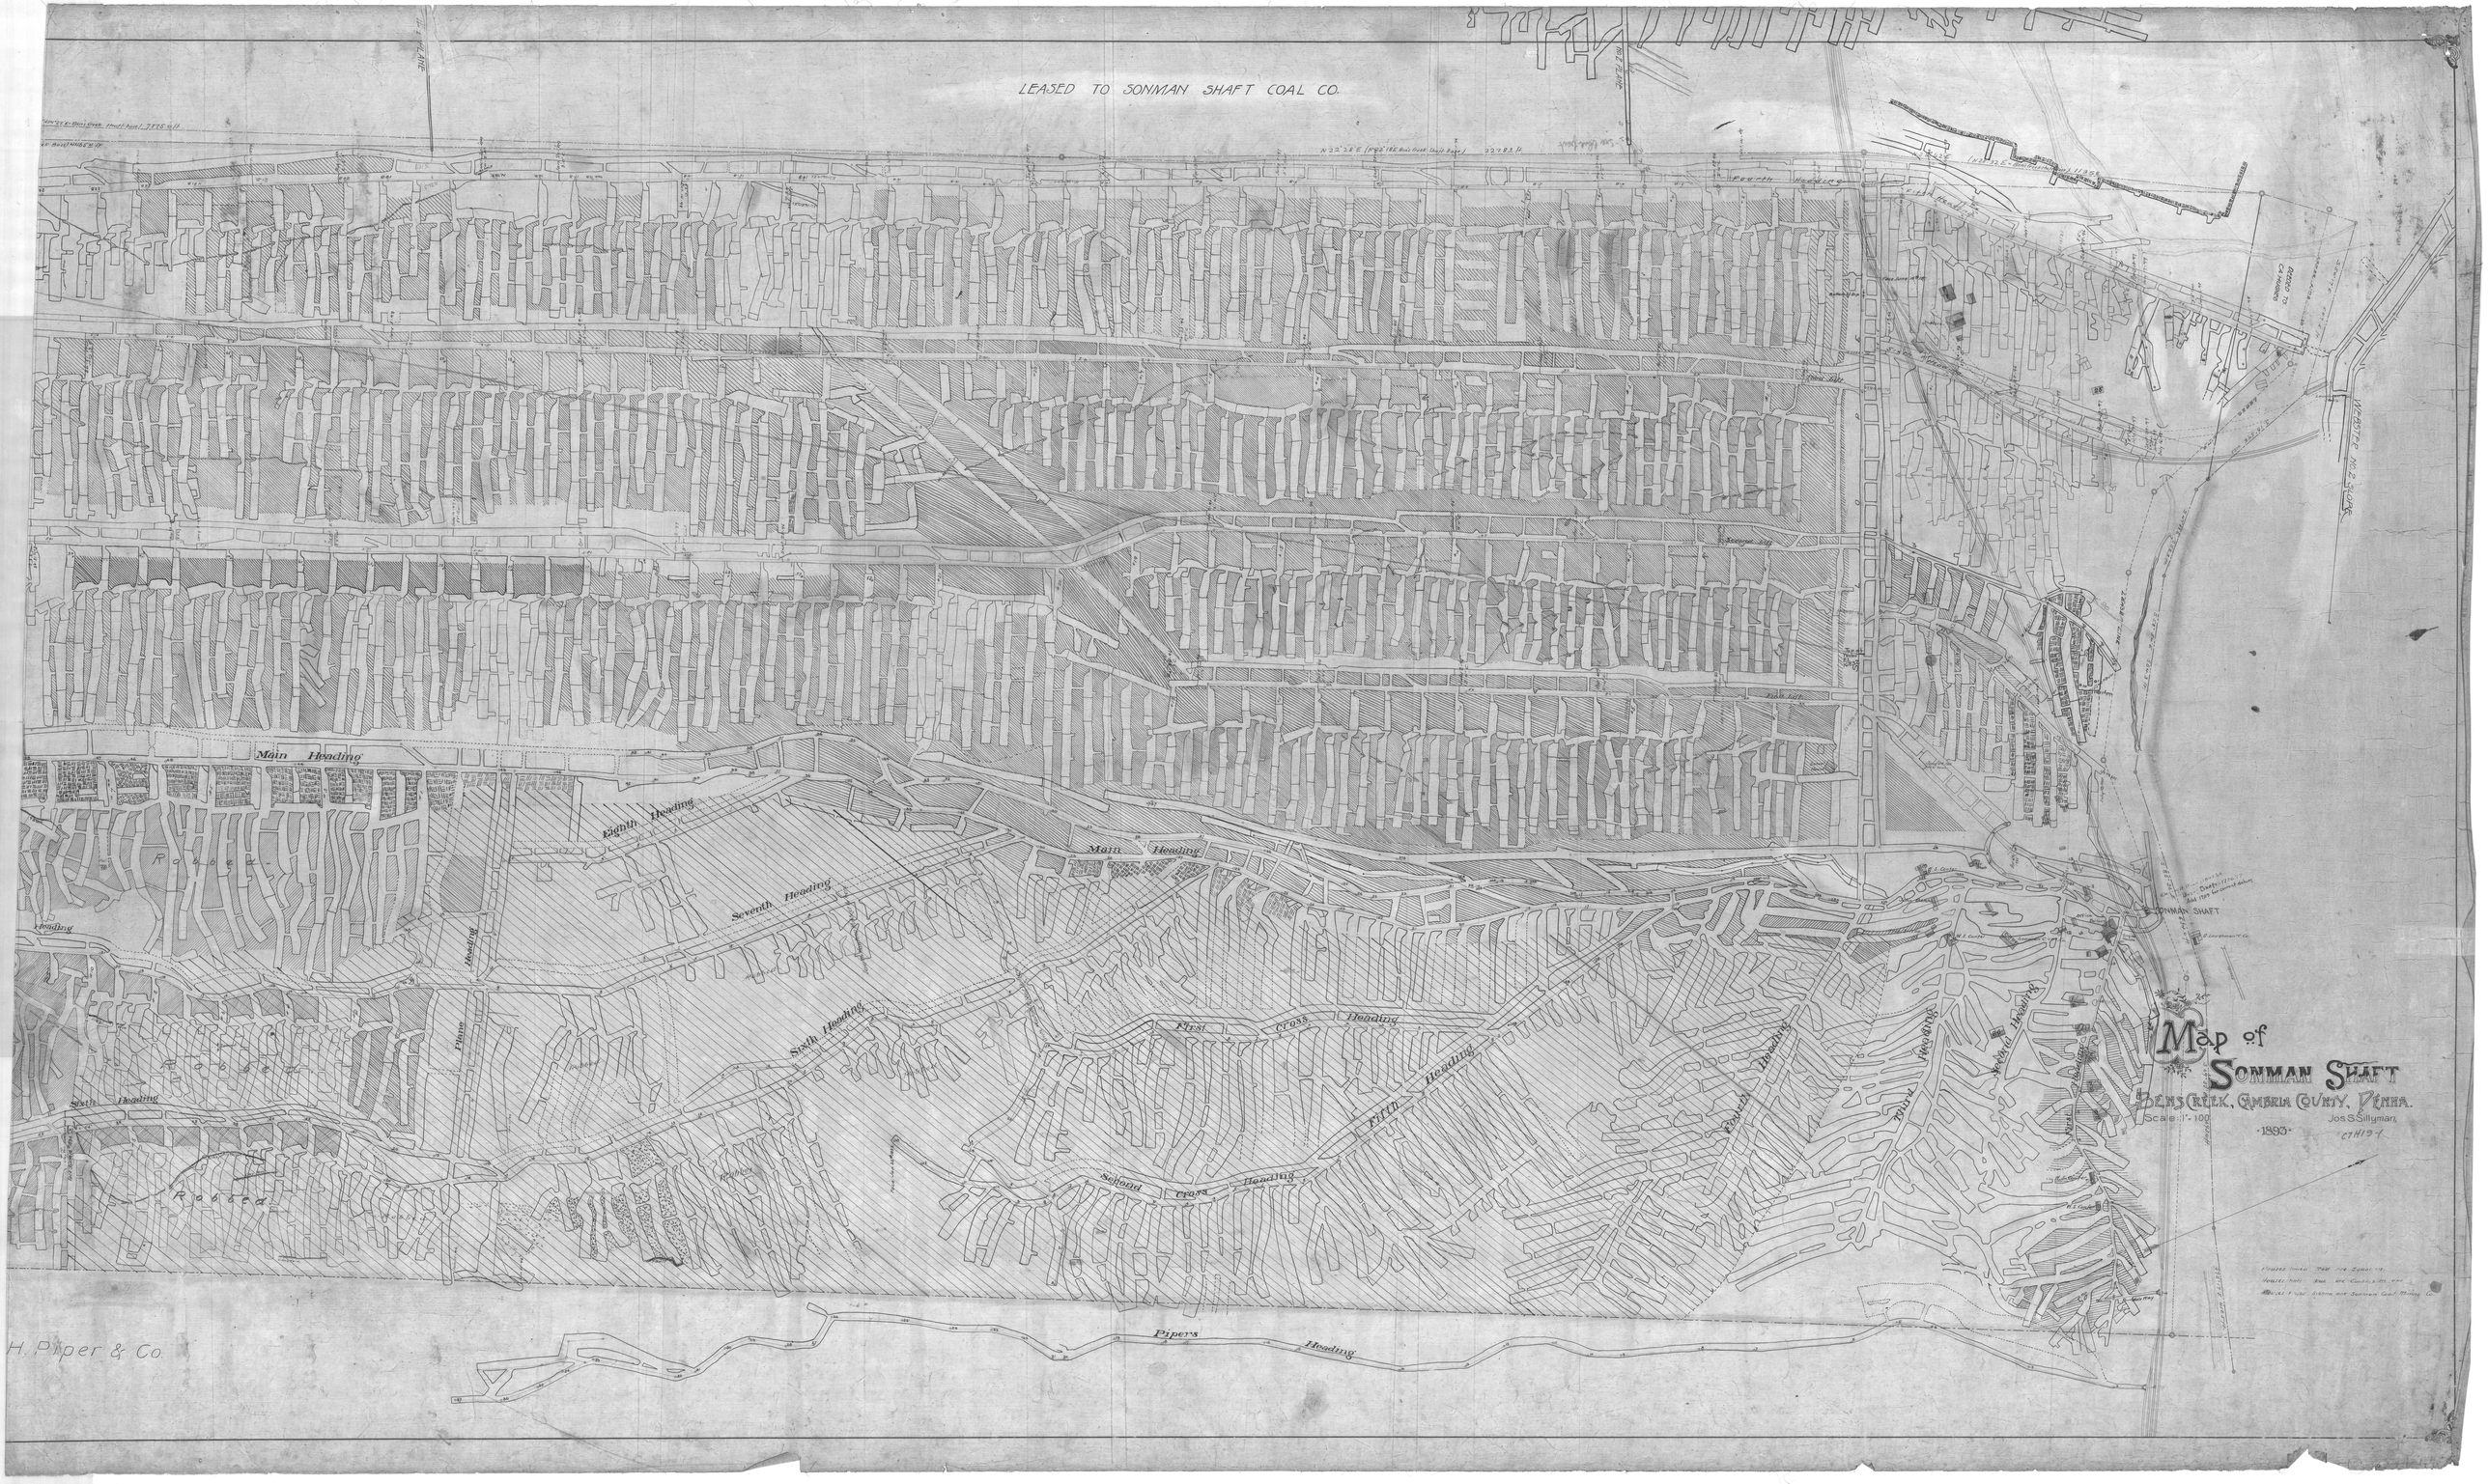
LEASED TO SONMAN SHAFT COAL CO.
Main Heading
Eighth Heading
Seventh Heading
Sixth Heading
Fifth Heading
Fourth Heading
Third Heading
Second Cross Heading
First Cross Heading
Pipers Heading
Pillars
Robbed
Fourth Heading
Fifth Heading
Sixth Heading
Seventh Heading
Eighth Heading
Main Heading
Pipers Heading
Robbed
Robbed
Robbed