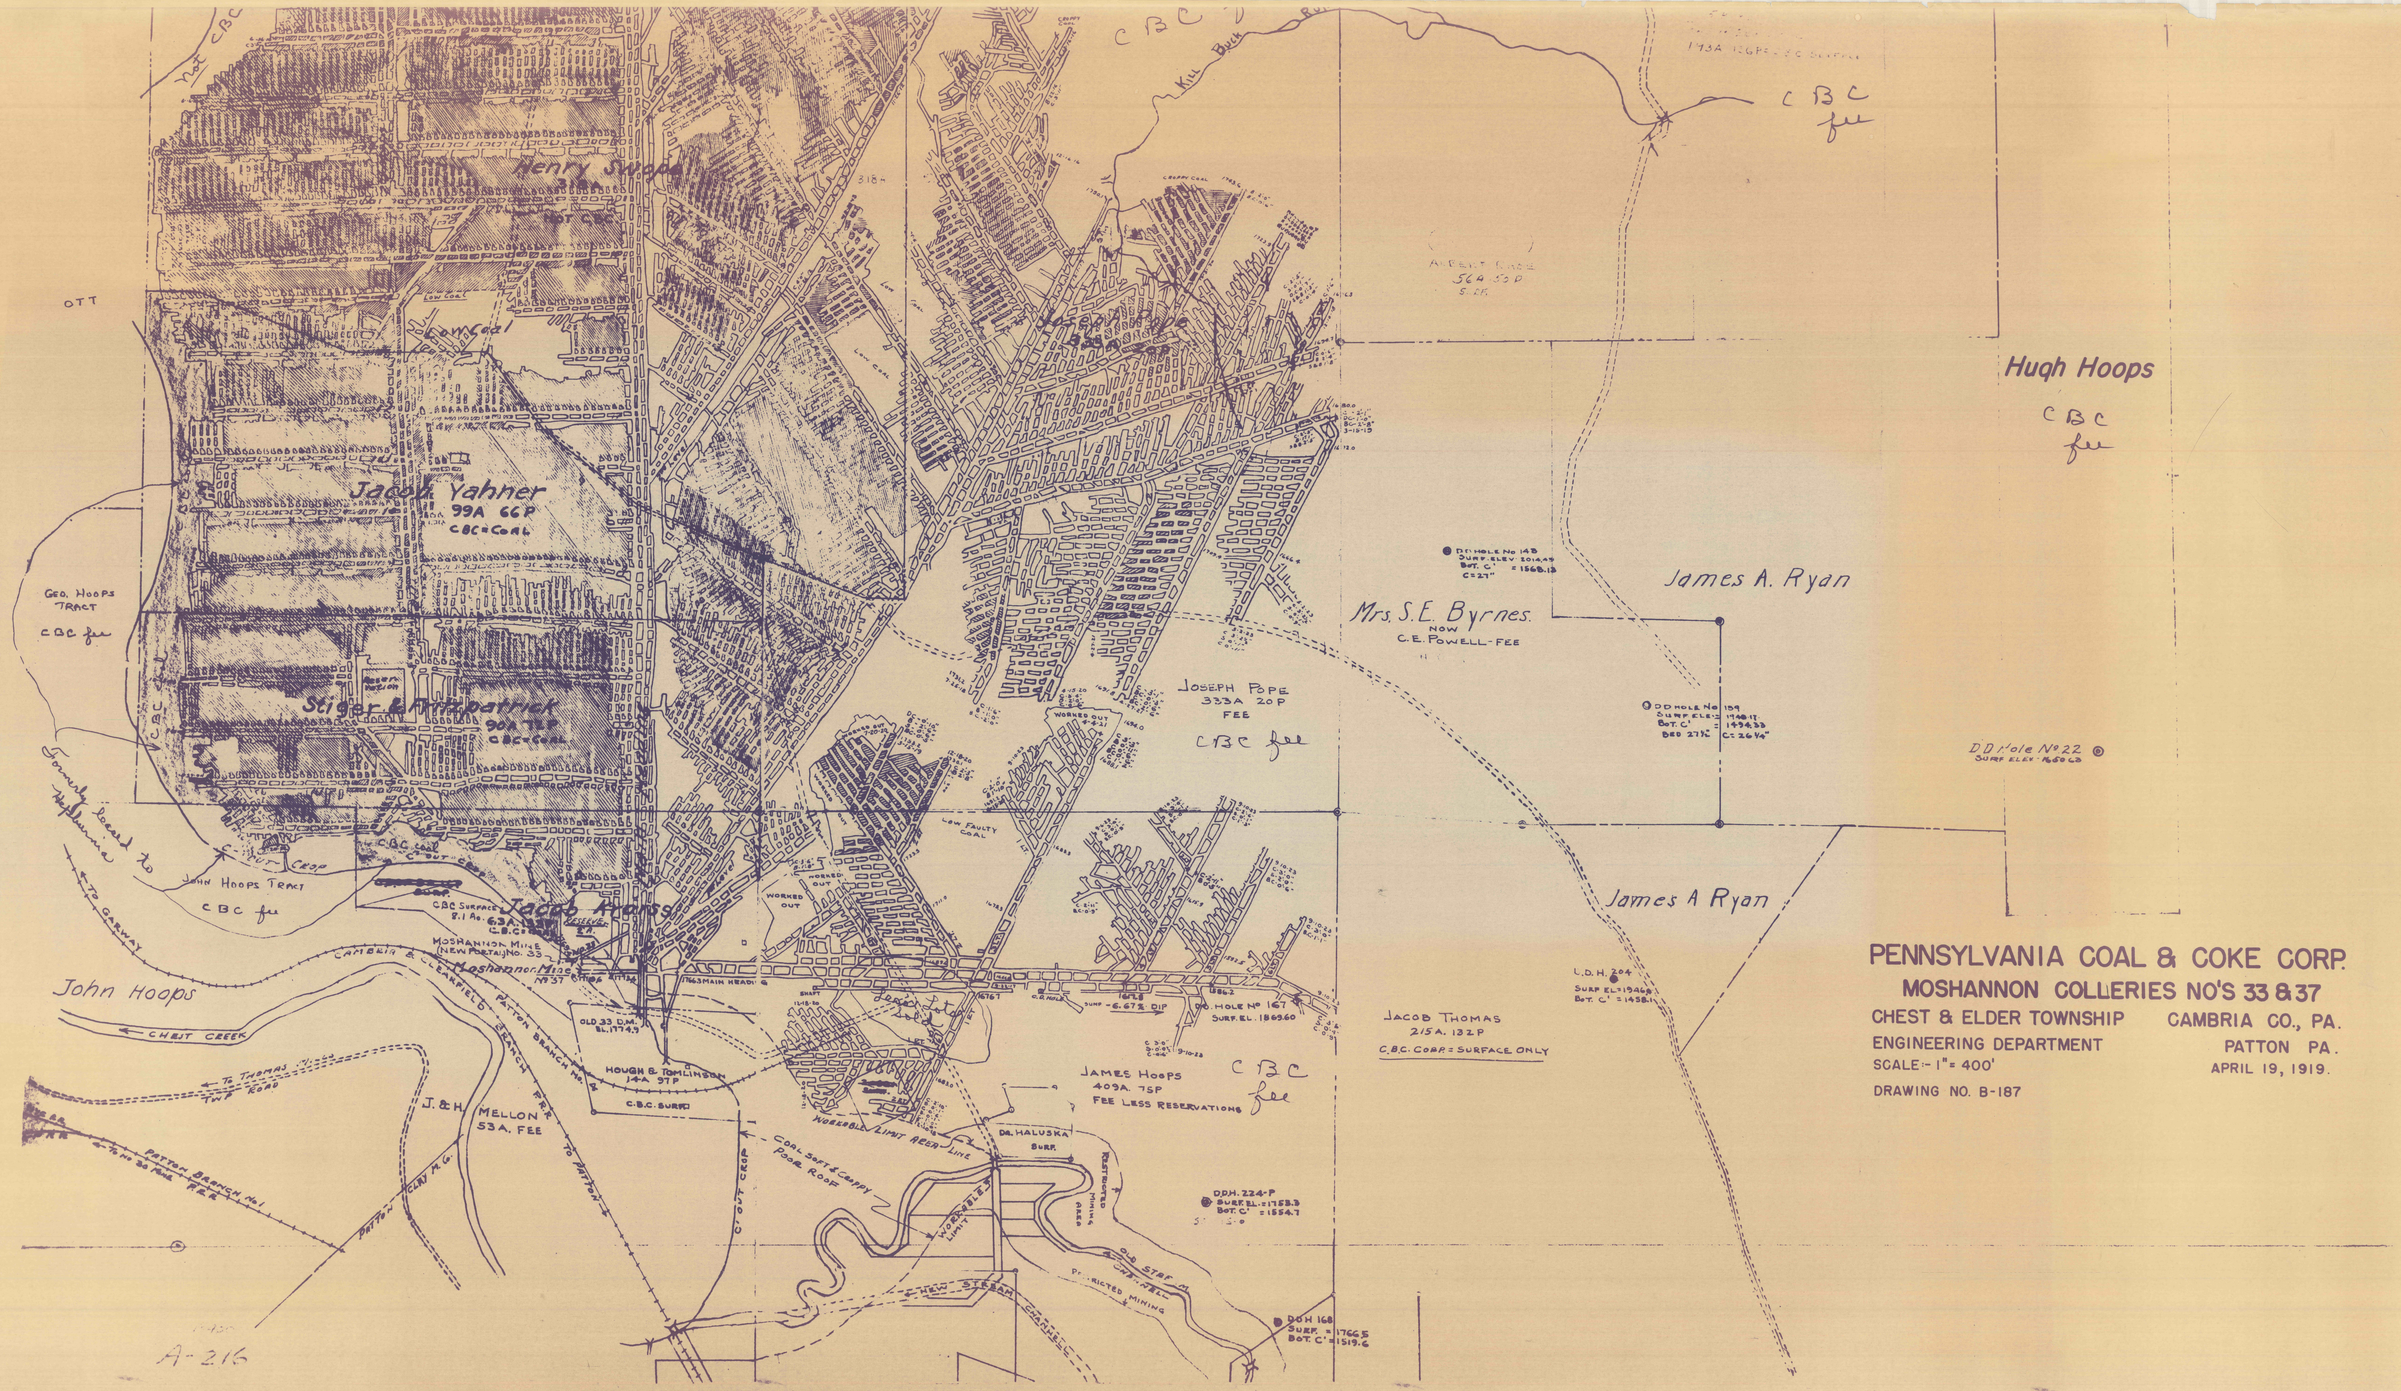
PENNSYLVANIA COAL & COKE CORP.
MOSHANNON COLLERIES NO'S 33 & 37
CHEST & ELDER TOWNSHIP
CAMBRIA CO., PA.
ENGINEERING DEPARTMENT
PATTON PA.
SCALE:- 1" = 400'
APRIL 19, 1919.
DRAWING NO. B-187
Henry Sugar
Jacob Yahner
99A 66P
CBC-Coal
Stiger & McCabe
90A 75P
CBC-Coal
Geo. Hoops Tract
CBC fee
John Hoops Tract
CBC fee
Jacob Adams
CBC Surface
8.1 Ac. 6.3A.
C.B.C.
Moshannon Mine
(New Portal No. 33)
Moshannon Mine
No 37
John Hoops
Joseph Pope
333A 20P
FEE
CBC fee
Mrs. S.E. Byrnes
NOW
C.E. Powell-Fee
James A. Ryan
Hugh Hoops
CBC
fee
D.D. Hole No 22
Surf Elev. 1460 C.D.
James A Ryan
Jacob Thomas
215A. 132P
C.B.C. Coal = Surface Only
James Hoops
409A. 75P
FEE LESS RESERVATIONS
CBC
fee
Hough & Tomlinson
14A 97P
C.B.C. Surf.
J. & H. Mellon
53A. FEE
Chest Creek
Patton Branch No. 1
Patton Branch No. 2
Dr. Haluska
Surf.
Old Step
New Steam Channel
Restricted Mining
Prohibited Mining
Low Coal
Low Faulty Coal
Worked Out
Main Heading
Old 33 D.H.
El. 1774.9
D.D. Hole No 167
Surf. El. 1860.60
D.D.H. 224-P
Surf. El. = 1758.3
Bot. C' = 1554.7
D.D.H. 168
Surf. = 1766.5
Bot. C' = 1519.6
U.D.H. 264
Surf El. = 1946.8
Bot. C' = 1458.1
Kill Buck Run
To Garway
To Thomas
Twp Road
A-216