


LEASEHOLDS AND OWNERSHIPS  
OF THE  
**SONMAN SHAFT COAL CO.**  
IN THE  
"E" OR UPPER FREEPORT SEAM.  
PORTAGE AND SUMMERHILL TOWNSHIPS, CAMBRIA COUNTY, PA.  
SCALE 1"=400'

W.A. SULLIVAN  
ENGINEER  
ALTOONA, PA.

8 INCH SHIRT TO "E" SEAM  
RESERVE AREA

CAMBRIA COUNTY COAL CO.

ESTATE OF HENRY McCORMICK

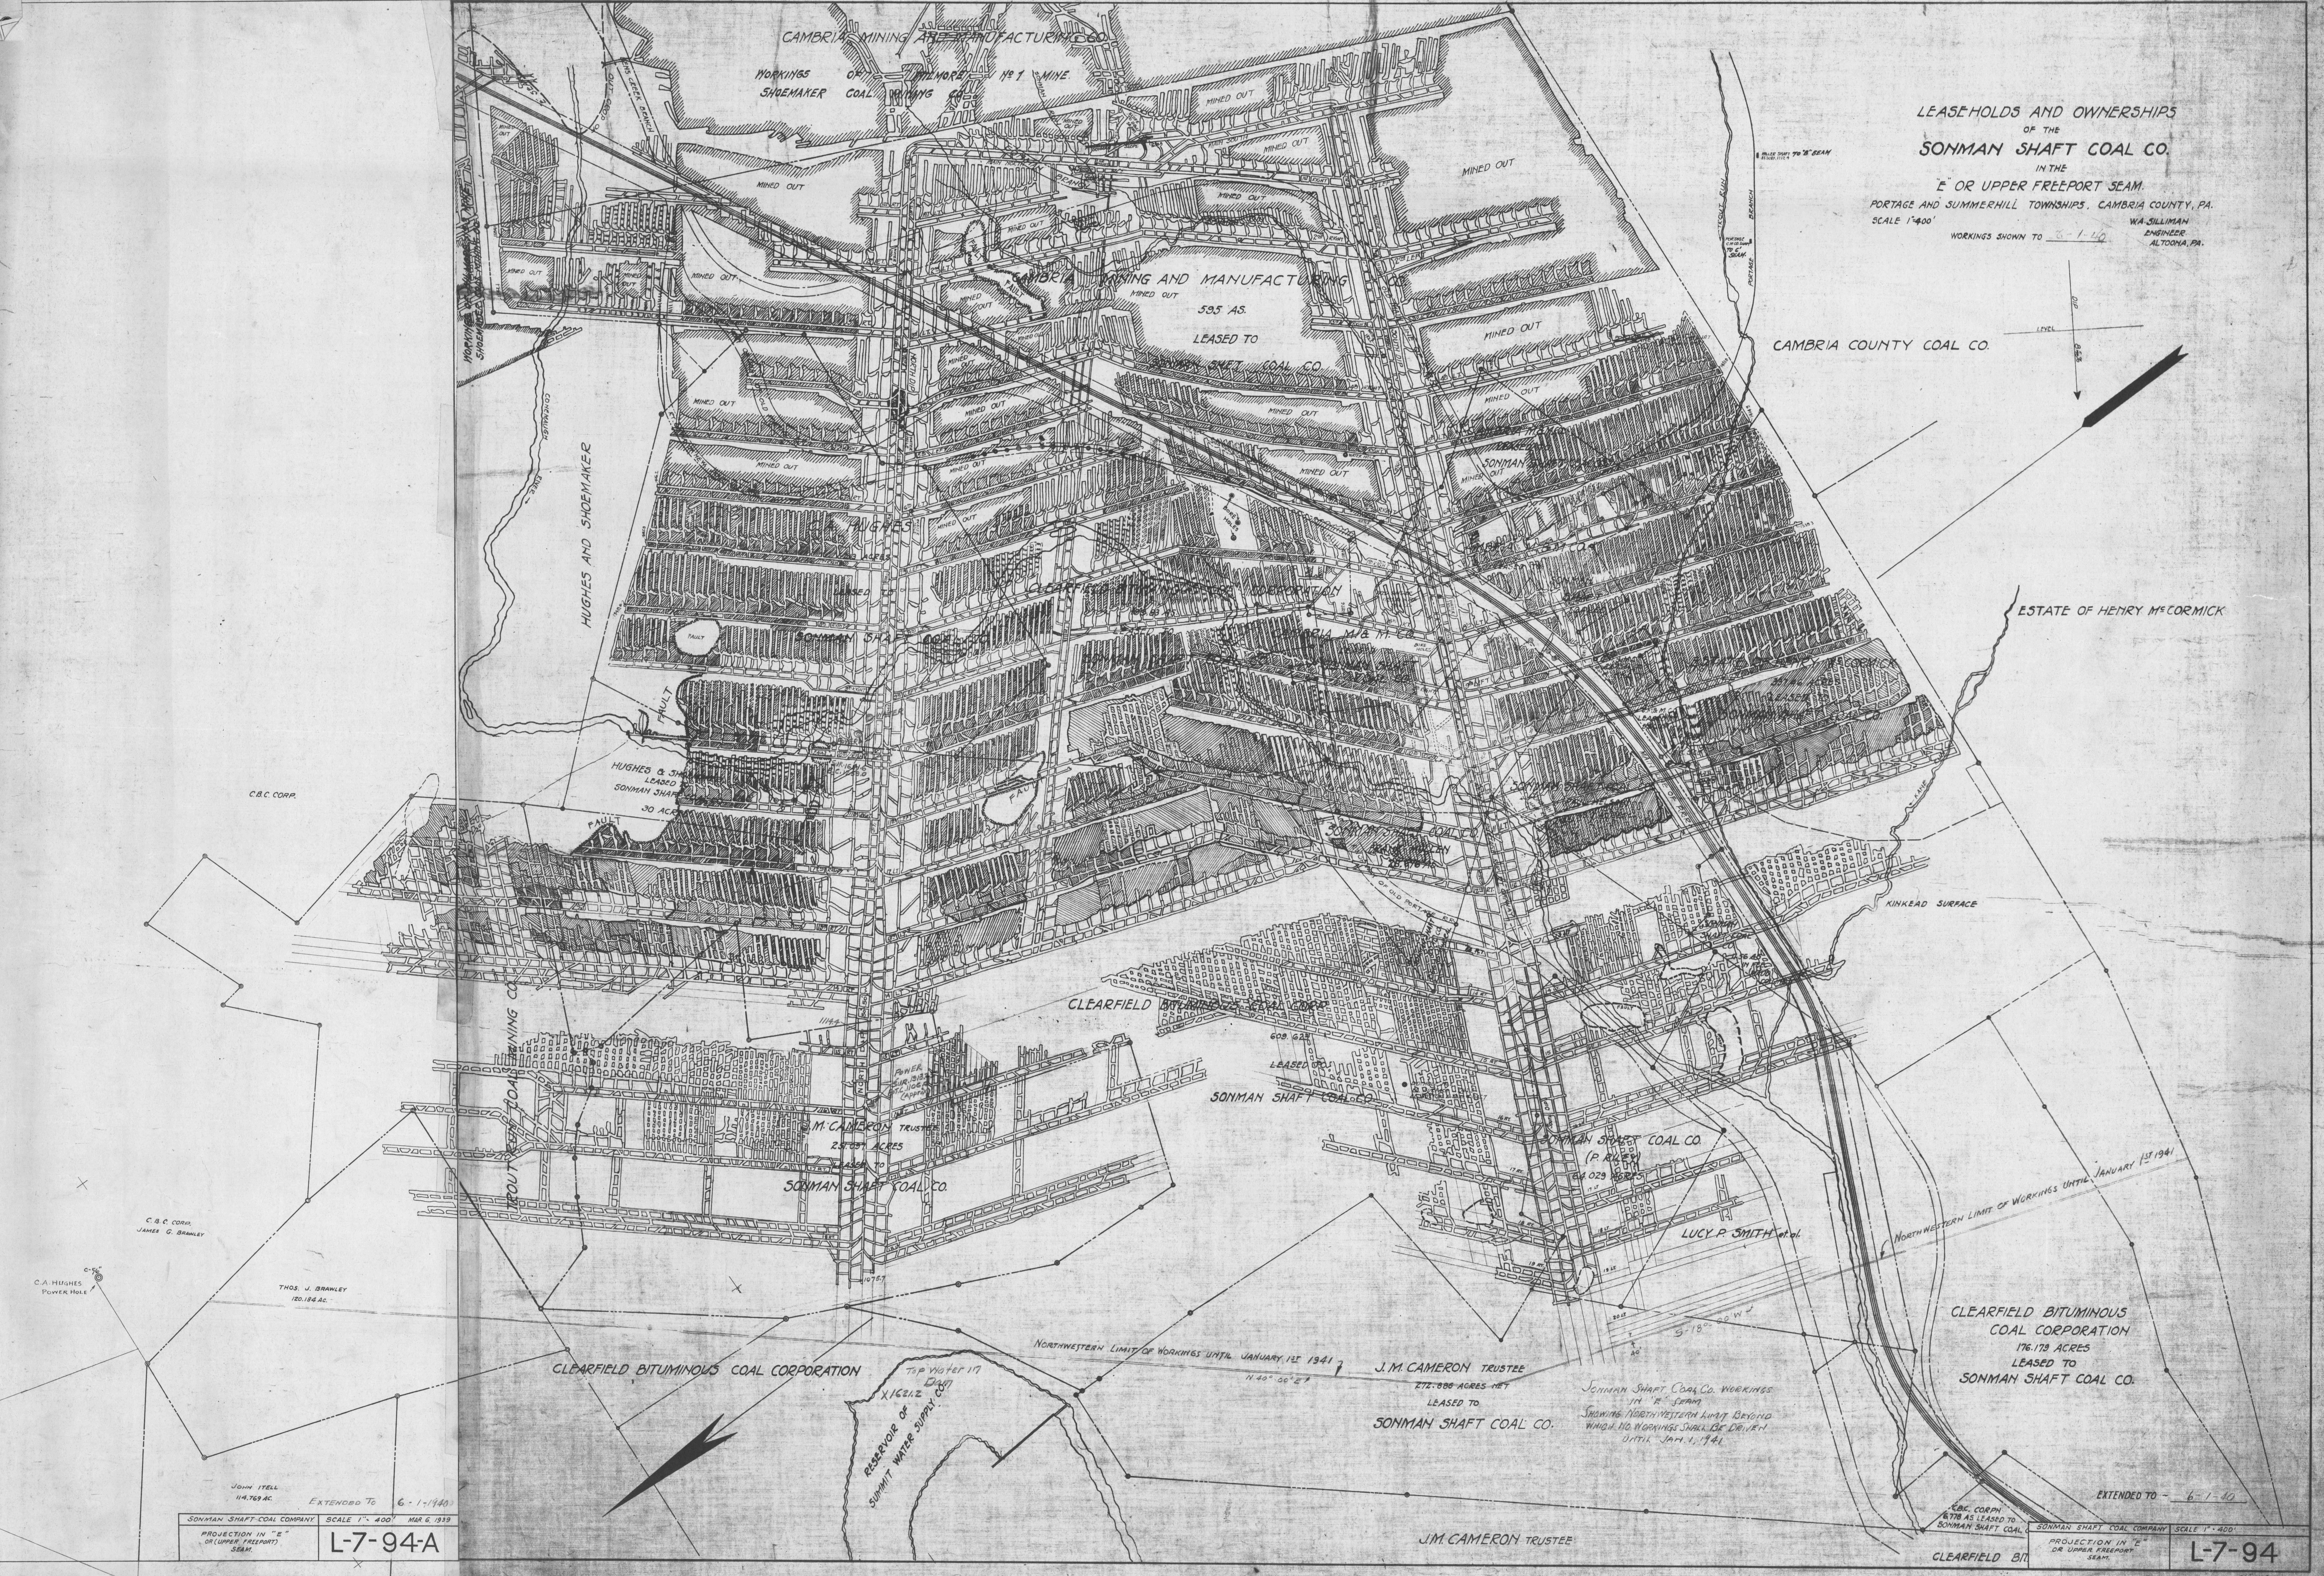

JOHN IYELL  
114,769 AC. EXTENDED TO 6-1-1940

SONMAN SHAFT COAL COMPANY SCALE 1"=400' MAR 6, 1939  
PROJECTION IN "E" OR UPPER FREEPORT SEAM.  
**L-7-94-A**

RESERVOIR OF  
SUMMIT WATER SUPPLY

NORTHWESTERN LIMIT OF WORKINGS UNTIL JANUARY 12, 1941  
114° 00' 00" E

J.M. CAMERON TRUSTEE  
272,000 ACRES NET  
LEASED TO  
SONMAN SHAFT COAL CO.

SONMAN SHAFT COAL CO. WORKINGS  
IN "E" SEAM  
SHOWING NORTHWESTERN LIMIT BEYOND  
WHICH NO WORKINGS SHALL BE DONE  
UNTIL JAN. 1, 1941

CLEARFIELD BITUMINOUS  
COAL CORPORATION  
176,178 ACRES  
LEASED TO  
SONMAN SHAFT COAL CO.

EXTENDED TO - 6-1-1940

SONMAN SHAFT COAL COMPANY SCALE 1"=400'  
PROJECTION IN "E" OR UPPER FREEPORT SEAM.  
**L-7-94**