


Note - Area of Portage, lots for July 1946 deflation calculations were calculated from this tracing, except Parcel 1 of Koppers Lease from tracing of buildings below 8th South

SONMAN SHAFT COAL CO
MAP SHOWING WORKINGS IN B SEAM
RELATIVE TO
LOTS IN PORTAGE BOROUGH
SCALE 1"=100'

JOS. S. SIAKMAN & CO.
ENGINEERS.

□ INDICATES LOTS NOT OWNED BY CAMBRIA M & M CO.
PRE. LOTS AND RIGHT OF WAY OUTLINED
CAMBRIA COUNTY COAL CO PROPERTY OUTLINED

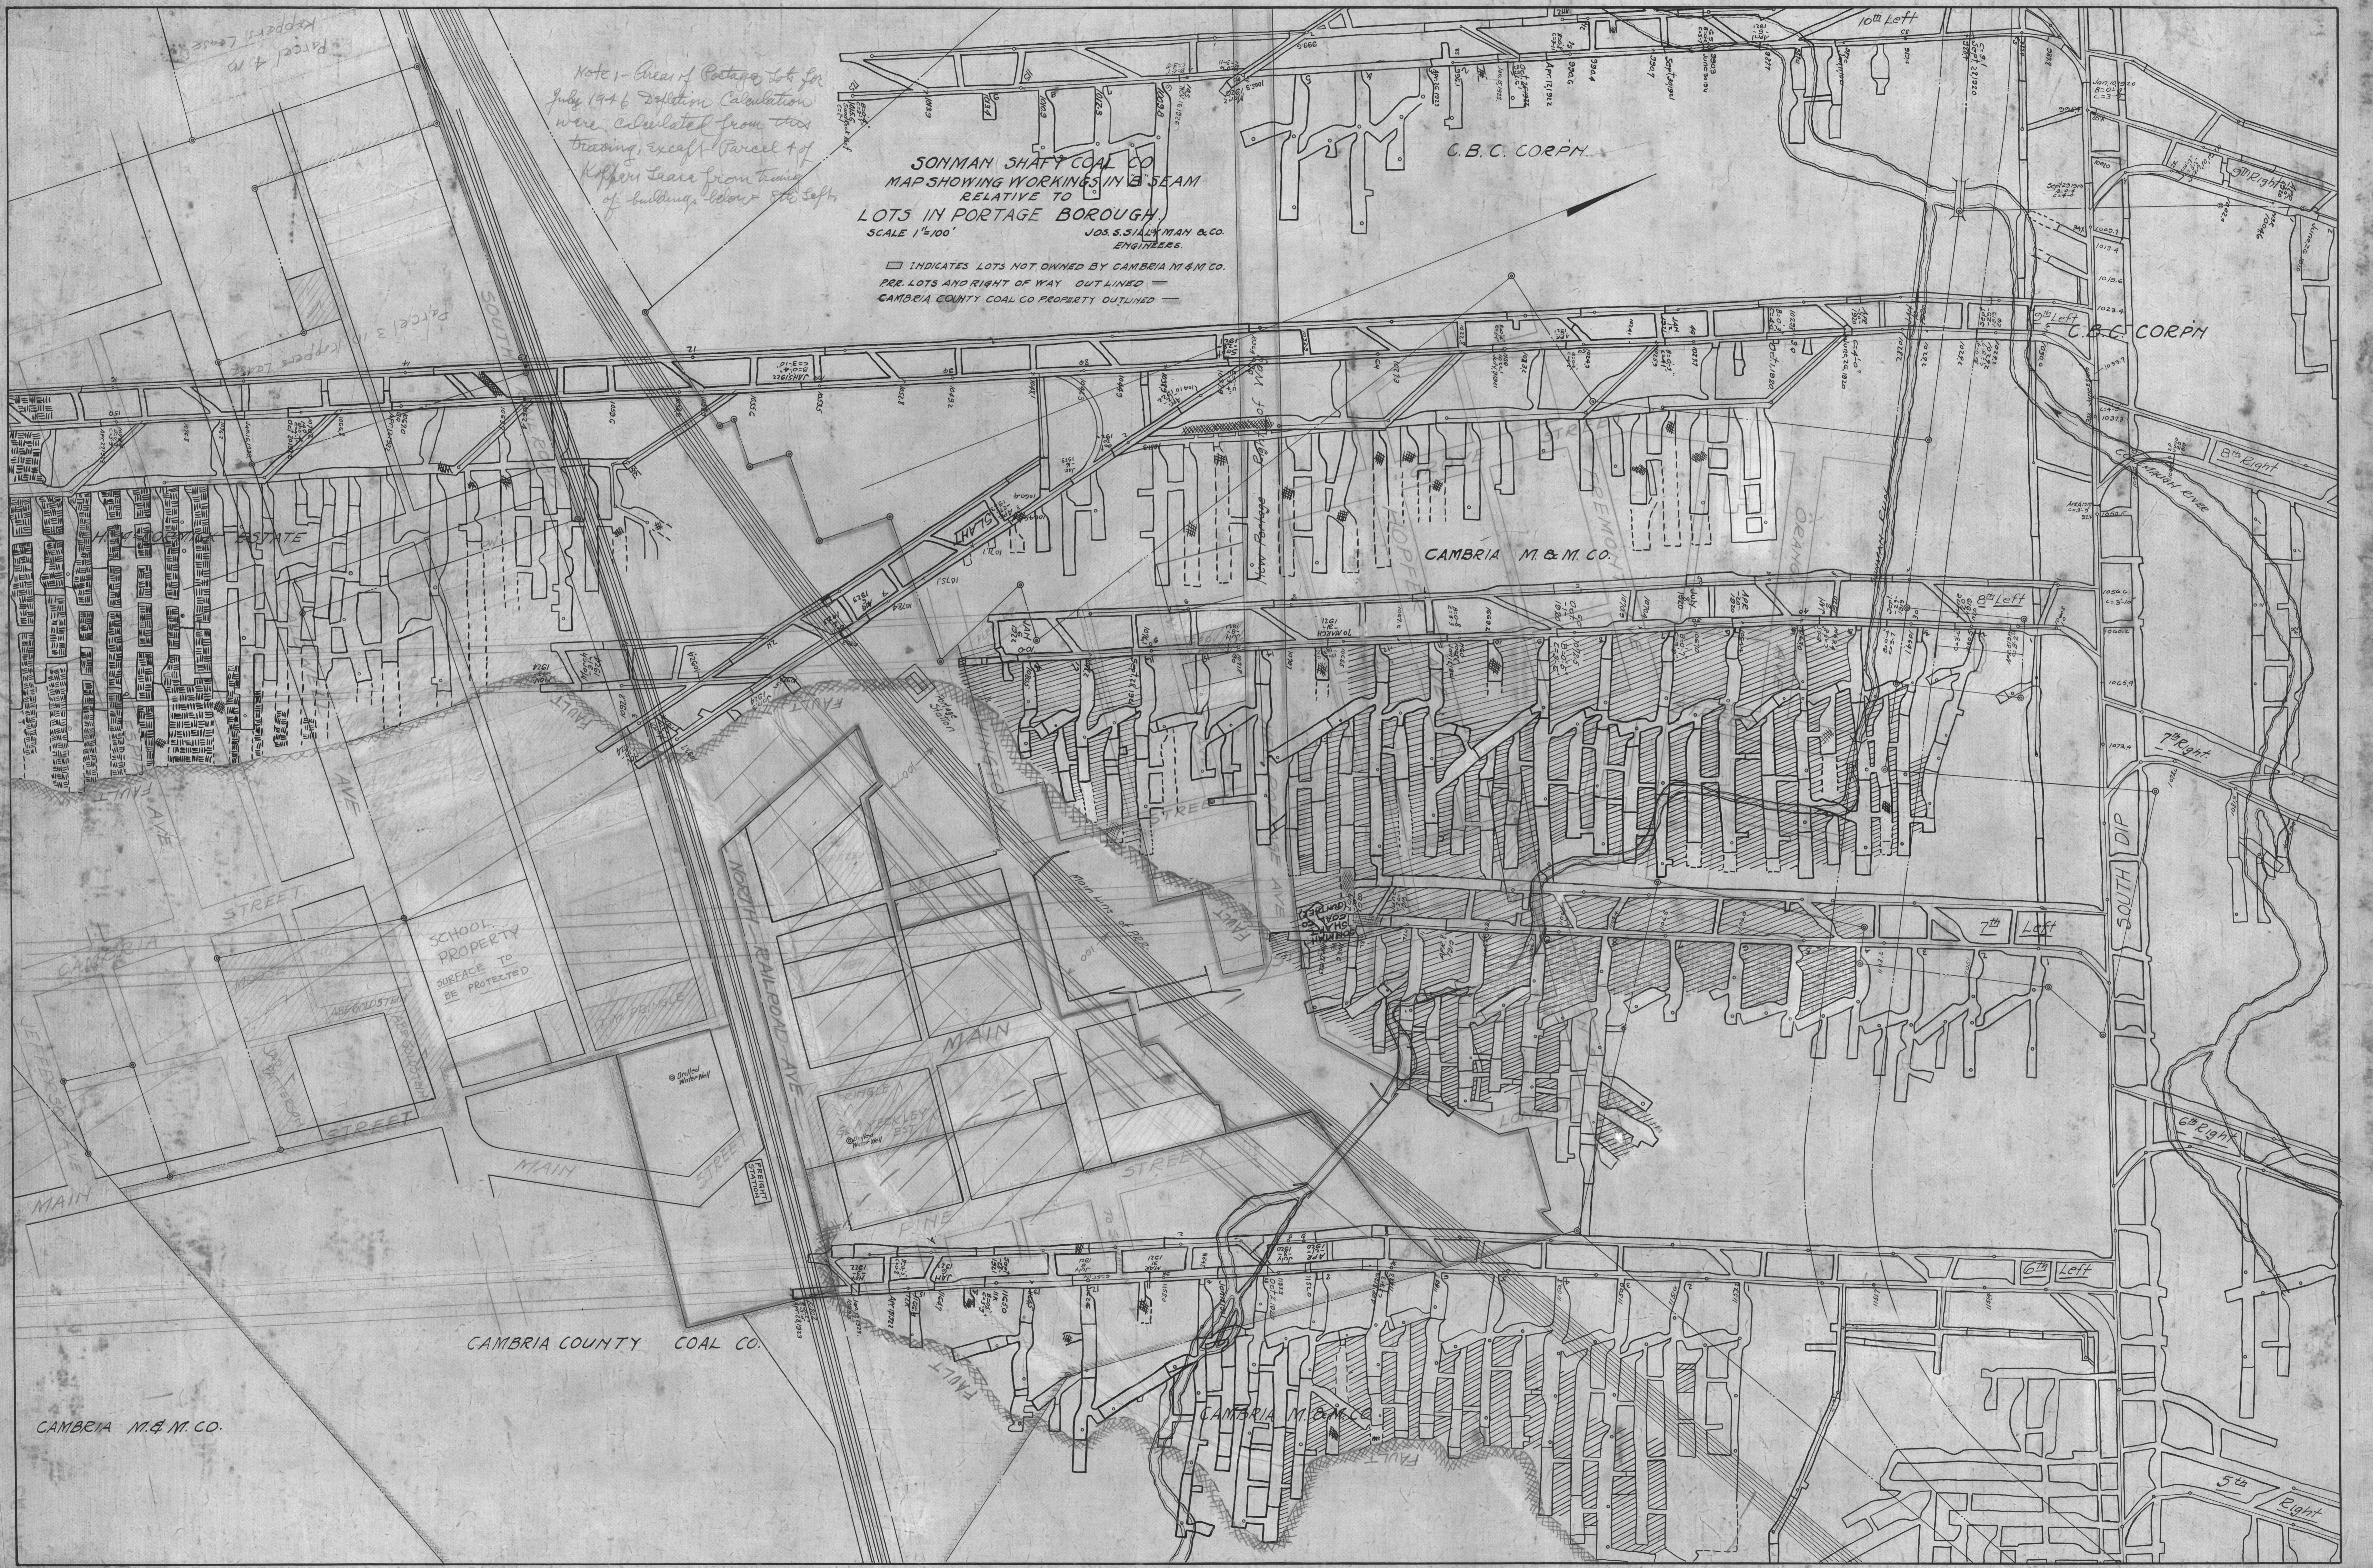

CAMBRIA M & M CO.

CAMBRIA COUNTY COAL CO.

CAMBRIA M & M CO.

CAMBRIA M & M CO.

C.B.C. CORPN.

C.B.C. CORPN.

SCHOOL PROPERTY
SURFACE TO
BE PROTECTED

STREET

STREET

MAIN

STREET

MAIN

SOUTH DIP

7th Right

8th Left

9th Left

10th Left

5th Right

6th Right

7th Right

8th Right

9th Right

10th Right

Parcel 3

Parcel 4

Parcel 5

Parcel 6

Parcel 7

Parcel 8

Parcel 9

Parcel 10

Parcel 11

Parcel 12

Parcel 13

Parcel 14

Parcel 15

Parcel 16

Parcel 17

Parcel 18

Parcel 19

Parcel 20

Parcel 21

Parcel 22

Parcel 23

Parcel 24

Parcel 25

Parcel 26

Parcel 27

Parcel 28

Parcel 29

Parcel 30

Parcel 31

Parcel 32

Parcel 33

Parcel 34

Parcel 35