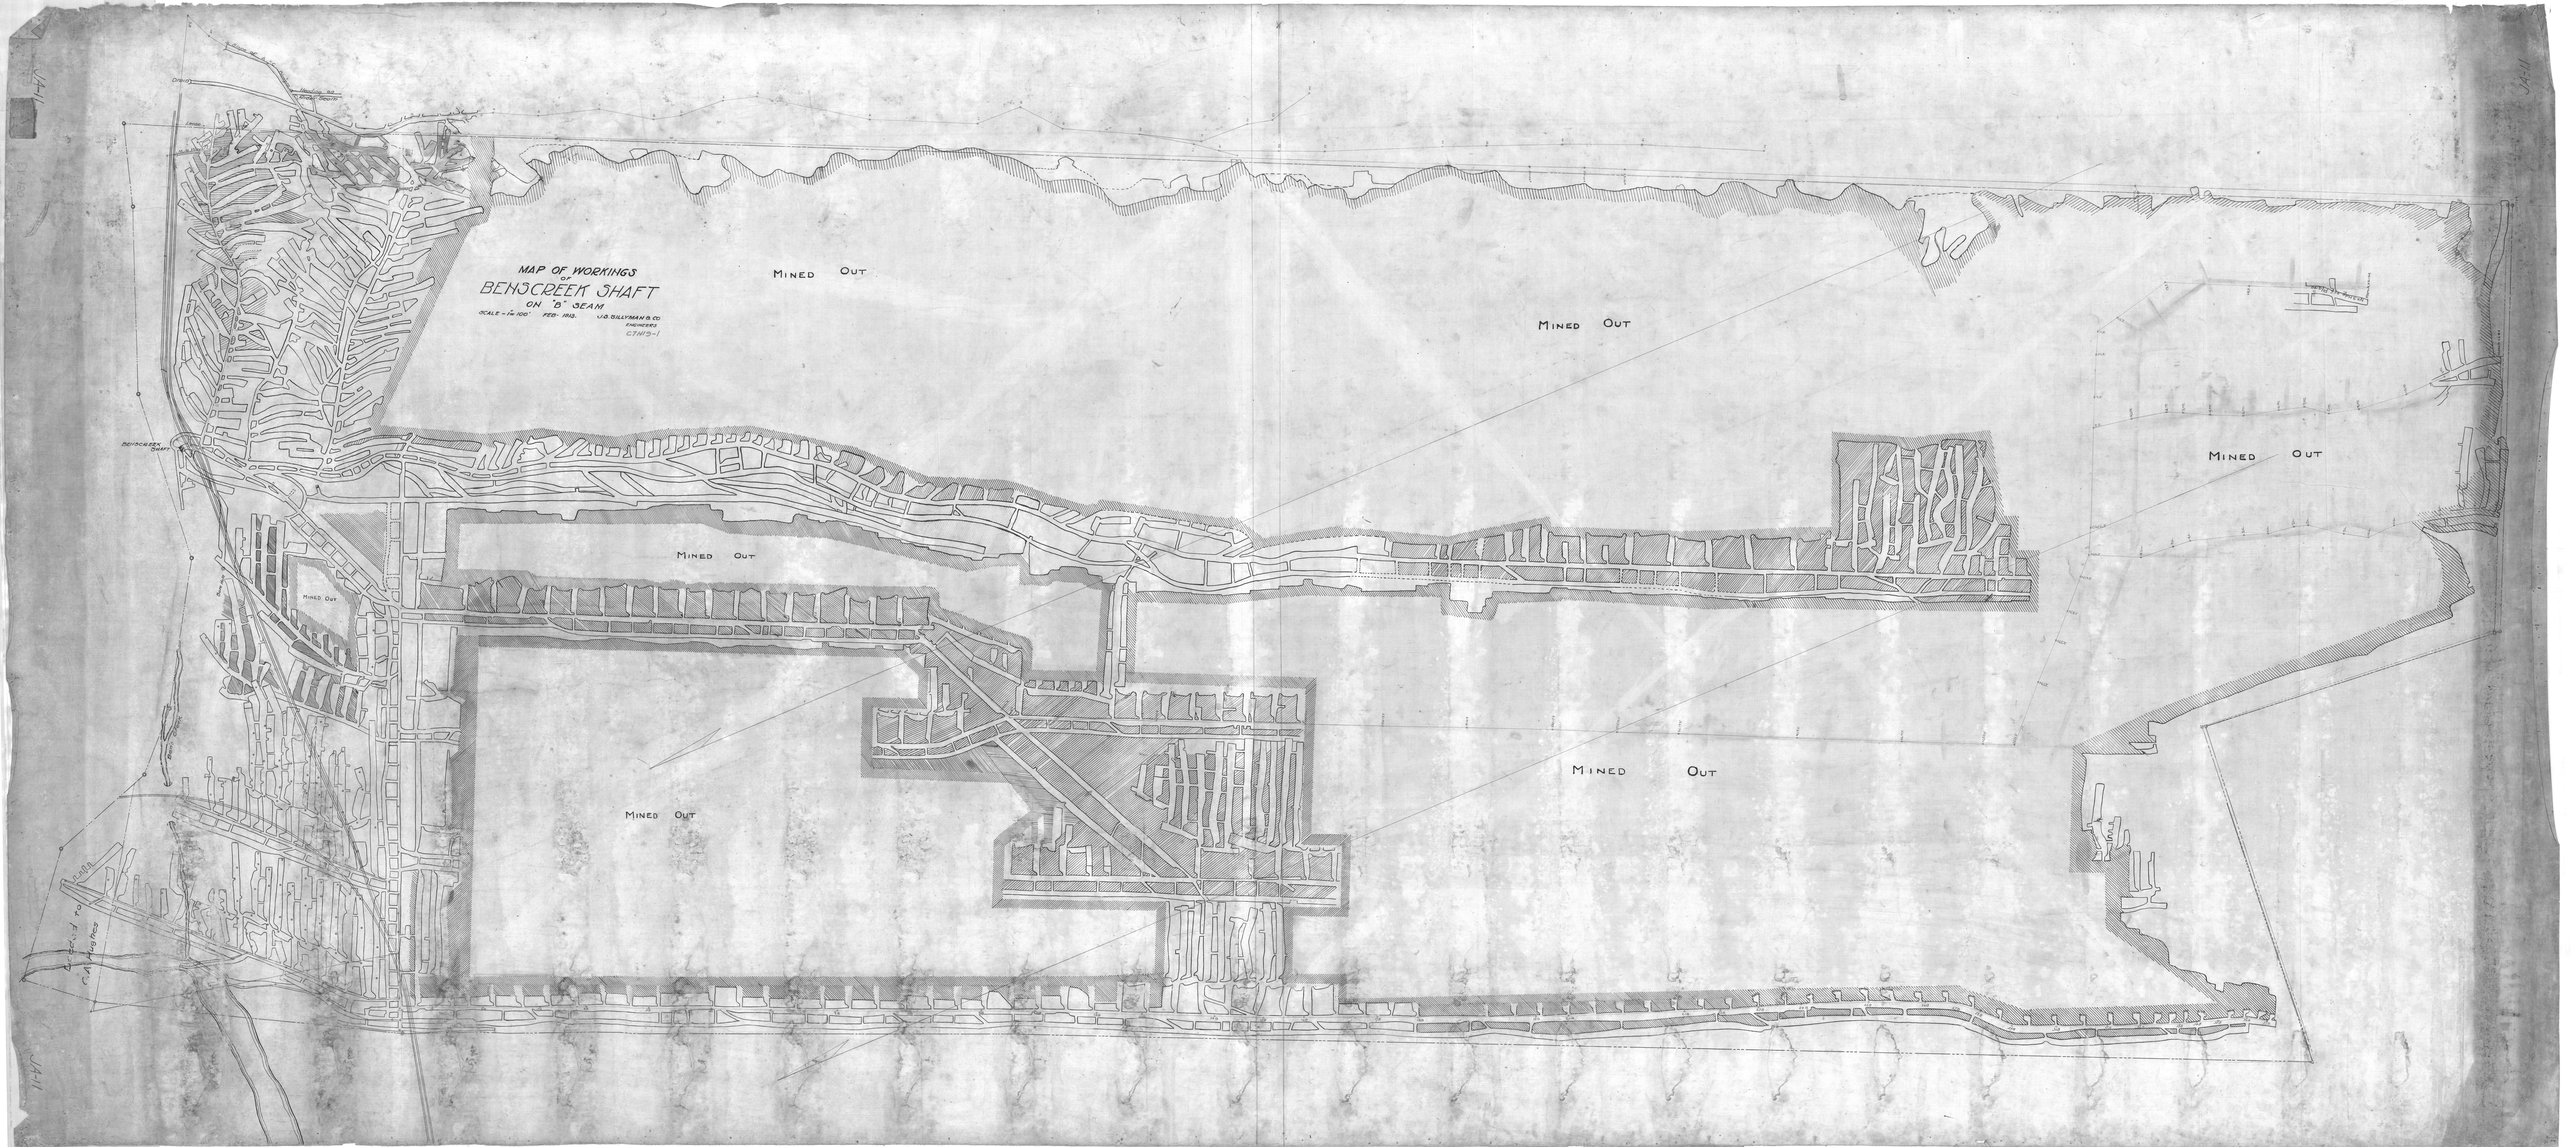

JA-11

MAP OF WORKINGS
OF
BENSCREEK SHAFT
ON "B" SEAM

SCALE – 1" = 100' FEB – 1913. J.S. SILLYMAN & CO
ENGINEERS

C7H19-1

Slope of A. & C. Blevens & Co.
Drain
Heading on Rider Seam
Lease Line
Mule Way
BENSCREEK SHAFT
MINED OUT
MINED OUT
MINED OUT
MINED OUT
MINED OUT
MINED OUT
MINED OUT
Ben's Creek
Deeded to C.A. Hughes
No 3 Hdg off Plane
March 22.04
March 22 04
13.J.
14.J.
12.J.
11.J.
10.J.
9.J.
8.J.
N.1.M.
2.M.
3.M.
4.M.
5.M.
6.M.
7.M.
8.M.
9.M.
10.M.
1.M.

JA-11