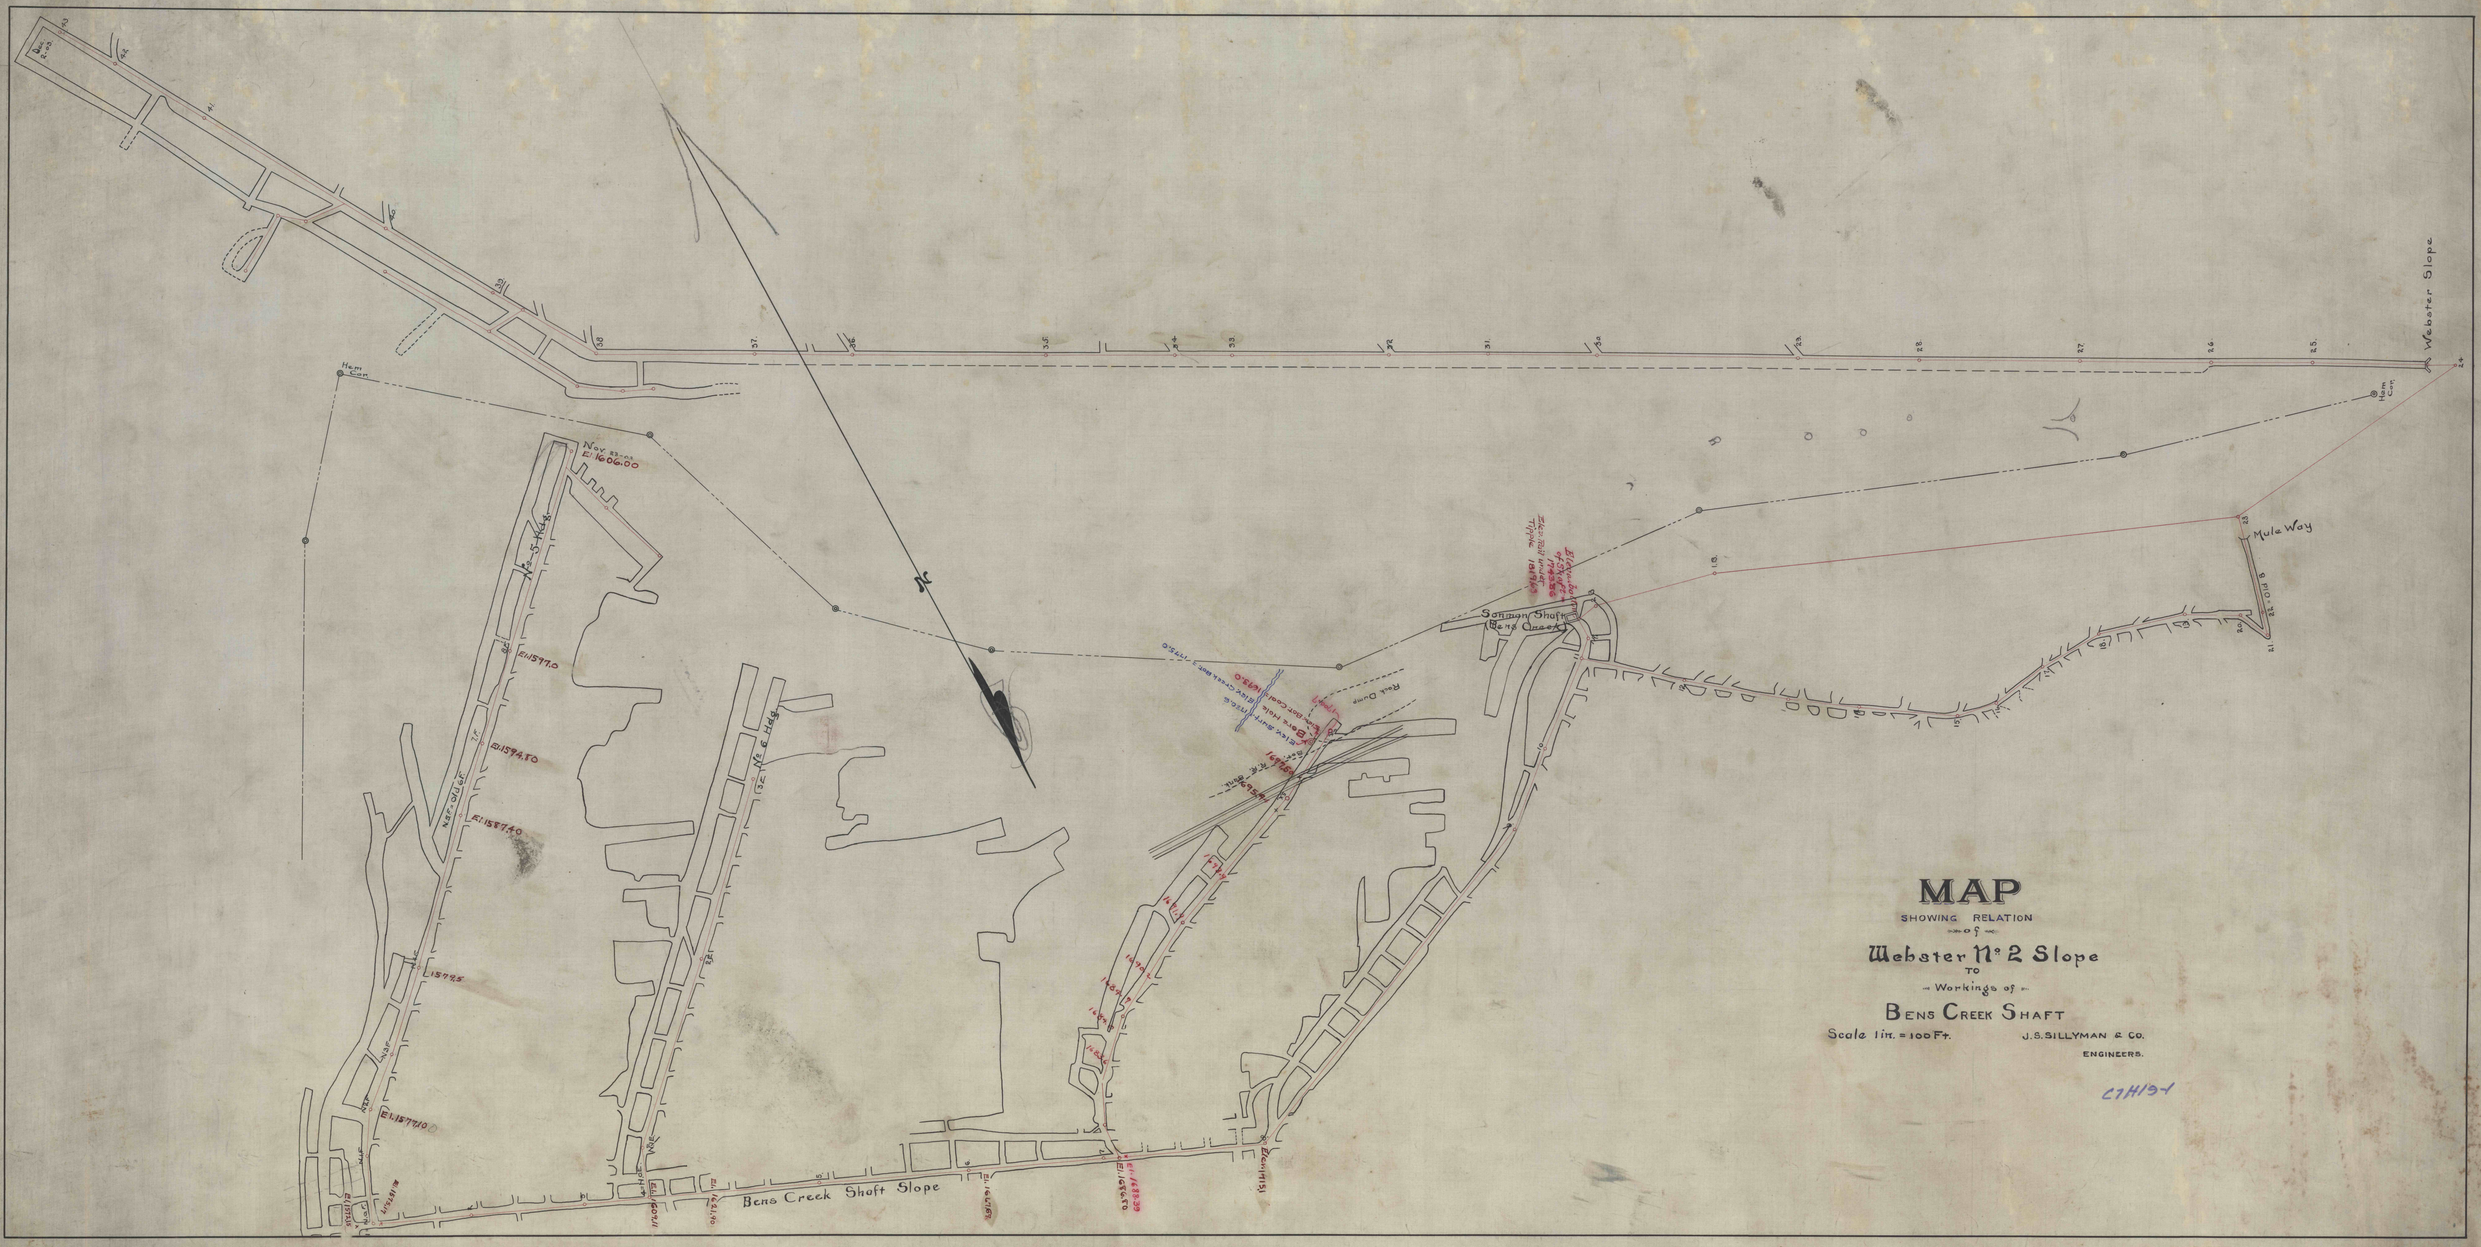
MAP
SHOWING RELATION
of
Webster No 2 Slope
TO
Workings of
BENS CREEK SHAFT
Scale 1in. = 100 Ft.
J.S. SILLYMAN & CO.
ENGINEERS.
Webster Slope
Mule Way
Sonman Shaft
Bens Creek
Bens Creek Shaft Slope
Hem Cor.
Nov. 23-03
El. 1606.00
No 5 Hdg.
No 6 Hdg.
El. 1577.0
El. 1594.50
El. 1587.40
El. 1577.10
El. 1588.39
Rock Dump
N


