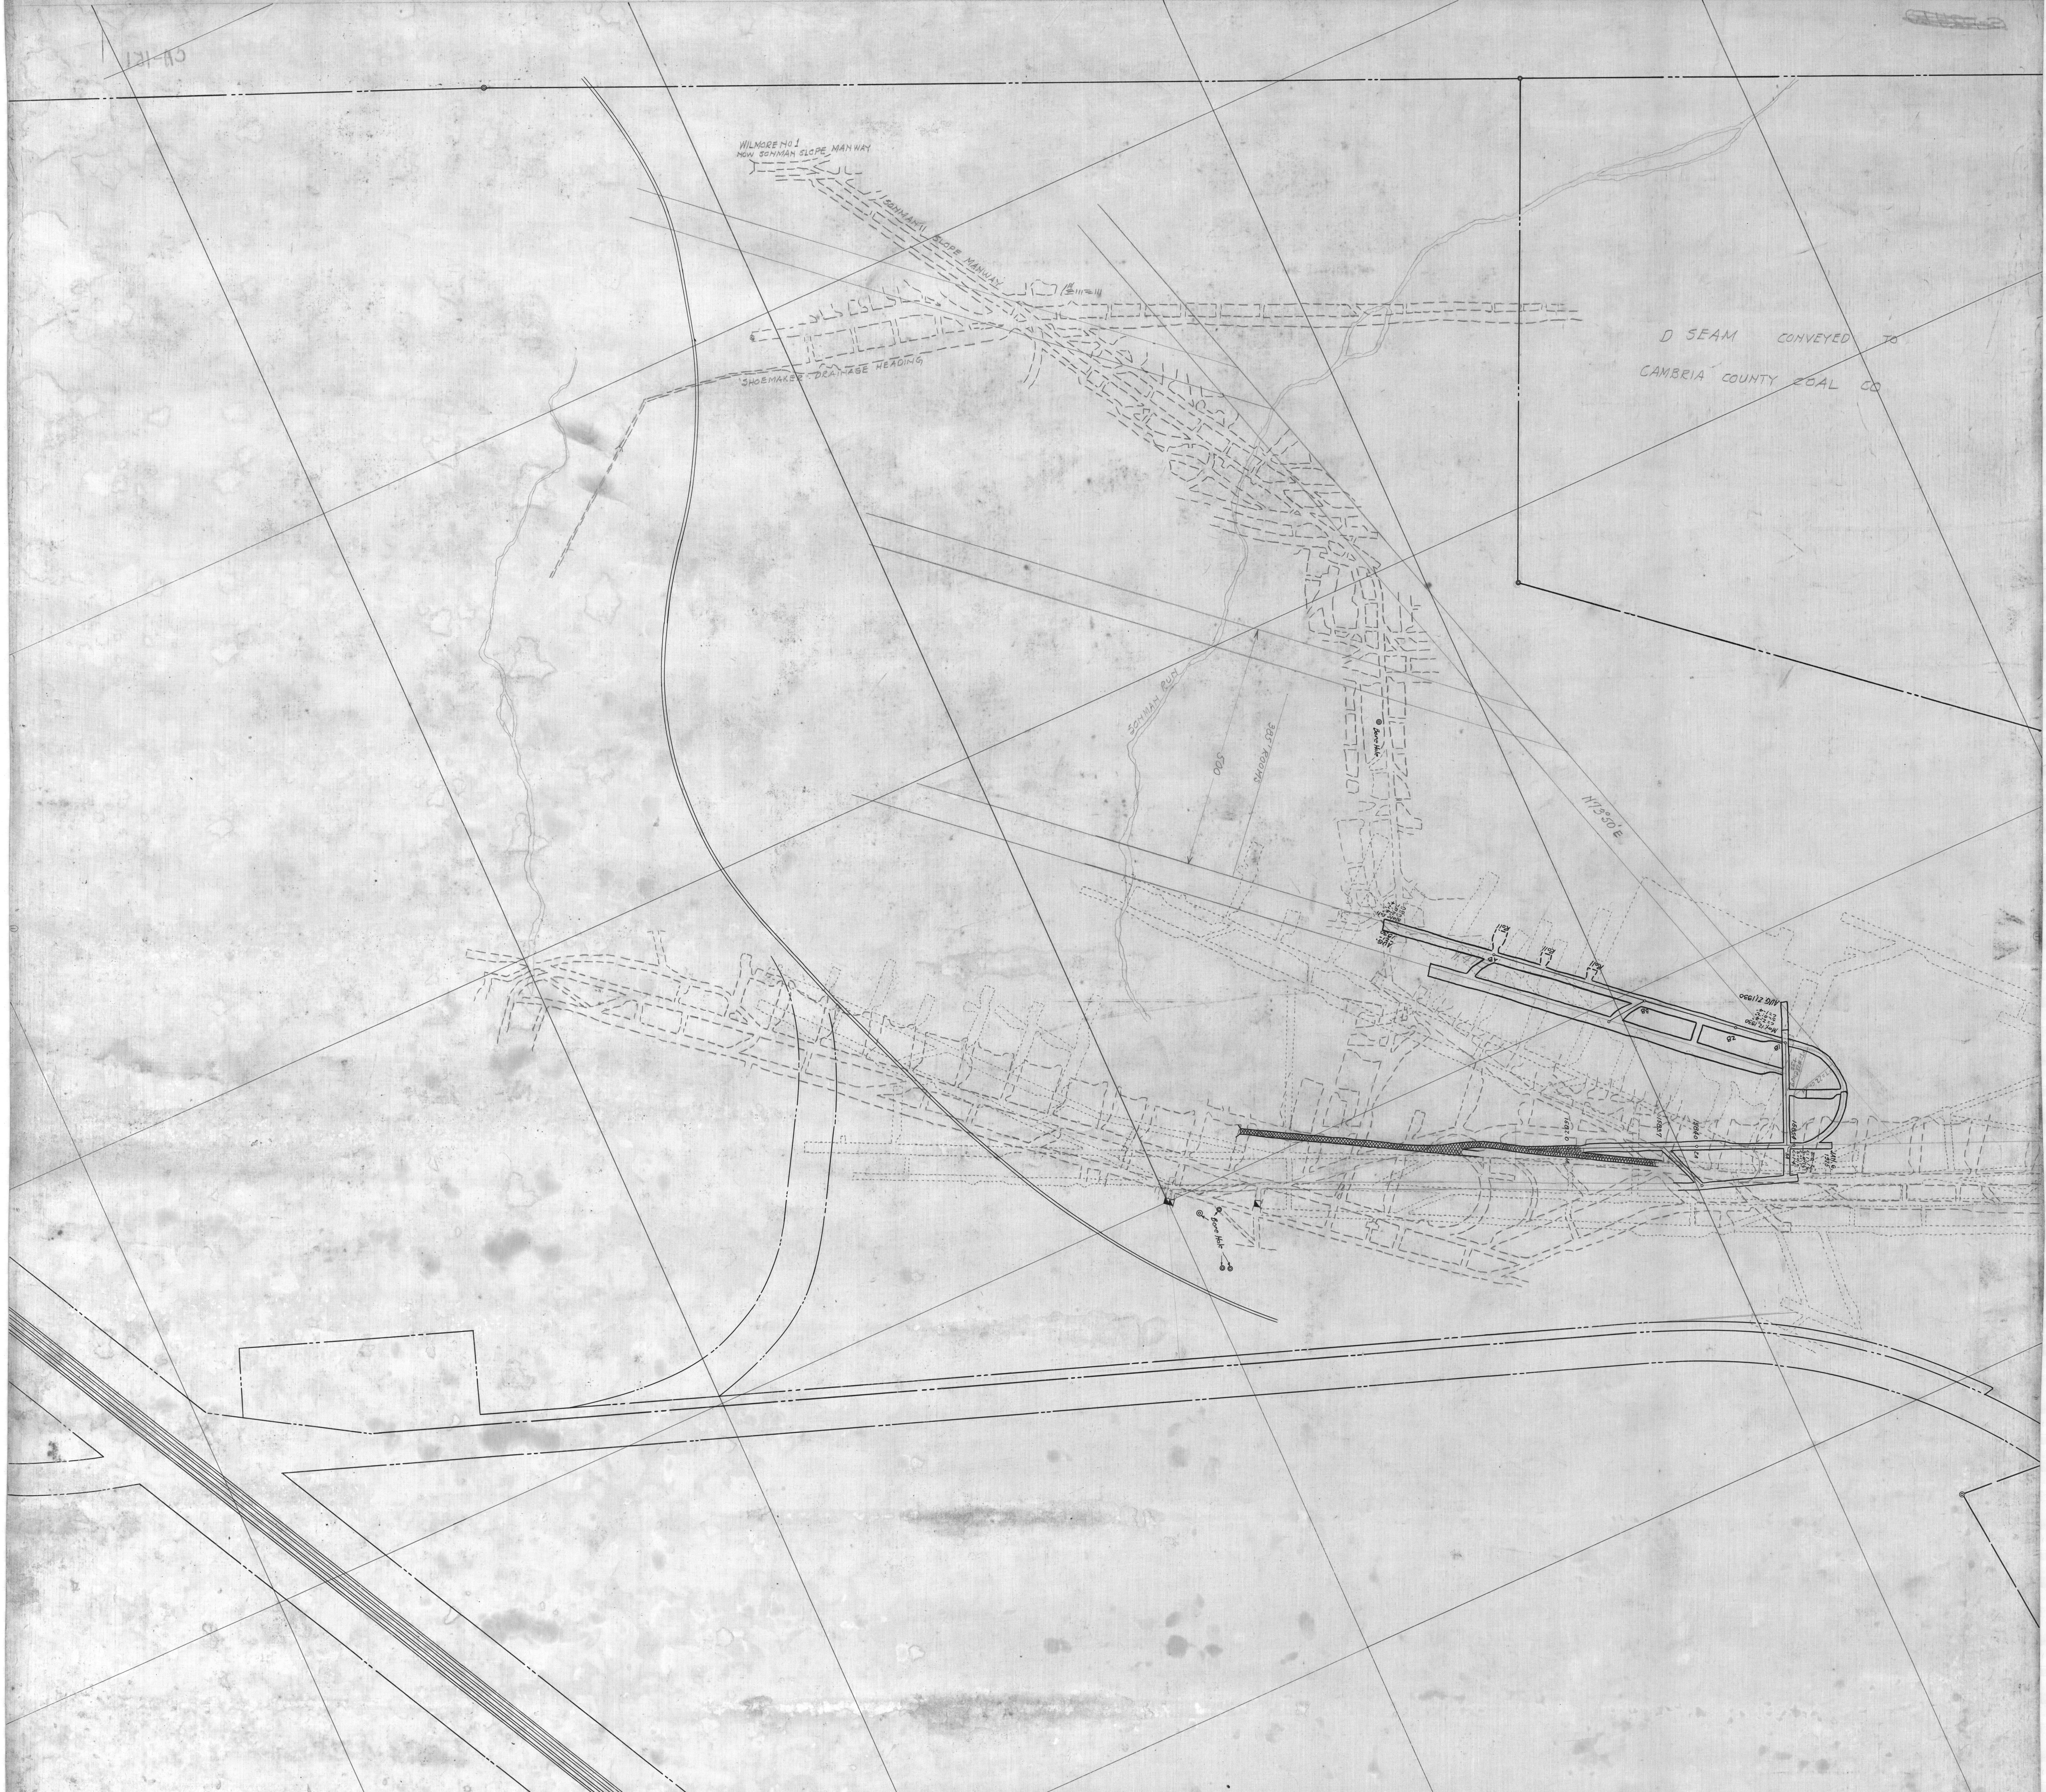
WILMORE NO 1
NOW SONMAN SLOPE MANWAY
SONMAN SLOPE MANWAY
"SHOEMAKER" DRAINAGE HEADING
D SEAM CONVEYED TO
CAMBRIA COUNTY COAL CO
SONMAN RUN
500
385' ROOMS
Bore Hole
N73°50'E
AUG. 21, 1930
Slate Roll
C=2'-4"
S=0'-2"
C=1'-4"
Roll
Roll
Roll
4B
3B
2B
1B
N41
May 12, 1930
AUG. 21, 1930
1582.0
1583.7
1584.0
1585.4
2A
3A
4A
JAN. 6
1935
B=0'-2"
C=1'-4"
T=22 chord
Bore Hole