

CLEARFIELD BITUMINOUS COAL CORPORATION

CLEARFIELD BITUMINOUS COAL CORPORATION  
176.169 ACRES NET  
LEASED TO  
SONMAN SHAFT COAL CO.

J.M. CAMERON, TRUSTEE

J.M. CAMERON, TRUSTEE.  
272.886 ACRES NET  
LEASED TO  
SONMAN SHAFT COAL CO.

SUPPLY CO.  
RESERVOIR OF SUMMIT WATER

CLEARFIELD BITUMINOUS COAL CORPORATION

(LUCY P. SMITH et al.)

SONMAN SHAFT COAL CO.  
(P. RILEY)  
64.029 ACRES

J.M. CAMERON TRUSTEE  
251.097 ACRES  
LEASED TO  
SONMAN SHAFT COAL CO.

TROUT RUN COAL MINING CO.

KINKEAD SURFACE

CLEARFIELD BITUMINOUS COAL CORPORATION  
609.623 ACRES  
LEASED TO  
SONMAN SHAFT COAL CO.

ESTATE OF HENRY M<sup>C</sup>CORMICK  
337.46 ACRES  
LEASED TO  
SONMAN SHAFT COAL CO.

SONMAN SHAFT COAL CO.  
(PAUL NELSON)  
43.7 ACRES

SONMAN SHAFT COAL CO.  
(FRANK MULLEN)  
28.616 ACRES NET

ESTATE OF HENRY M<sup>C</sup>CORMICK

CLEARFIELD BITUMINOUS COAL CORPORATION  
199.83 ACRES NET  
LEASED TO  
SONMAN SHAFT COAL CO.

C.A. HUGHES  
213 ACRES  
LEASED TO  
SONMAN SHAFT COAL CO.

HUGHES AND SHOEMAKER


CAMBRIA COUNTY COAL CO.

CAMBRIA COUNTY COAL CO.  
NOW CAMBRIA M. & M. CO.  
LEASED TO  
SONMAN SHAFT COAL CO.

CAMBRIA M. & M. CO.  
LEASED TO  
SONMAN SHAFT COAL CO.

C.M. & M. CO.  
LEASED TO  
SONMAN SHAFT COAL CO.

C.M. & M. CO.  
LEASED TO  
S.S.C. CO.

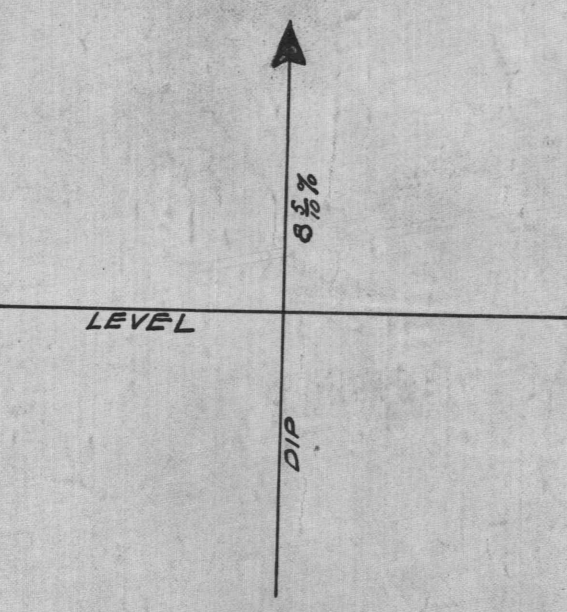

MAP SHOWING LEASEHOLDS AND OWNERSHIPS OF THE SONMAN SHAFT COAL CO. IN THE 'C PRIME' OR UPPER KITTANNING SEAM

PORTAGE AND SUMMERHILL TOWNSHIPS, CAMBRIA COUNTY PA.  
SCALE=1"=400'

JOS. S. SULLIVAN & CO. ENGINEERS, ALTOONA, PA.

WORKINGS SHOWN TO MAY 15 1930. C7H20-4

MINING 962 ACRES LEASED TO SONMAN SHAFT COAL CO. MANUFACTURING CO.