
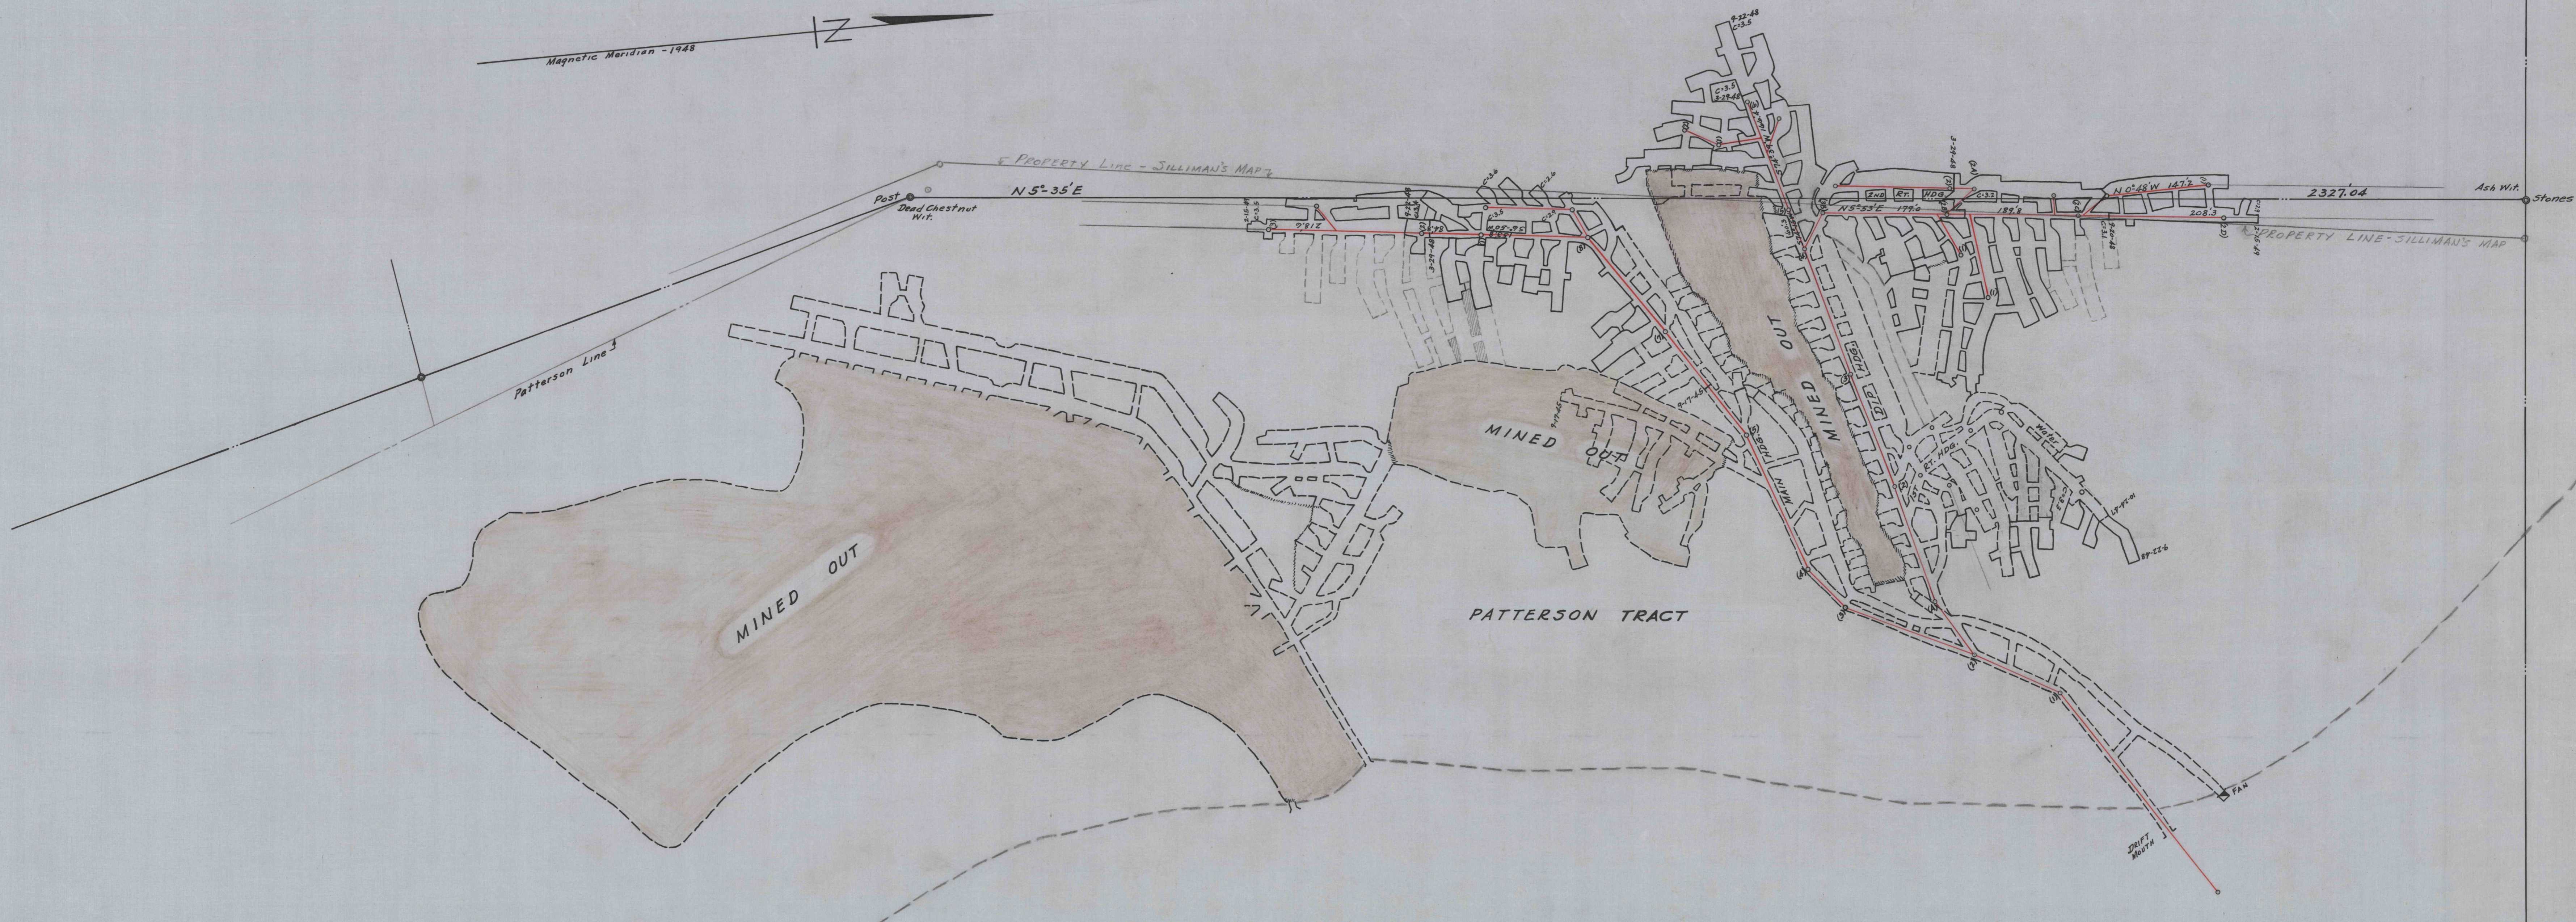


STEVENS TRACT

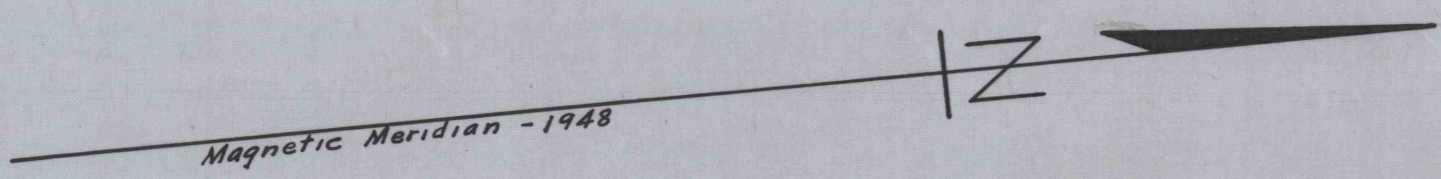

MAP SHOWING MINING OPERATIONS
 OF THE
 RICHLAND COAL CO.
 UPPER KITTANNING SEAM
 IN THE TRACTS OF
MARION D. & GEO. M. PATTERSON AND A.A. STEVENS EST.
 SITUATE IN
 DEAN TWP., CAMBRIA CO., PA.
 SCALE: 1" = 100' OCT. 6, 1948
 A. CALVIN GALBRAITH, PROFESSIONAL ENGINEER
 JOHNSTOWN, PA.