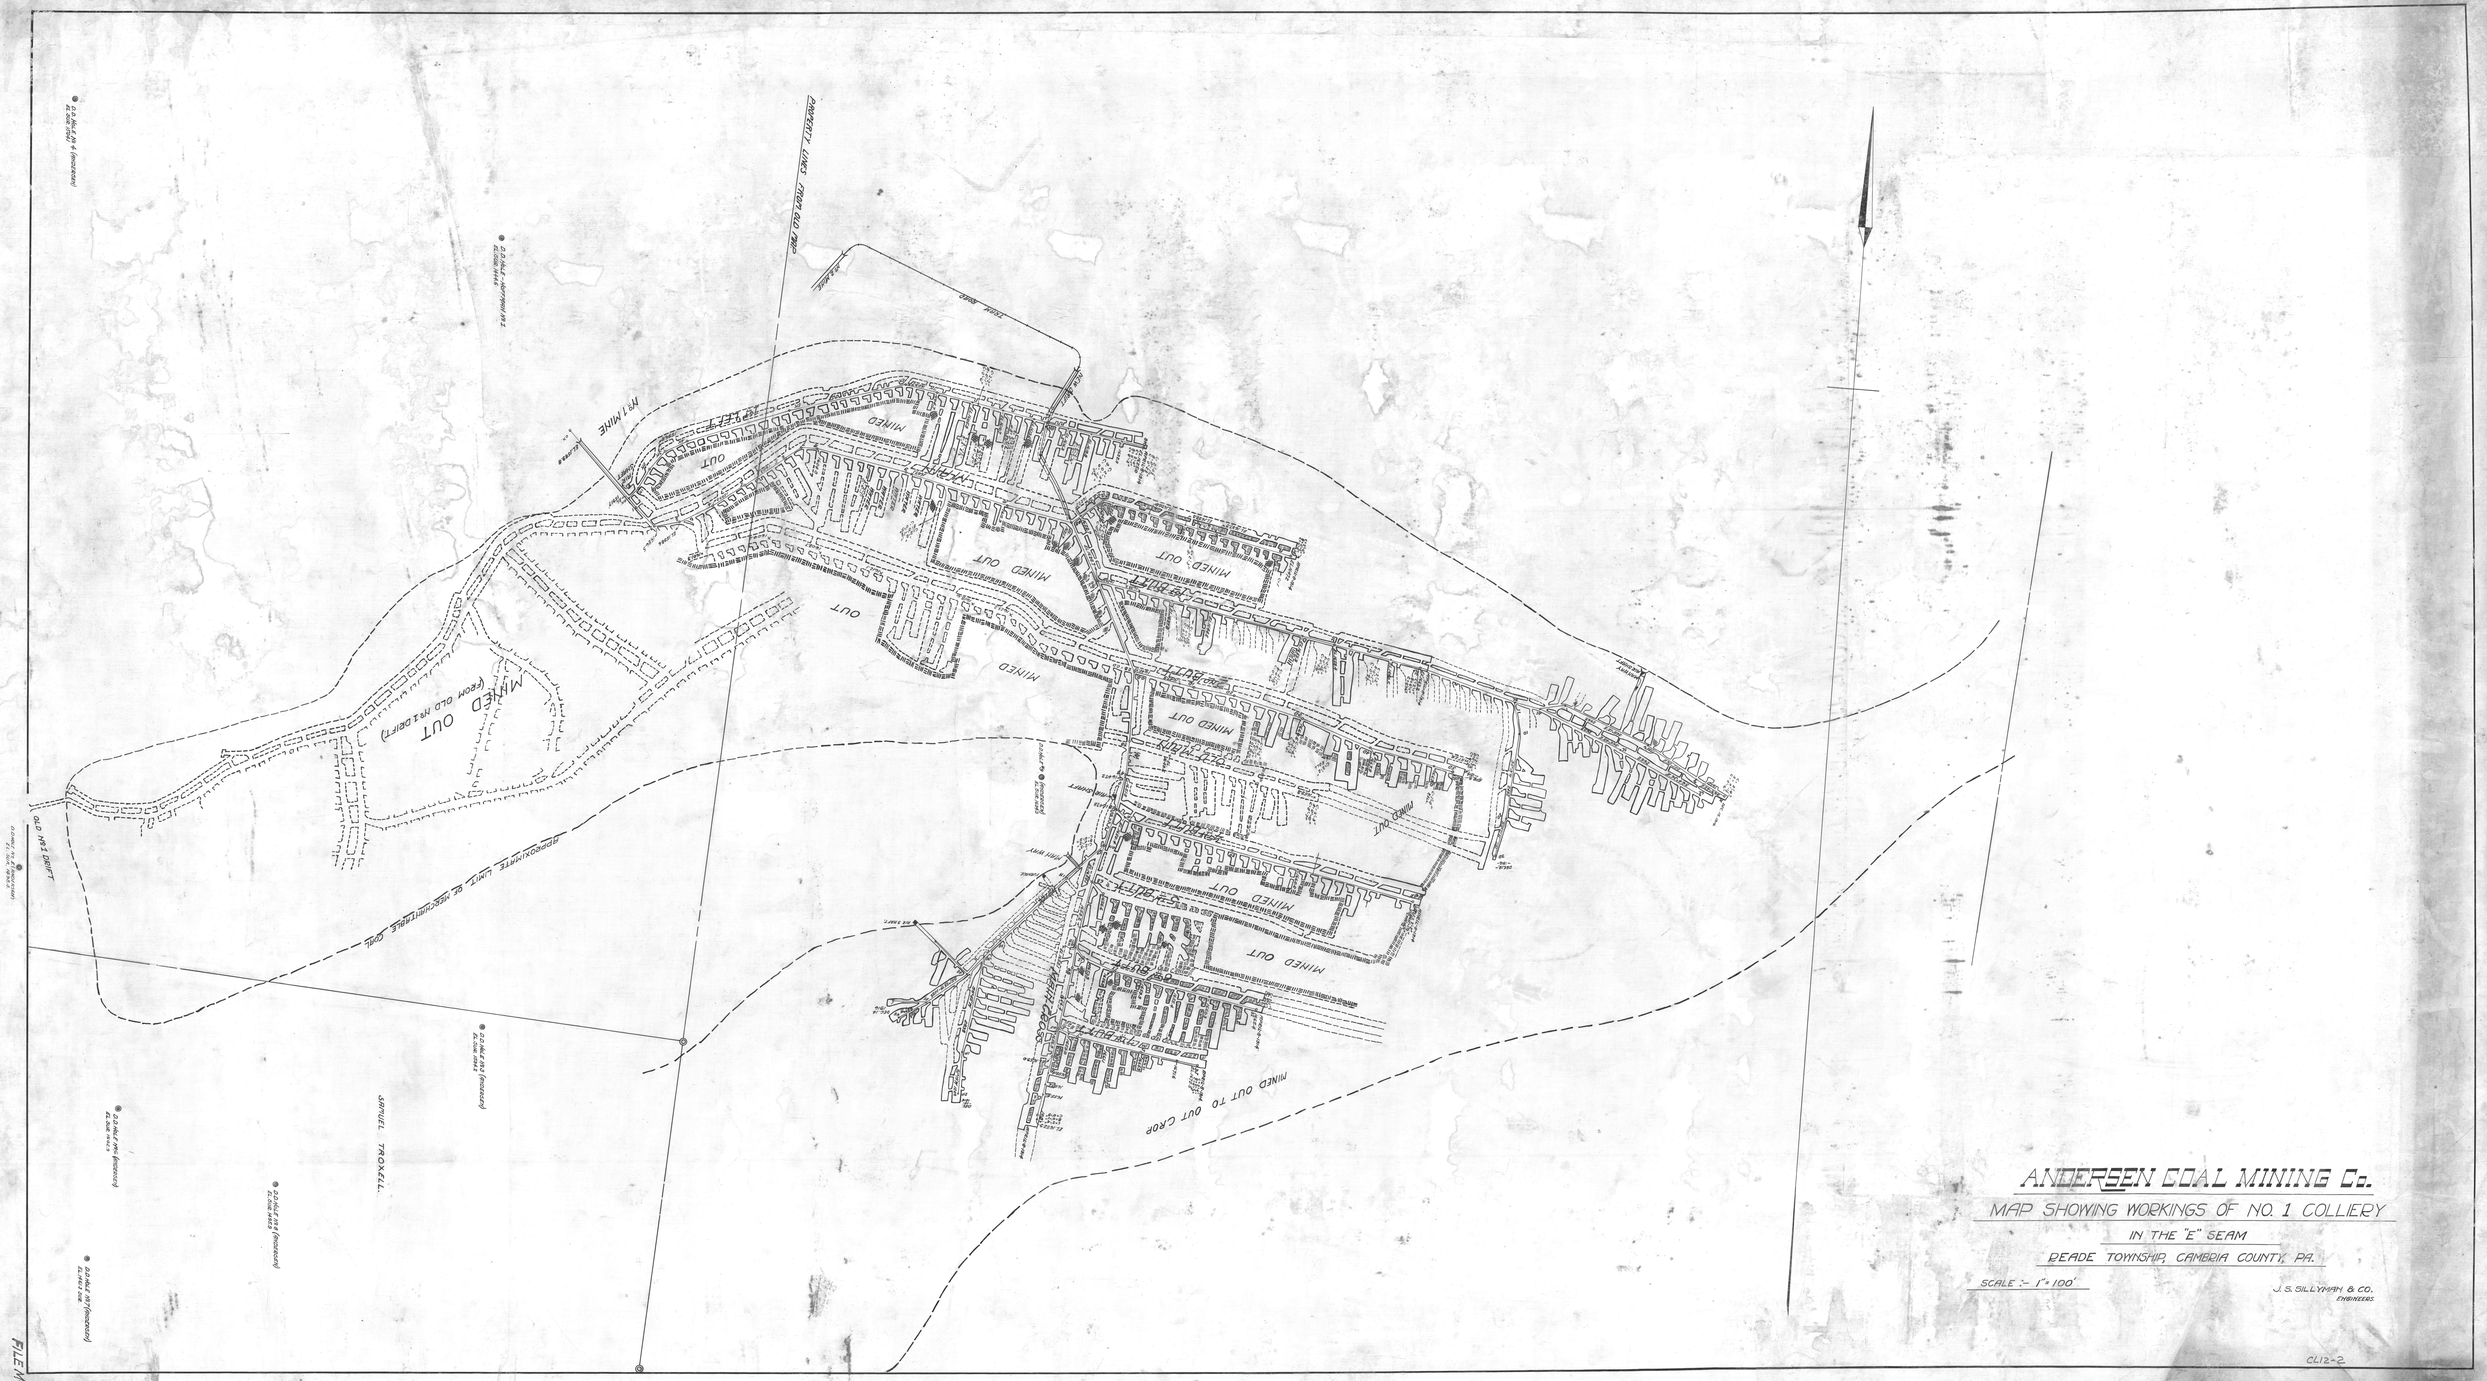
ANDERSEN COAL MINING Co.
MAP SHOWING WORKINGS OF NO. 1 COLLIERY
IN THE "E" SEAM
BEADE TOWNSHIP, CAMBRIA COUNTY, PA.
SCALE :- 1" = 100'
J. S. SILLYMAN & CO.
ENGINEERS
CL12-2
MINED OUT
MINED OUT TO OUT CROP
NO. 1 MINE
JAMUEL TROXELL
APPROXIMATE LIMIT OF RECOVERABLE COAL
MINED OUT
(From OLD No. 1 DEPT.)

FILE M-4