


MAP OF MINES, NO. 394  
 OF THE  
**ANDERSEN COAL MINING CO.**  
 FALLEN TIMBER, CAMBRIA CO., PA.  
 MAY 3<sup>RD</sup> 1912 CHARLES E. WALKER.  
 SCALE 1" = 100 FT.

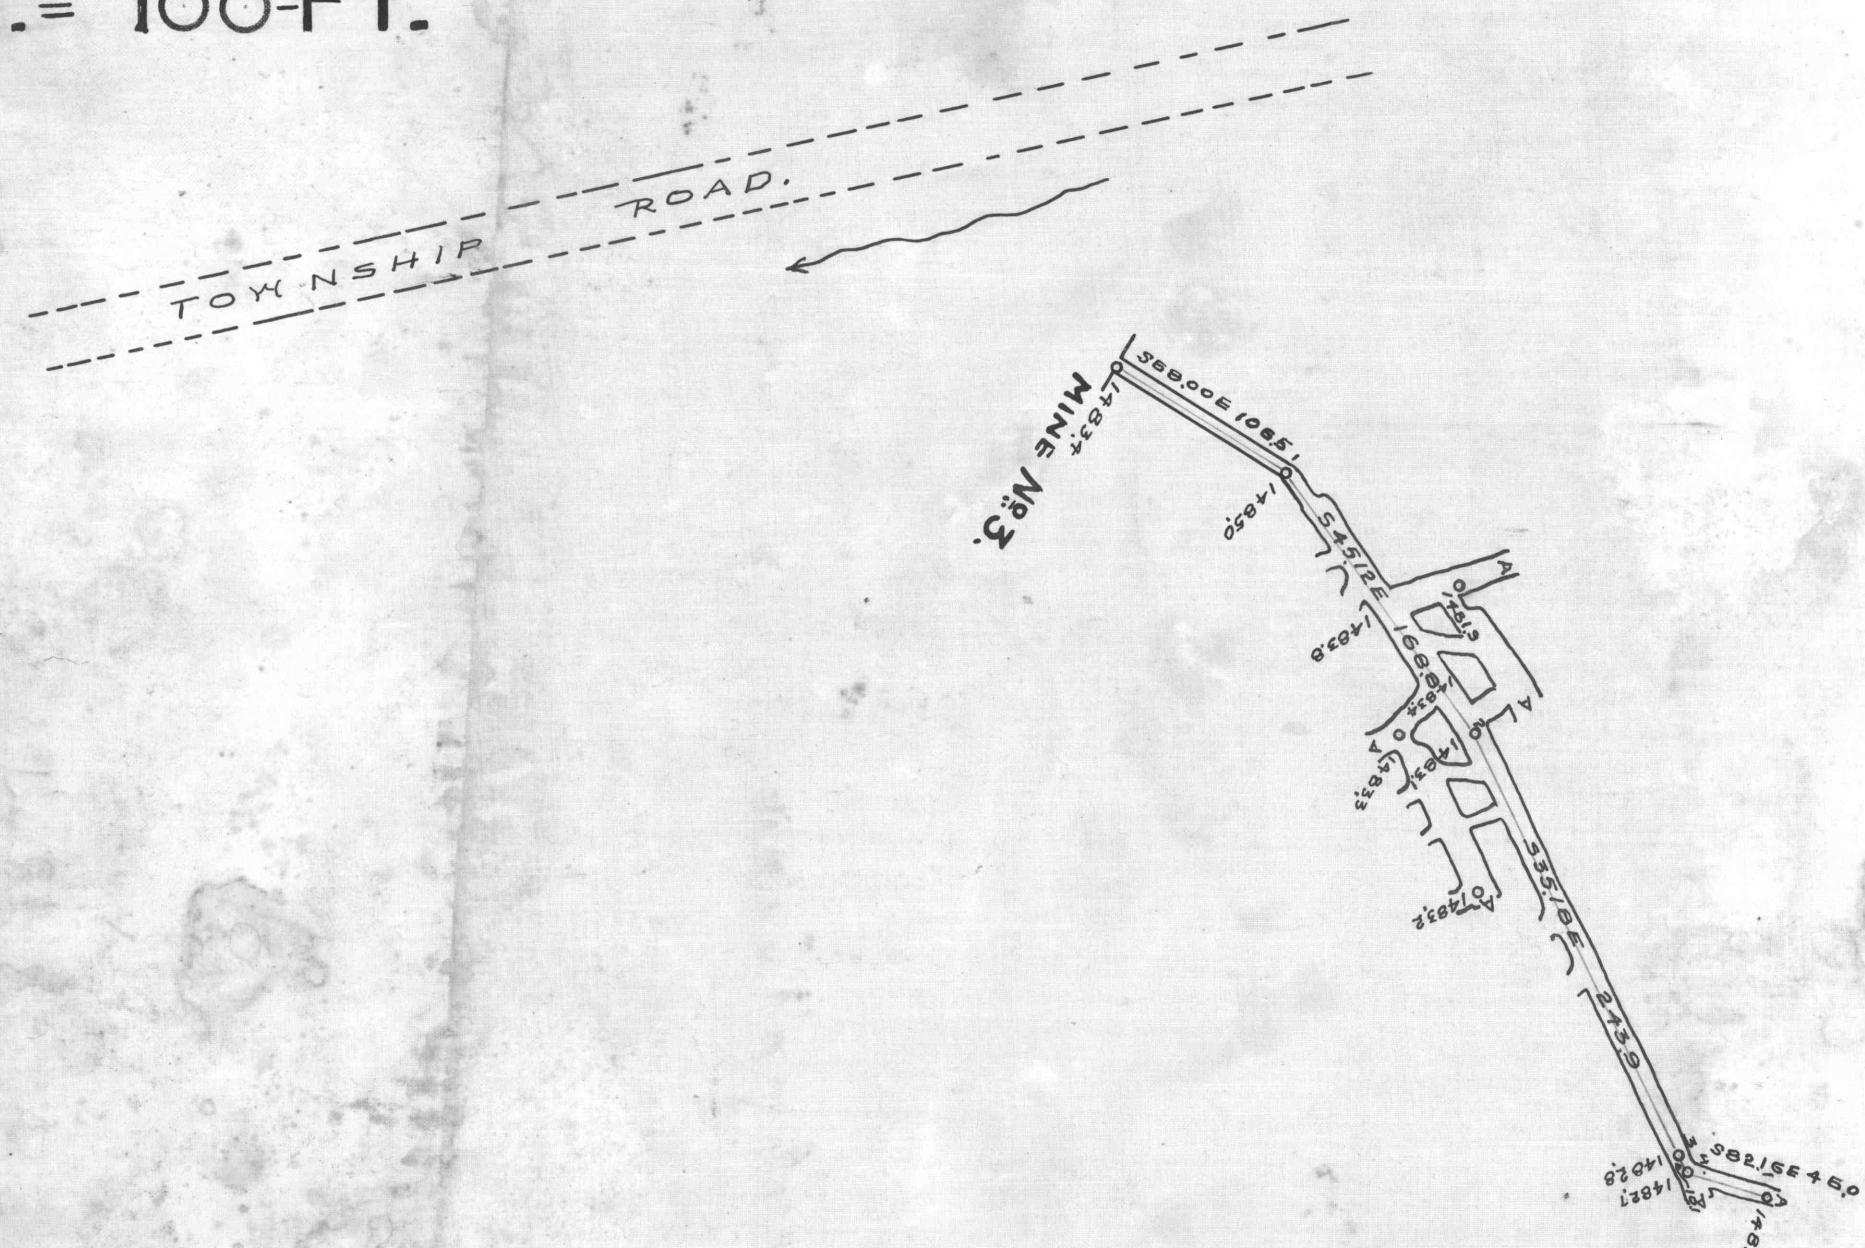

LEGEND  
 SURVEY OF APRIL 1912. LETTER 'A'.