


3183

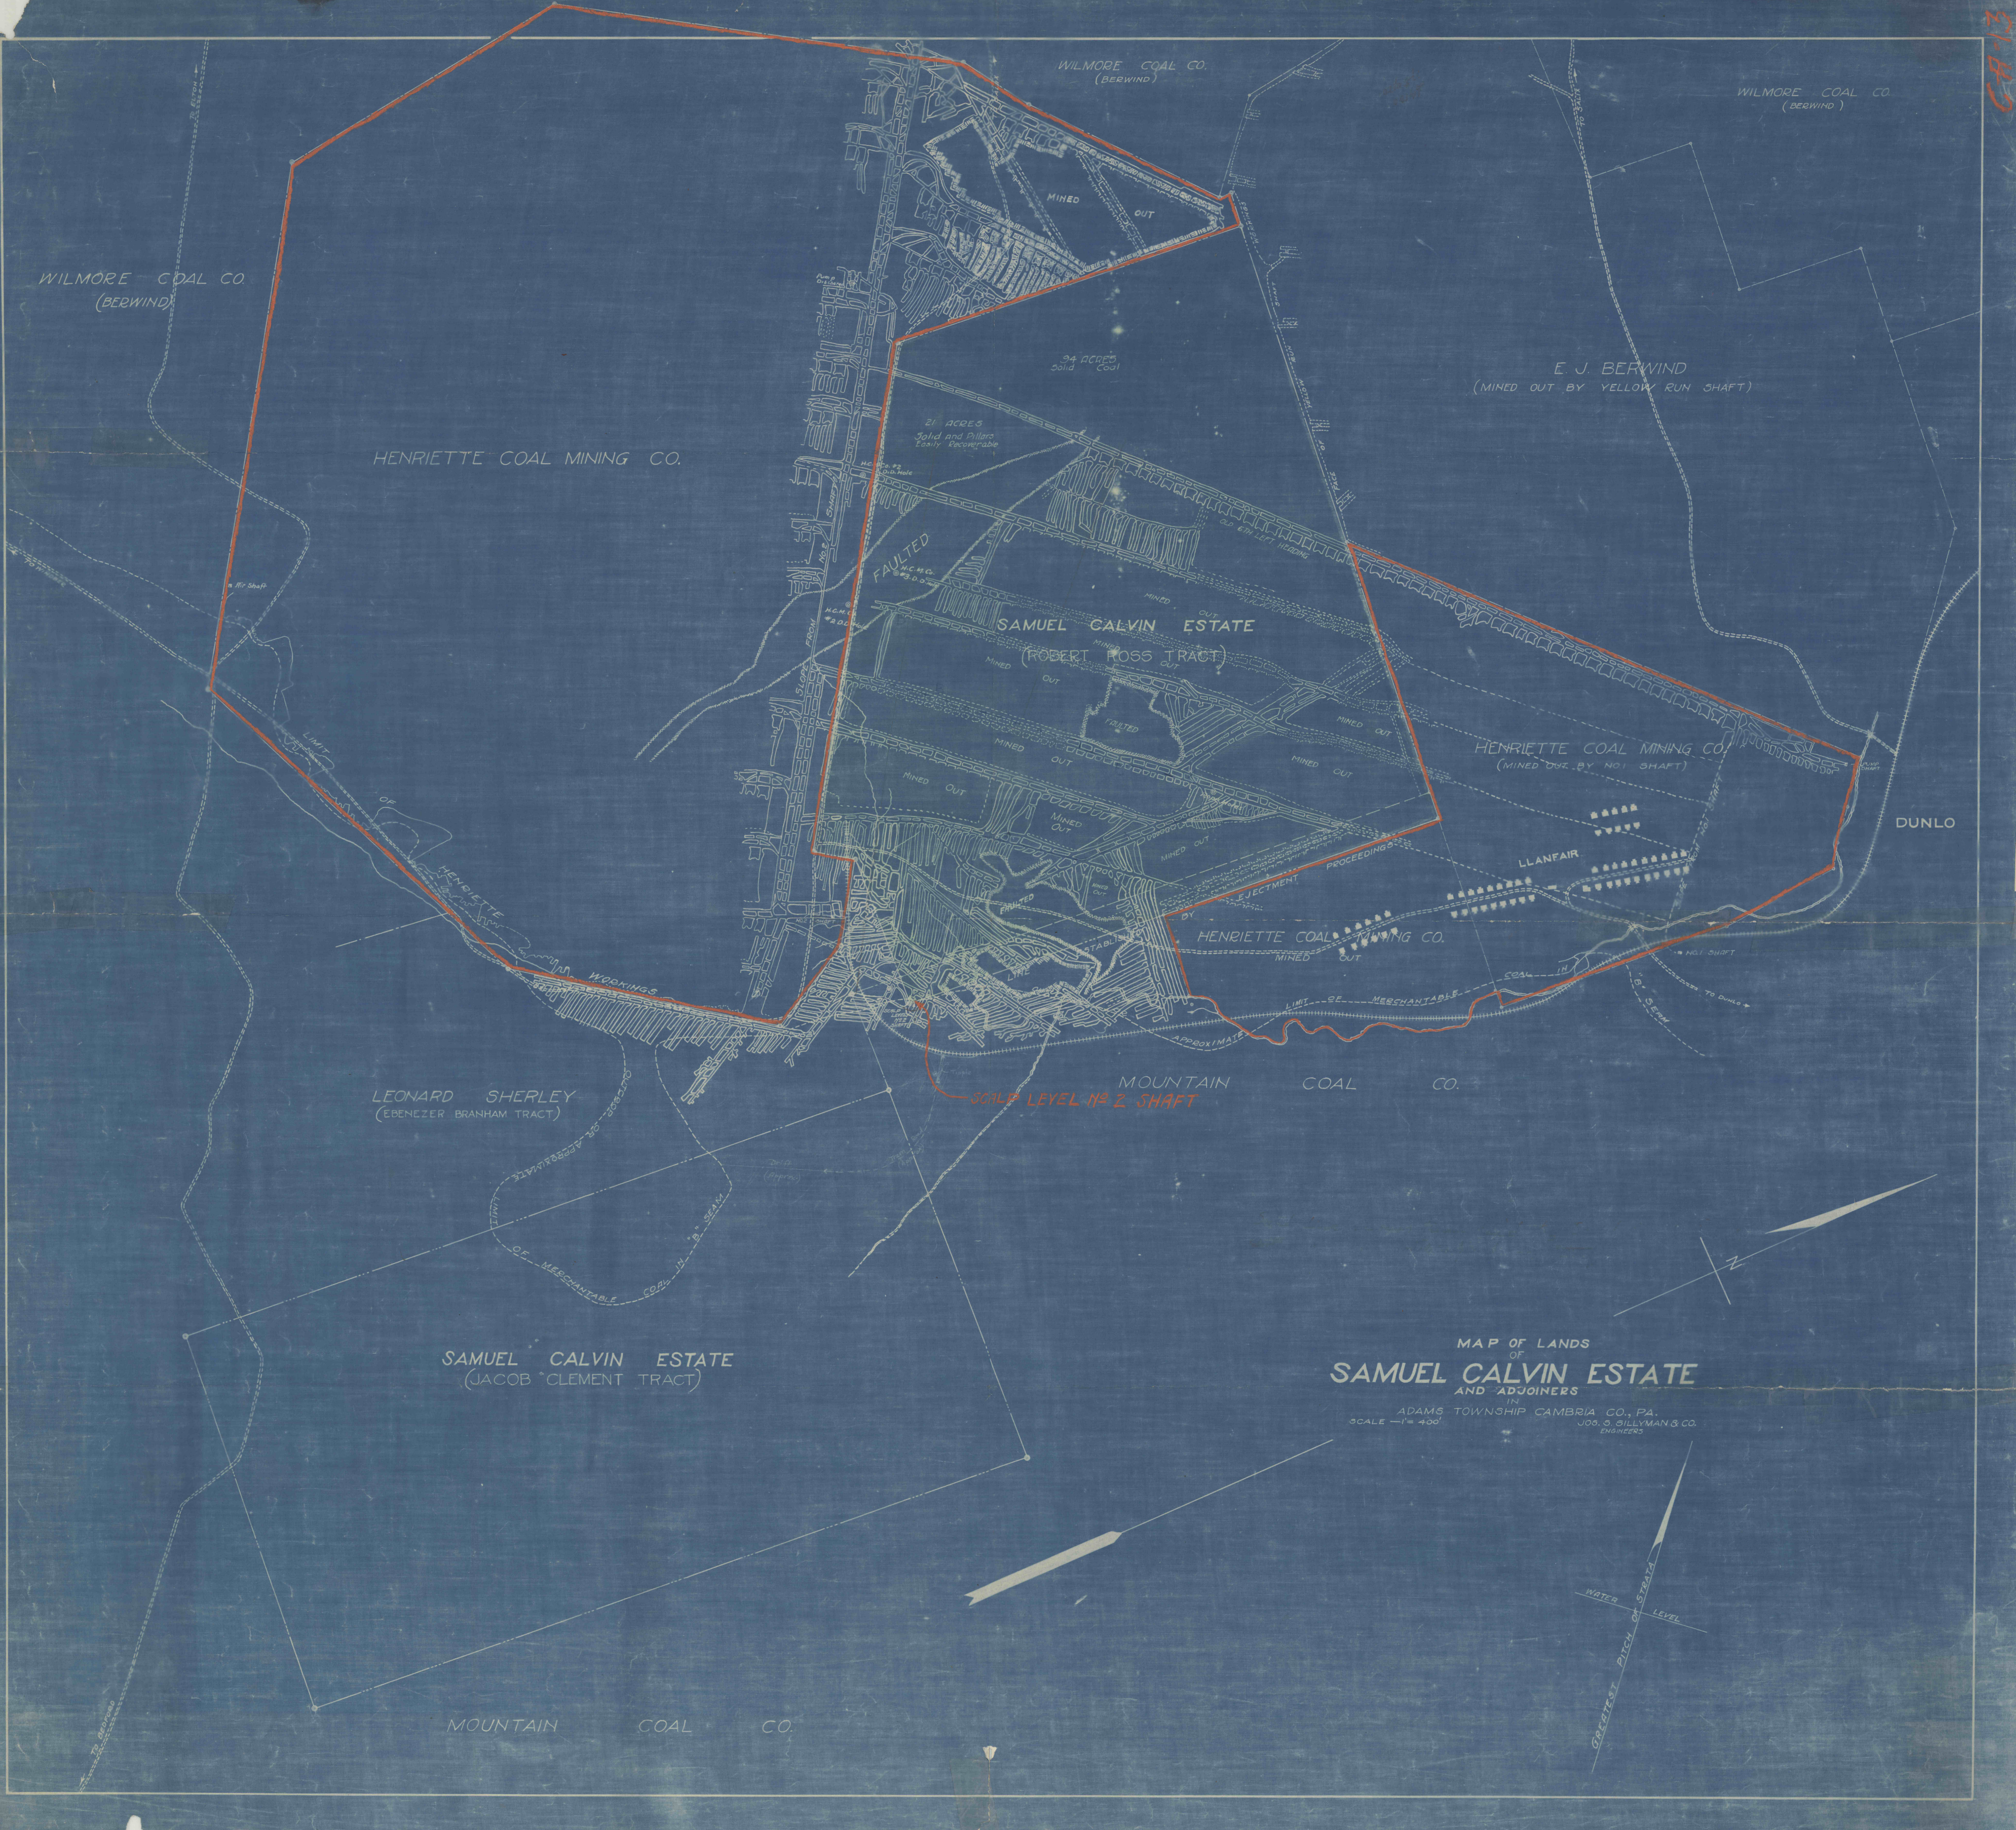

WILMORE COAL CO.  
(BERWIND)

WILMORE COAL CO.  
(BERWIND)

WILMORE COAL CO.  
(BERWIND)

HENRIETTE COAL MINING CO.

E. J. BERWIND  
(MINED OUT BY YELLOW RUN SHAFT)

21 ACRES  
Solid and Pillars  
Easily Recoverable

94 ACRES  
Solid Coal

FAULTED

SAMUEL CALVIN ESTATE

(ROBERT ROSS TRACT)

HENRIETTE COAL MINING CO.  
(MINED OUT BY NO. 1 SHAFT)

DUNLO

LEONARD SHERLEY  
(EBENEZER BRANHAM TRACT)

MOUNTAIN COAL CO.

SLOPE LEVEL NO. 2 SHAFT

SAMUEL CALVIN ESTATE  
(JACOB CLEMENT TRACT)

MAP OF LANDS  
OF  
**SAMUEL CALVIN ESTATE**  
AND ADJOINERS

IN  
ADAMS TOWNSHIP CAMBRIA CO., PA.  
SCALE - 1" = 400'  
JOS. S. SILLIMAN & CO.  
ENGINEERS

MOUNTAIN COAL CO.

WATER  
LEVEL  
GREATEST PITCH OF STRATA