


BENNIX LEASE

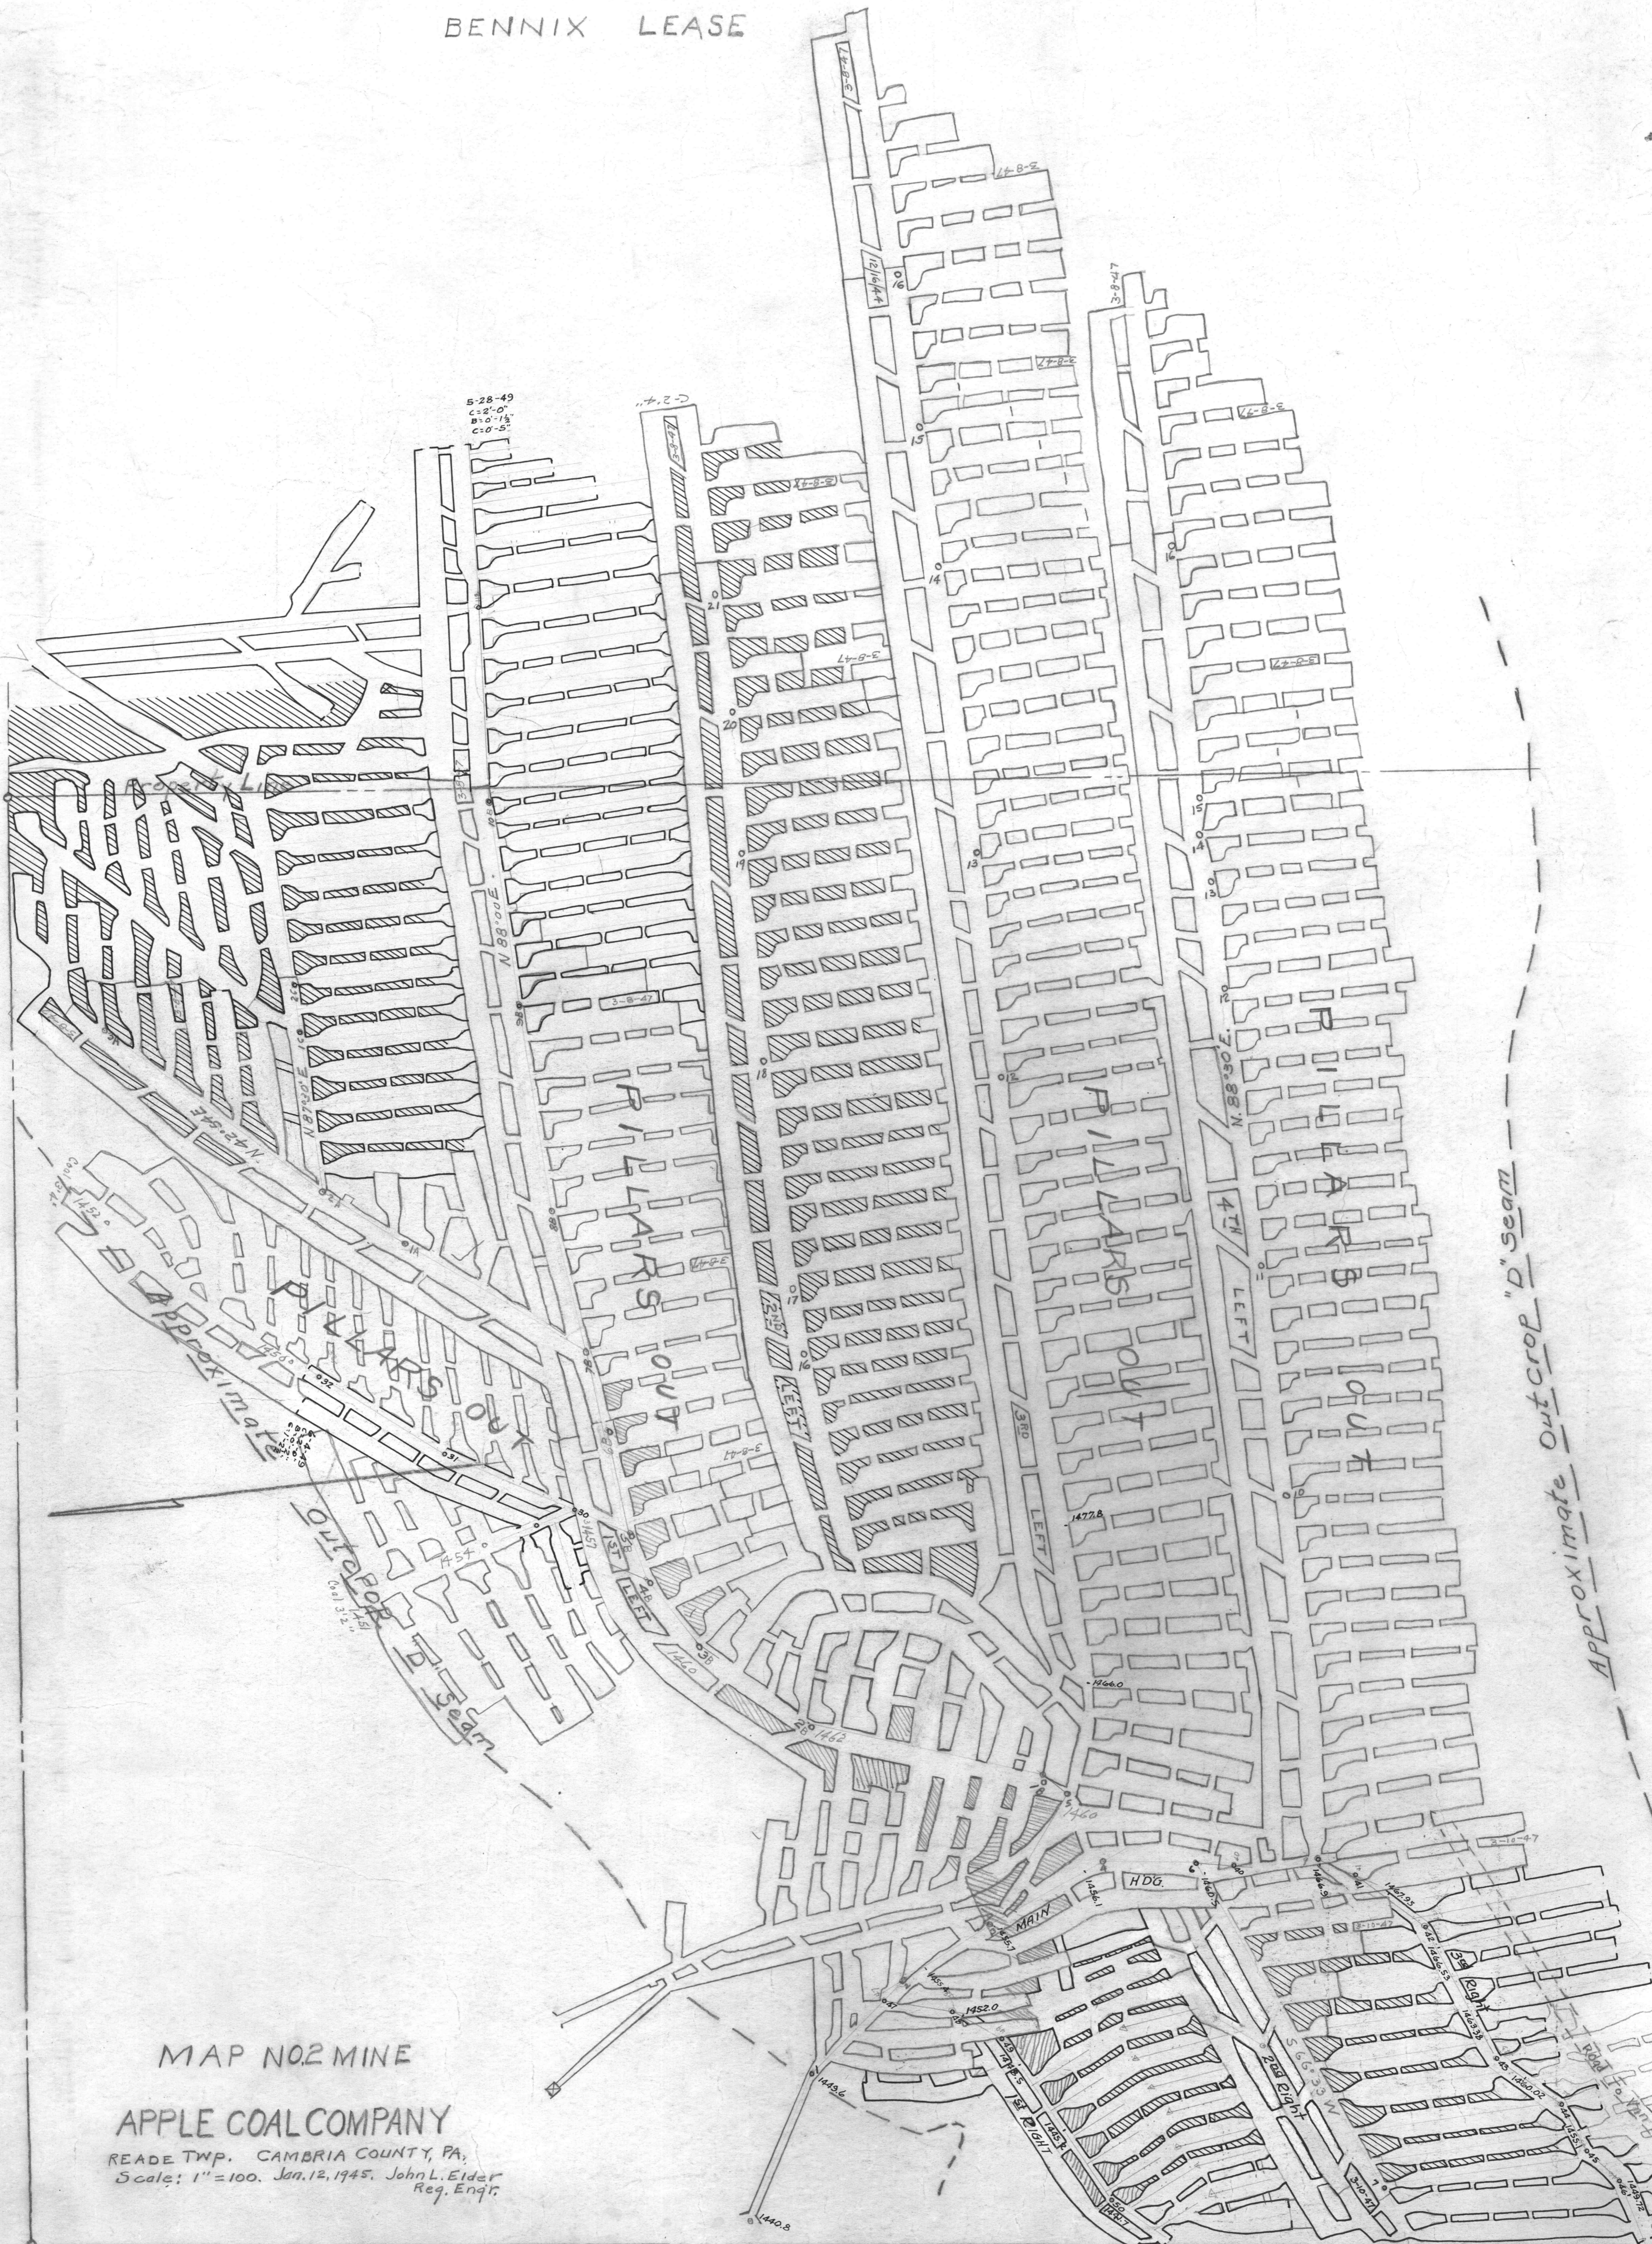

MAP NO. 2 MINE

APPLE COAL COMPANY

READE TWP. CAMBRIA COUNTY, PA.
Scale: 1"=100. Jan. 12, 1945. John L. Eider
Reg. Engr.

SARAH M. TROXELL

HOLLEN TRACT

APPROXIMATE OUTCROP "D" SEAM

6-4-49
C-2-67
8-0-13
C-1-13