


ROY BURKHART


U.H. CROOK

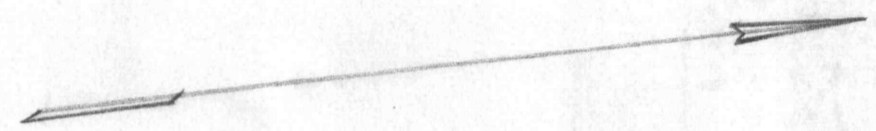

M.00.S99 S 65.00' E



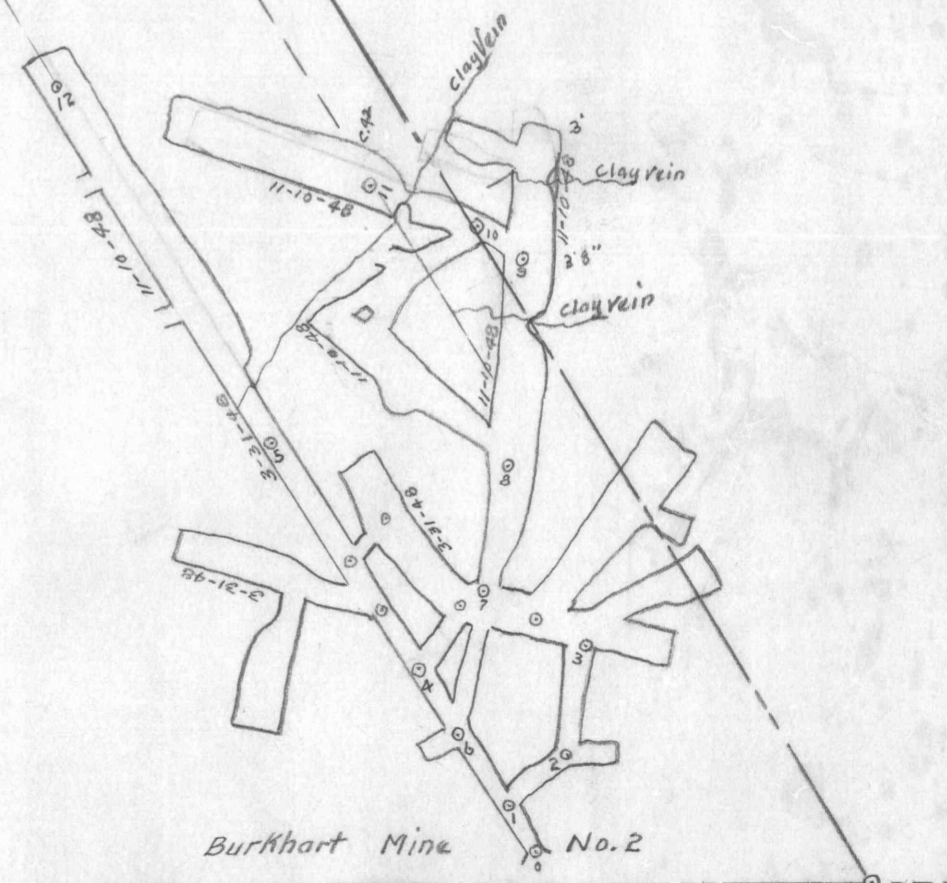

N 6°00' E

MAP OF
ROY BURKHART MINE No. 2
DYSART PA
Scale 1"=100' John L. Elder
Reg. Engr.