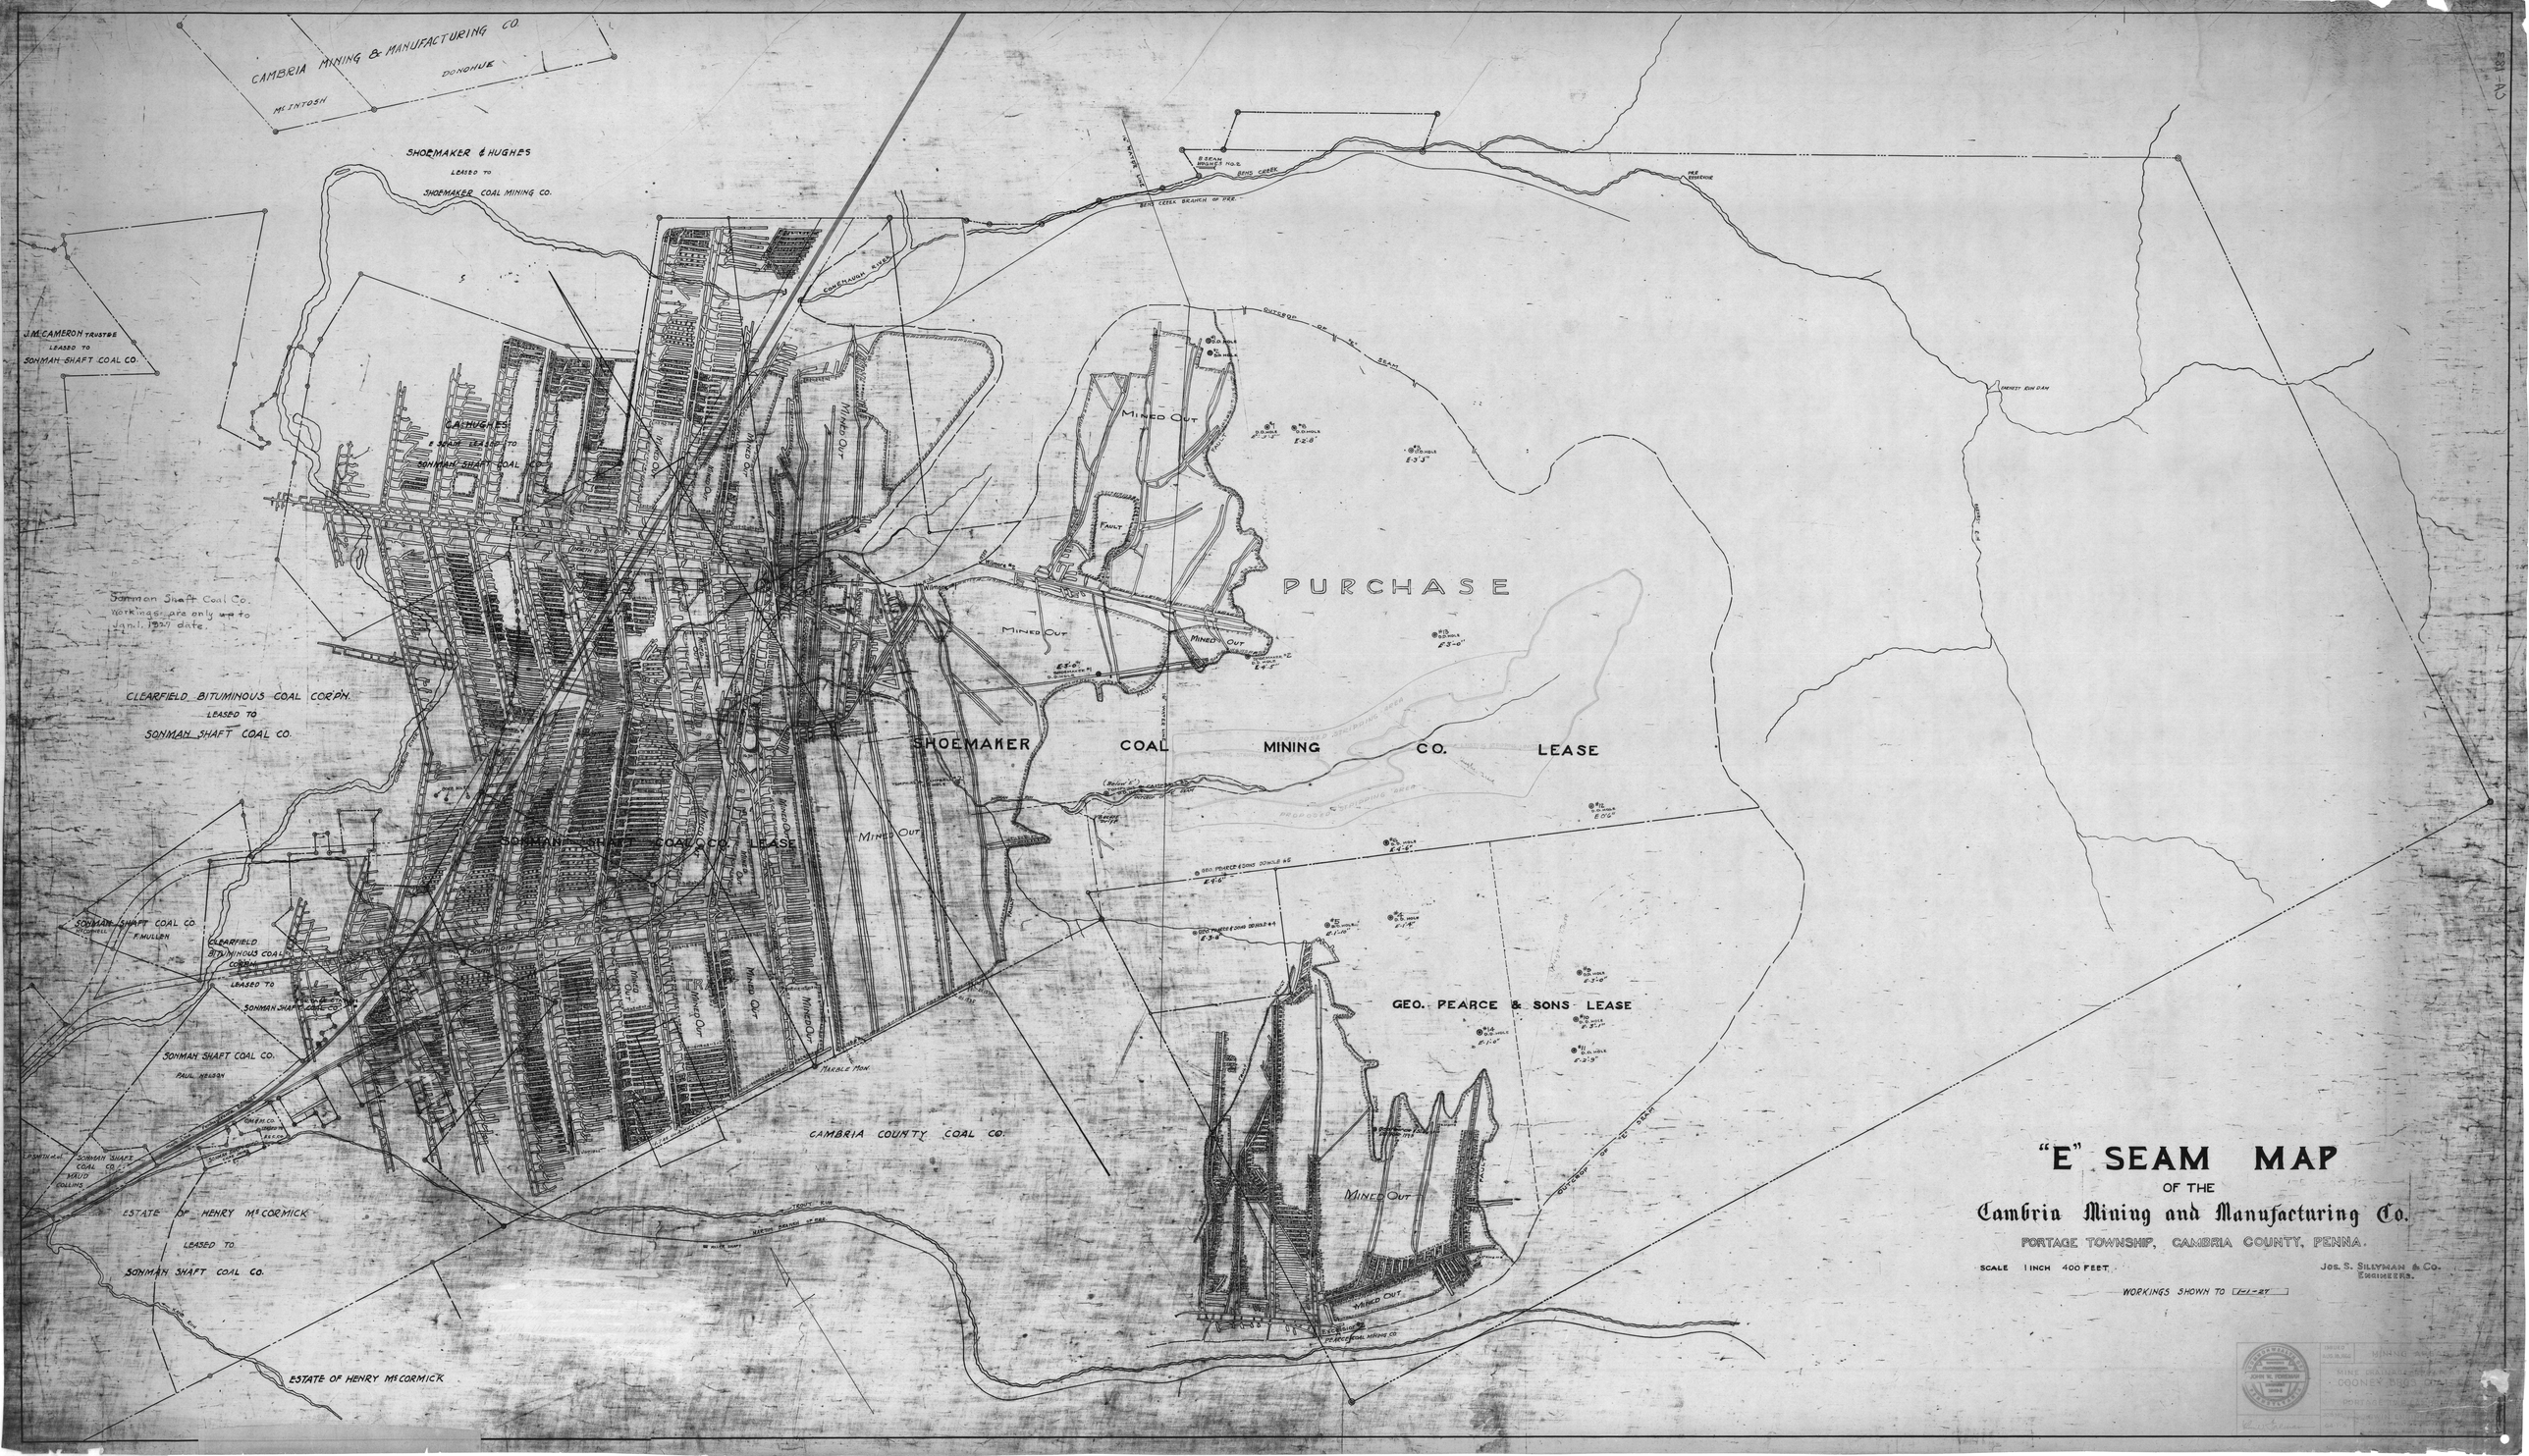
CAMBRIA MINING & MANUFACTURING CO.
McINTOSH
DONOHUE
SHOEMAKER & HUGHES
LEASED TO
SHOEMAKER COAL MINING CO.
J.M. CAMERON TRUSTEE
LEASED TO
SONMAN SHAFT COAL CO.
C.A. HUGHES
E SEAM LEASED TO
SONMAN SHAFT COAL CO.
Sonman Shaft Coal Co.
Workings are only up to
Jan. 1, 1927 date.
CLEARFIELD BITUMINOUS COAL CORP'N.
LEASED TO
SONMAN SHAFT COAL CO.
SONMAN SHAFT COAL CO.
F. MULLEN
CLEARFIELD BITUMINOUS COAL CORP'N.
LEASED TO
SONMAN SHAFT COAL CO.
SONMAN SHAFT COAL CO.
PAUL NELSON
SONMAN SHAFT COAL CO.
MAUD COLLINS
ESTATE OF HENRY McCORMICK
LEASED TO
SONMAN SHAFT COAL CO.
ESTATE OF HENRY McCORMICK
CAMBRIA COUNTY COAL CO.
MARBLE MON.
MINED OUT
FAULT
PURCHASE
SHOEMAKER COAL MINING CO. LEASE
GEO. PEARCE & SONS LEASE
OUTCROP OF "E" SEAM
BENS CREEK
BENS CREEK BRANCH OF PRR.
CONEMAUGH RIVER
"E" SEAM MAP
OF THE
Cambria Mining and Manufacturing Co.
PORTAGE TOWNSHIP, CAMBRIA COUNTY, PENNA.
SCALE 1 INCH 400 FEET
JOS. S. SILLYMAN & CO.
ENGINEERS.
WORKINGS SHOWN TO 1-1-27
MINING AREA
MINE DRAINAGE
COONEY BROS. COAL
PORTAGE TWP.
JOHN W. FOREMAN
ISSUED
AUG. 18, 1926
MINING AREA
MINE DRAINAGE
COONEY BROS. COAL
PORTAGE TWP.
JOSHUA WINSLOW
CAMBRIA CO.
PENNA.