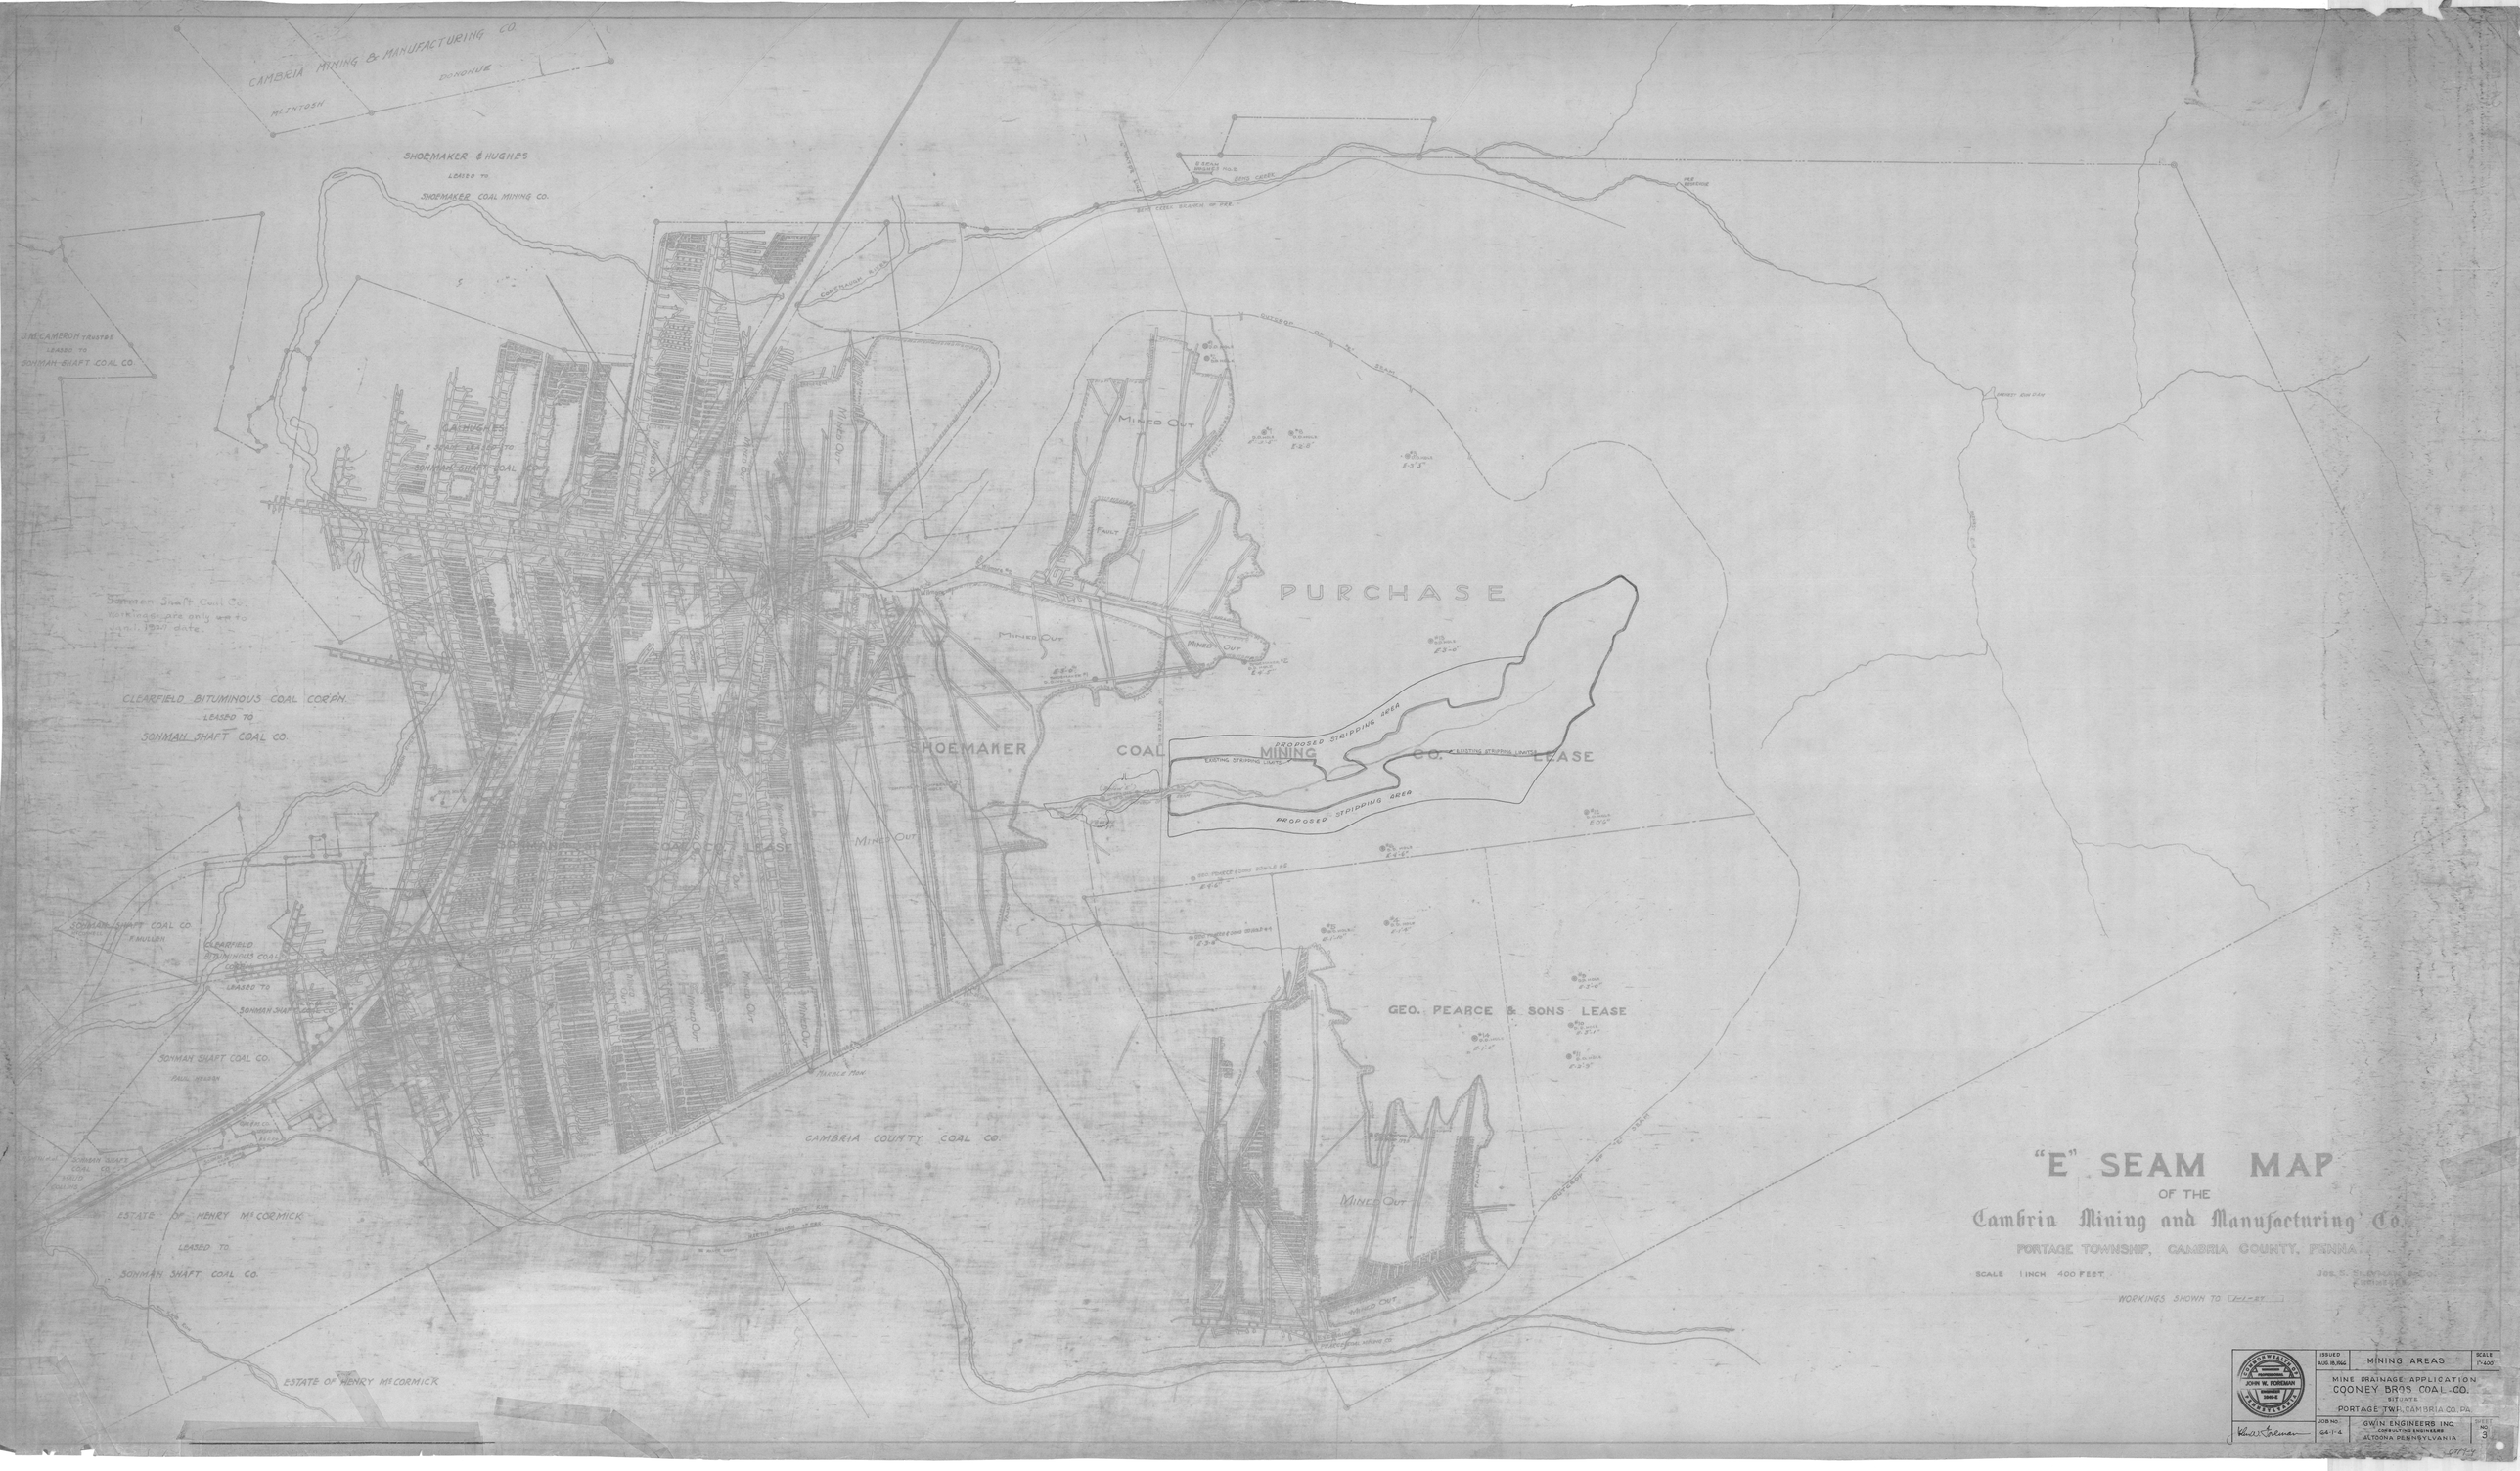
CAMBRIA MINING & MANUFACTURING CO.
DONOHUE
McINTOSH
SHOEMAKER & HUGHES
LEASED TO
SHOEMAKER COAL MINING CO.
J.M. CAMERON TRUSTEE
LEASED TO
SONMAN SHAFT COAL CO.
Sonman Shaft Coal Co.
Workings are only up to
Jan'l. 1927 date.
CLEARFIELD BITUMINOUS COAL CORP'N.
LEASED TO
SONMAN SHAFT COAL CO.
PURCHASE
MINED OUT
FAULT
SHOEMAKER COAL MINING CO. LEASE
PROPOSED STRIPPING AREA
EXISTING STRIPPING LIMITS
GEO. PEARCE & SONS LEASE
CAMBRIA COUNTY COAL CO.
ESTATE OF HENRY McCORMICK
LEASED TO
SONMAN SHAFT COAL CO.
ESTATE OF HENRY McCORMICK
"E" SEAM MAP
OF THE
Cambria Mining and Manufacturing Co.
PORTAGE TOWNSHIP, CAMBRIA COUNTY, PENNA.
SCALE 1 INCH 400 FEET
WORKINGS SHOWN TO 1-1-27
COMMONWEALTH OF PENNSYLVANIA
JOHN W. FOREMAN
ISSUED AUG. 18, 1966
MINING AREAS
SCALE 1"=400'
MINE DRAINAGE APPLICATION
COONEY BROS COAL CO.
SITUATE
PORTAGE TWP. CAMBRIA CO. PA.
JOB NO. 64-1-4
GWIN ENGINEERS INC.
CONSULTING ENGINEERS
ALTOONA PENNSYLVANIA
SHEET NO. 3