


W. H. PIPER & CO. (IGNATIUS ADAMS WARRANT.)

HANMAN & RICHARDS.
(LAUGHMAN & MENTZER TRACT.)

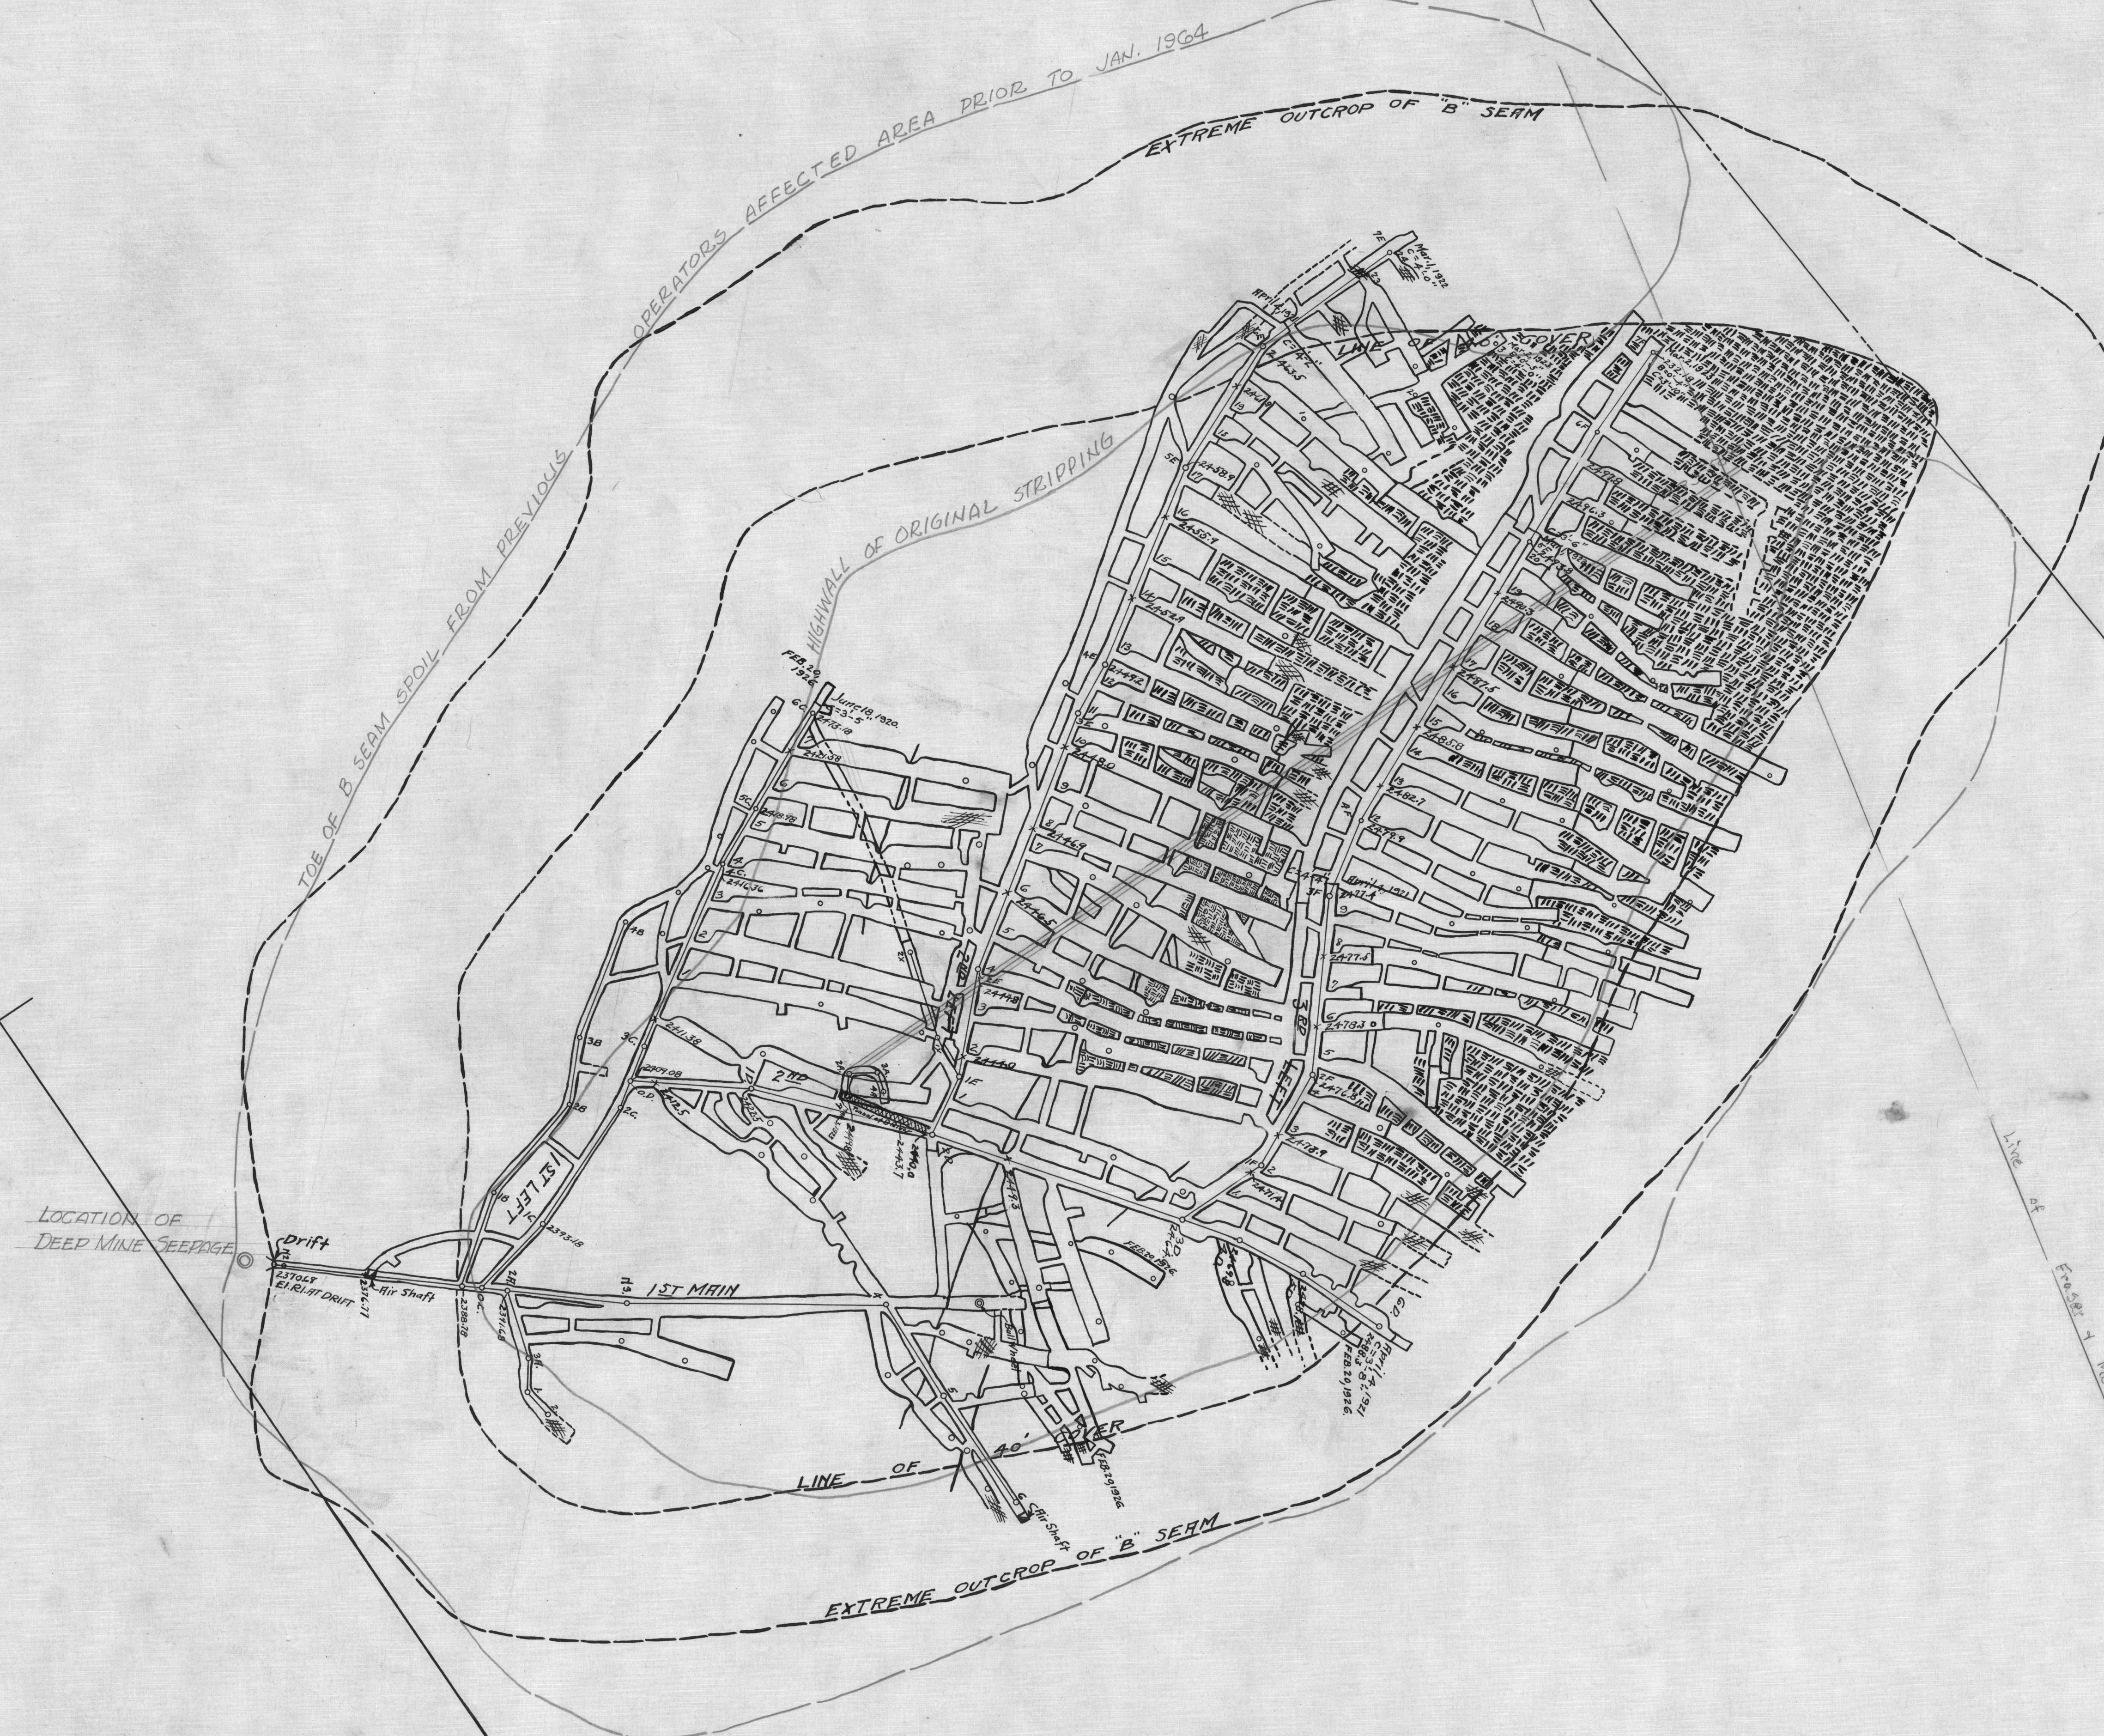

BEAR ROCK COAL CO.
MAP SHOWING WORKINGS IN "B" SEAM
ON
"STRAWBERRY RIDGE"
WASHINGTON TWP, CAMBRIA CO., PENNA.
SCALE : 1"=100'
J.S. SULLIVAN & CO.
ENGINEERS.

CAMBRIA MINING & MANUFACTURING CO.

Set Stone
(Replacing Original Cucumber Corner)