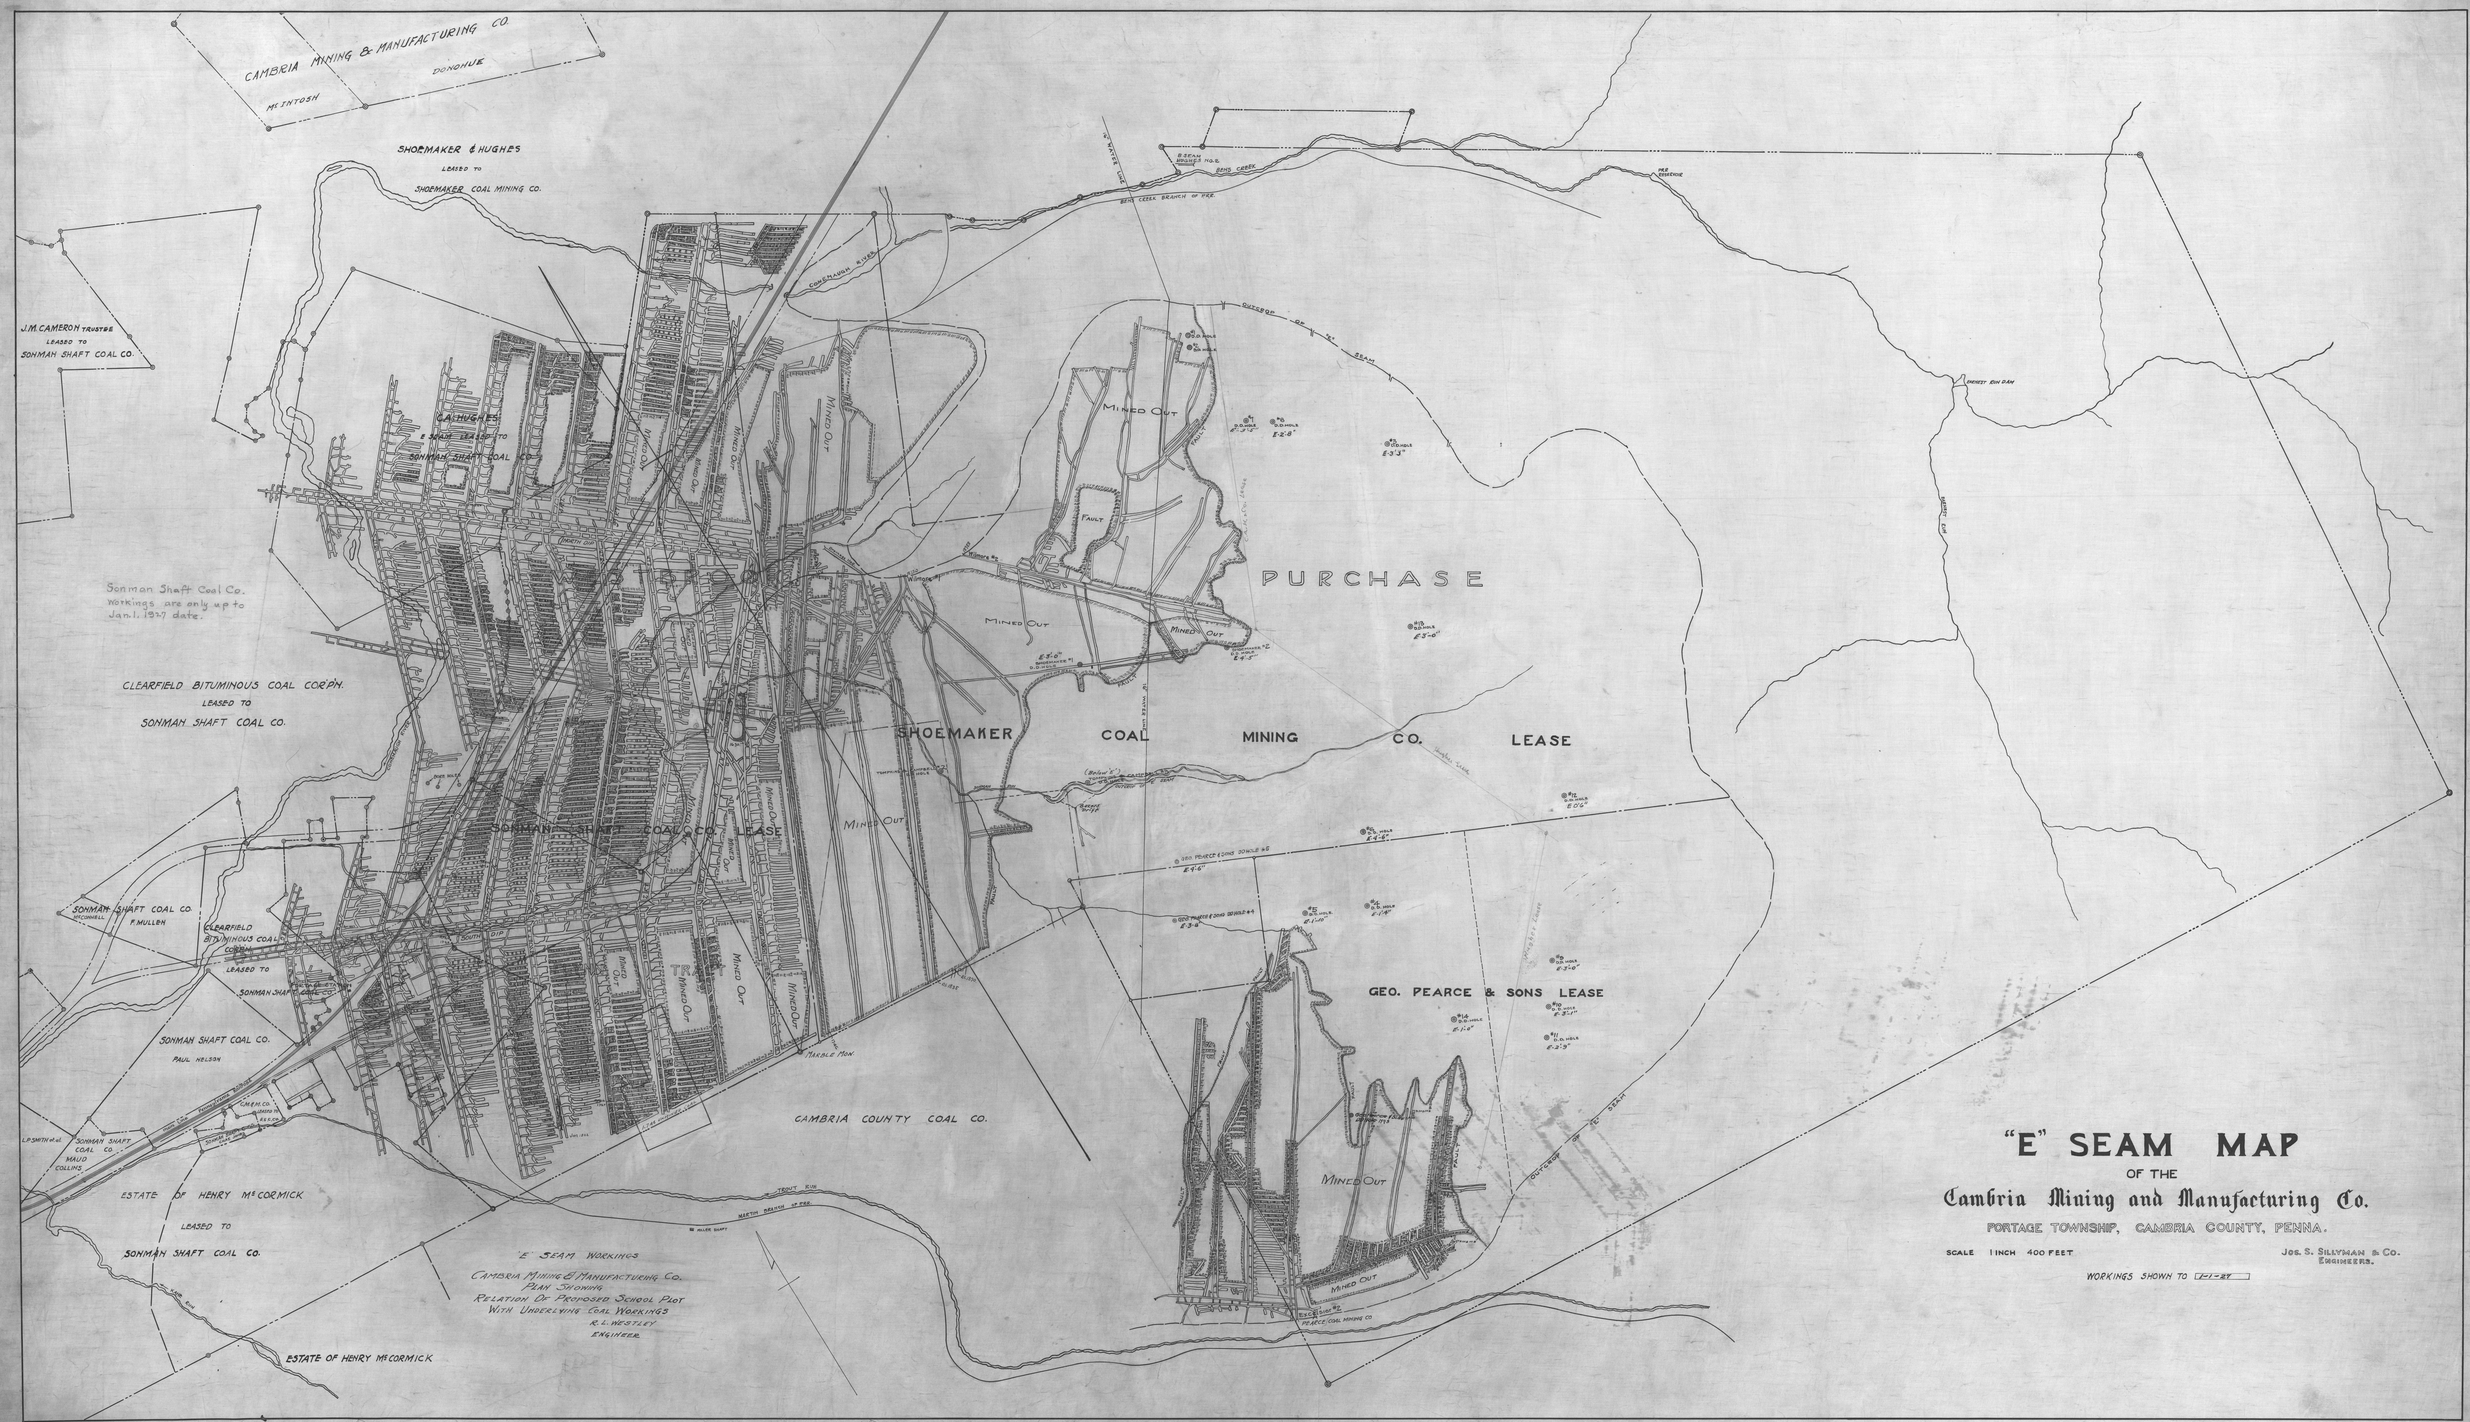
"E" SEAM MAP
OF THE
Cambria Mining and Manufacturing Co.
PORTAGE TOWNSHIP, CAMBRIA COUNTY, PENNA.
SCALE 1 INCH 400 FEET
JOS. S. SILLYMAN & CO.
ENGINEERS.
WORKINGS SHOWN TO 1-1-27
PURCHASE
SHOEMAKER COAL MINING CO. LEASE
SONMAN SHAFT COAL CO. LEASE
GEO. PEARCE & SONS LEASE
CAMBRIA COUNTY COAL CO.
CAMBRIA MINING & MANUFACTURING CO.
SHOEMAKER & HUGHES
LEASED TO
SHOEMAKER COAL MINING CO.
J.M. CAMERON TRUSTEE
LEASED TO
SONMAN SHAFT COAL CO.
CLEARFIELD BITUMINOUS COAL CORP'N.
LEASED TO
SONMAN SHAFT COAL CO.
ESTATE OF HENRY McCORMICK
LEASED TO
SONMAN SHAFT COAL CO.
ESTATE OF HENRY McCORMICK
Sonman Shaft Coal Co. workings are only up to Jan. 1. 1927 date.
MINED OUT
FAULT
'E' SEAM WORKINGS
CAMBRIA MINING & MANUFACTURING CO.
PLAN SHOWING
RELATION OF PROPOSED SCHOOL PLOT
WITH UNDERLYING COAL WORKINGS
R. L. MOSTLAY
ENGINEER.