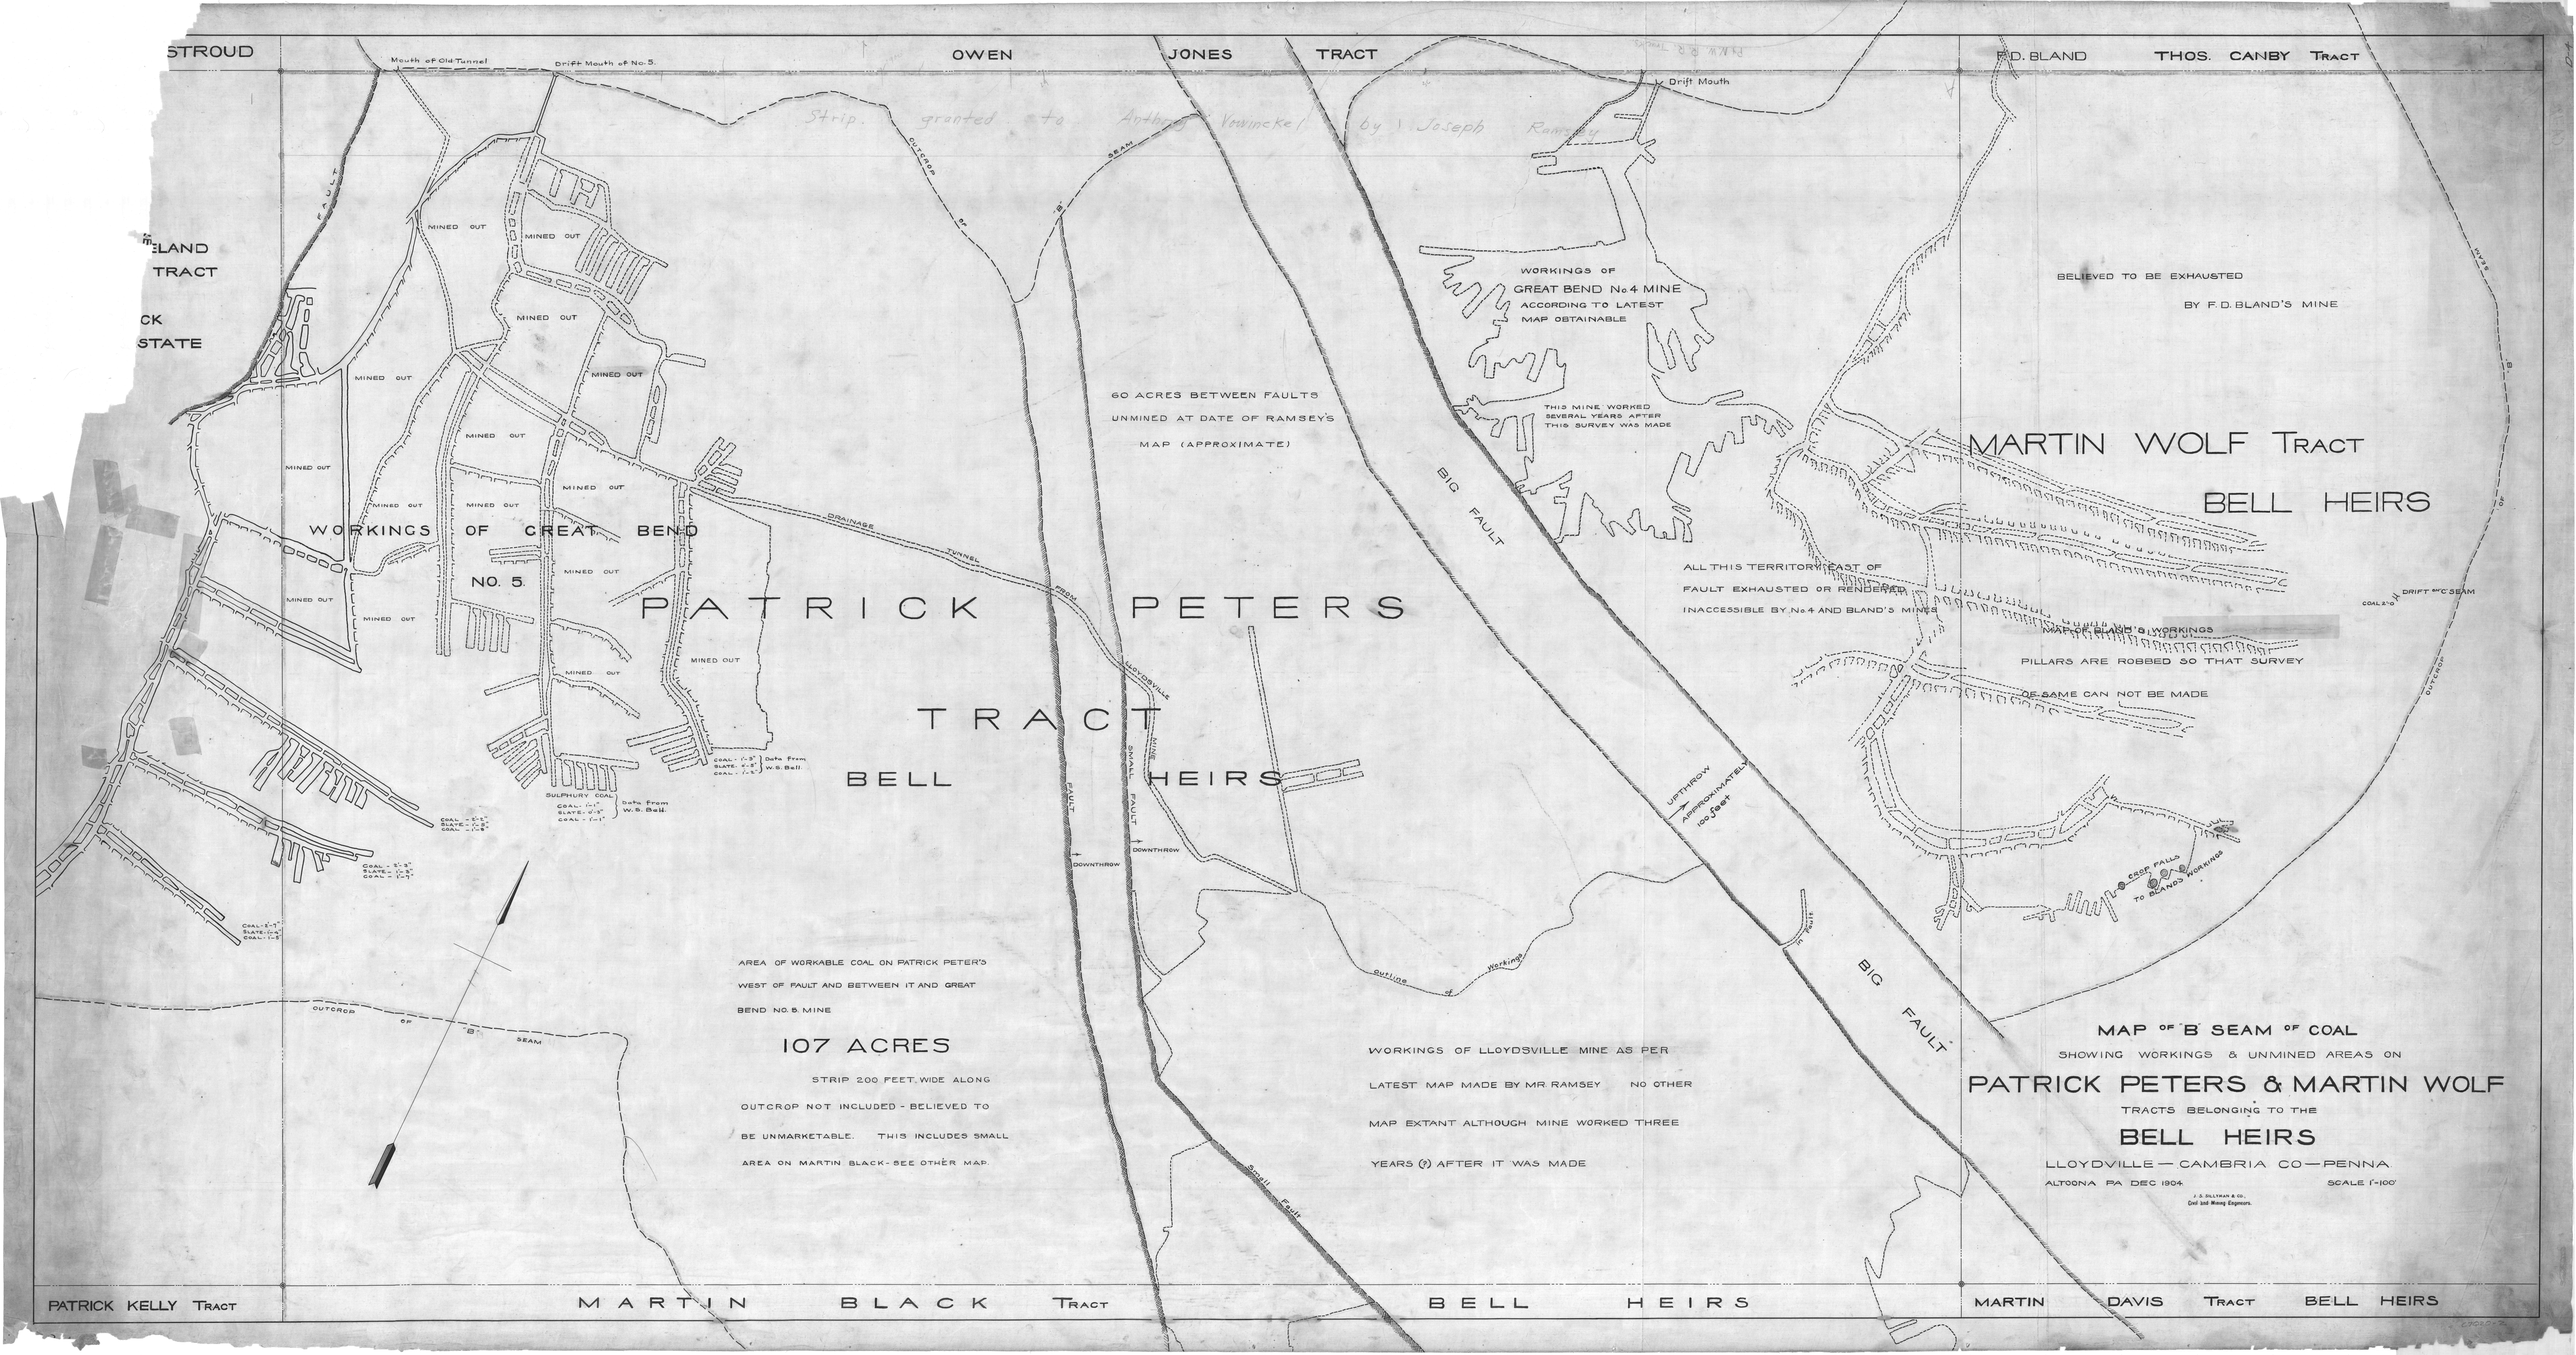
STROUD
OWEN JONES TRACT
F.D. BLAND
THOS. CANBY TRACT
Mouth of Old Tunnel
Drift Mouth of No. 5.
Drift Mouth
Strip granted to Anthony Vowinckel by Joseph Ramsey
OUTCROP OF "B" SEAM
FAULT
MINED OUT
WORKINGS OF GREAT BEND NO. 5.
DRAINAGE TUNNEL FROM LLOYDSVILLE MINE
PATRICK PETERS TRACT
BELL HEIRS
SULPHURY COAL
Data from W.S. Bell.
SMALL FAULT
DOWNTHROW
60 ACRES BETWEEN FAULTS
UNMINED AT DATE OF RAMSEY'S
MAP (APPROXIMATE)
WORKINGS OF GREAT BEND No 4 MINE
ACCORDING TO LATEST
MAP OBTAINABLE
THIS MINE WORKED
SEVERAL YEARS AFTER
THIS SURVEY WAS MADE
BIG FAULT
BELIEVED TO BE EXHAUSTED
BY F.D. BLAND'S MINE
MARTIN WOLF TRACT
BELL HEIRS
ALL THIS TERRITORY EAST OF
FAULT EXHAUSTED OR RENDERED
INACCESSIBLE BY No 4 AND BLAND'S MINES
MAP OF BLAND'S WORKINGS
PILLARS ARE ROBBED SO THAT SURVEY
OF SAME CAN NOT BE MADE
DRIFT MOUTH "C" SEAM
COAL 2'-0"
OUTCROP
UPTHROW
APPROXIMATELY
100 feet
CROP FALLS
TO BLAND'S WORKINGS
Outline of Workings
AREA OF WORKABLE COAL ON PATRICK PETER'S
WEST OF FAULT AND BETWEEN IT AND GREAT
BEND No. 5. MINE
107 ACRES
STRIP 200 FEET, WIDE ALONG
OUTCROP NOT INCLUDED - BELIEVED TO
BE UNMARKETABLE. THIS INCLUDES SMALL
AREA ON MARTIN BLACK - SEE OTHER MAP.
WORKINGS OF LLOYDSVILLE MINE AS PER
LATEST MAP MADE BY MR RAMSEY NO OTHER
MAP EXTANT ALTHOUGH MINE WORKED THREE
YEARS (?) AFTER IT WAS MADE
Small Faults
MAP OF "B" SEAM OF COAL
SHOWING WORKINGS & UNMINED AREAS ON
PATRICK PETERS & MARTIN WOLF
TRACTS BELONGING TO THE
BELL HEIRS
LLOYDVILLE — CAMBRIA CO — PENNA
ALTOONA PA DEC 1904
SCALE 1"-100'
J. S. SILLYMAN & CO.
Coal and Mining Engineers.
PATRICK KELLY Tract
MARTIN BLACK Tract
BELL HEIRS
MARTIN DAVIS Tract
BELL HEIRS