

MAP SHOWING WORKINGS
OF THE
SHOMO-MOSHANNON MINE
"E" OR UPPER FREEPORT SEAM
OPERATED BY
MOSHANNON COAL CO.


READE TOWNSHIP, CAMBRIA COUNTY, PA.

SCALE: 1"=100'

W. SILLIMA
Registered Engineer,
Allaqua, Pa.

JOHN WHITNEY TRACT

SIMON WALKER TRACT

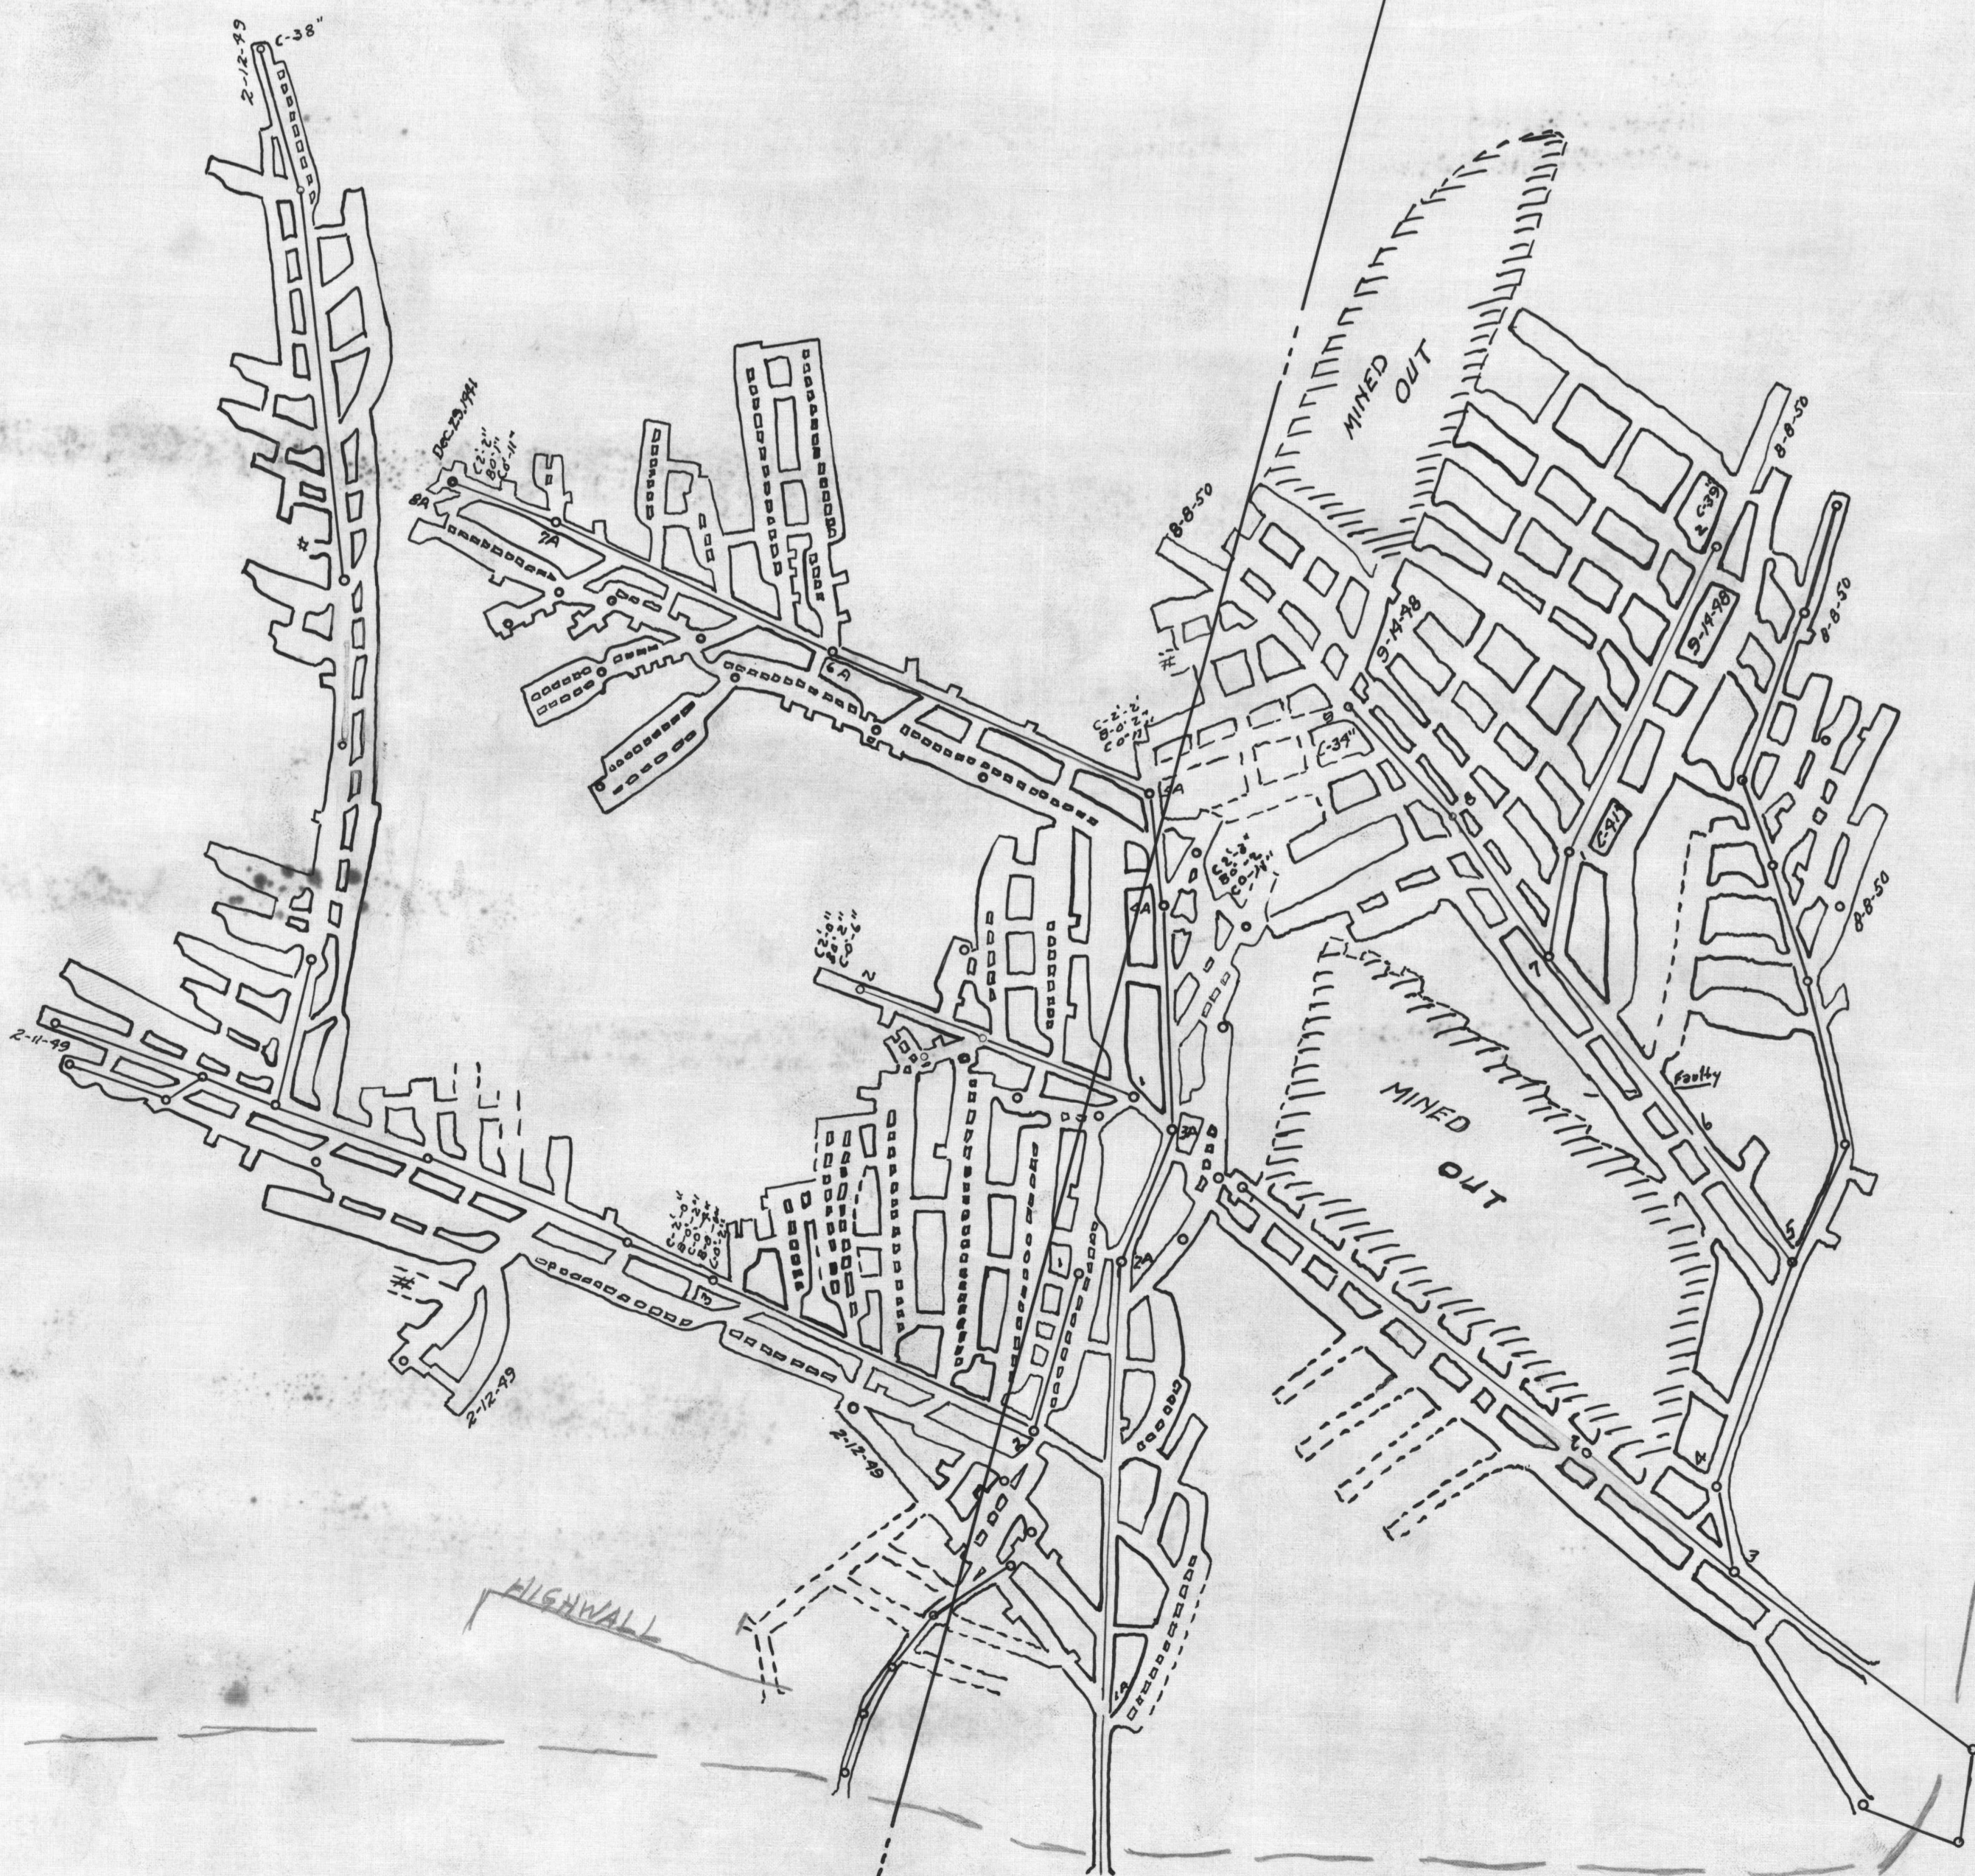

OUTCROP OF E SEAM

HIGHWALL

OUTCROP OF E SEAM