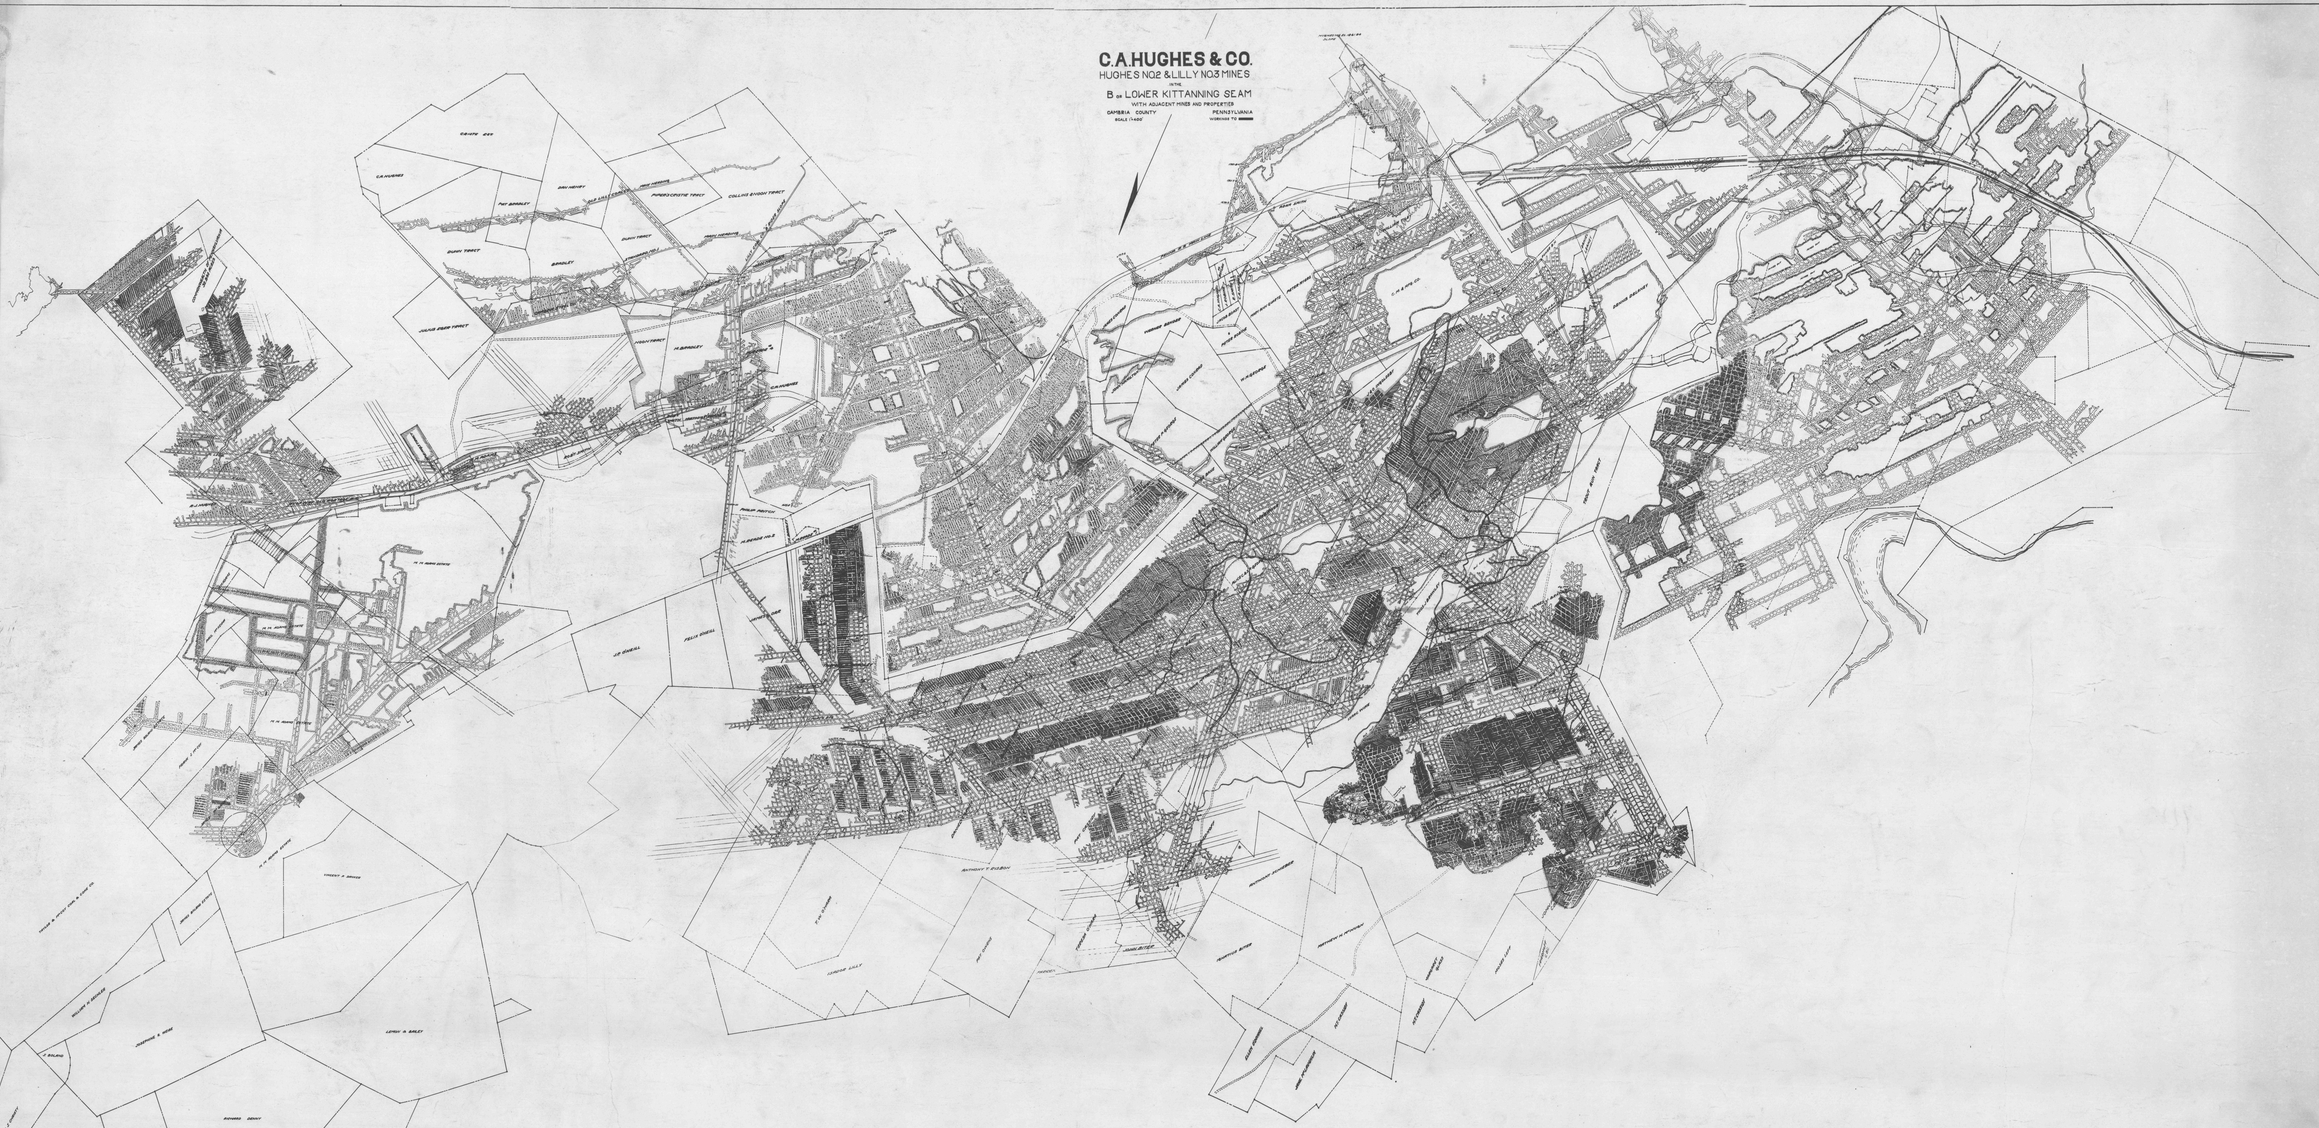
C.A. HUGHES & CO.
HUGHES NO2 & LILLY NO3 MINES
IN THE
B or LOWER KITTANNING SEAM
WITH ADJACENT MINES AND PROPERTIES
IN
CAMBRIA COUNTY
PENNSYLVANIA
SCALE 1=400'
WORKINGS TO