


MAP SHOWING  
WORKINGS ON "B" SEAM BY  
GAMBRIA-MOSHANNON COAL CO.  
MOUNTAINDALE, CAMBRIA CO., PA. J.S. SILLYMAN & CO. ENGRS.  
ALTOONA, PA.  
SCALE: 1"=100'

C771-3

Elevation of Drainage  
Drift of Great Bend Mine  
1081.2

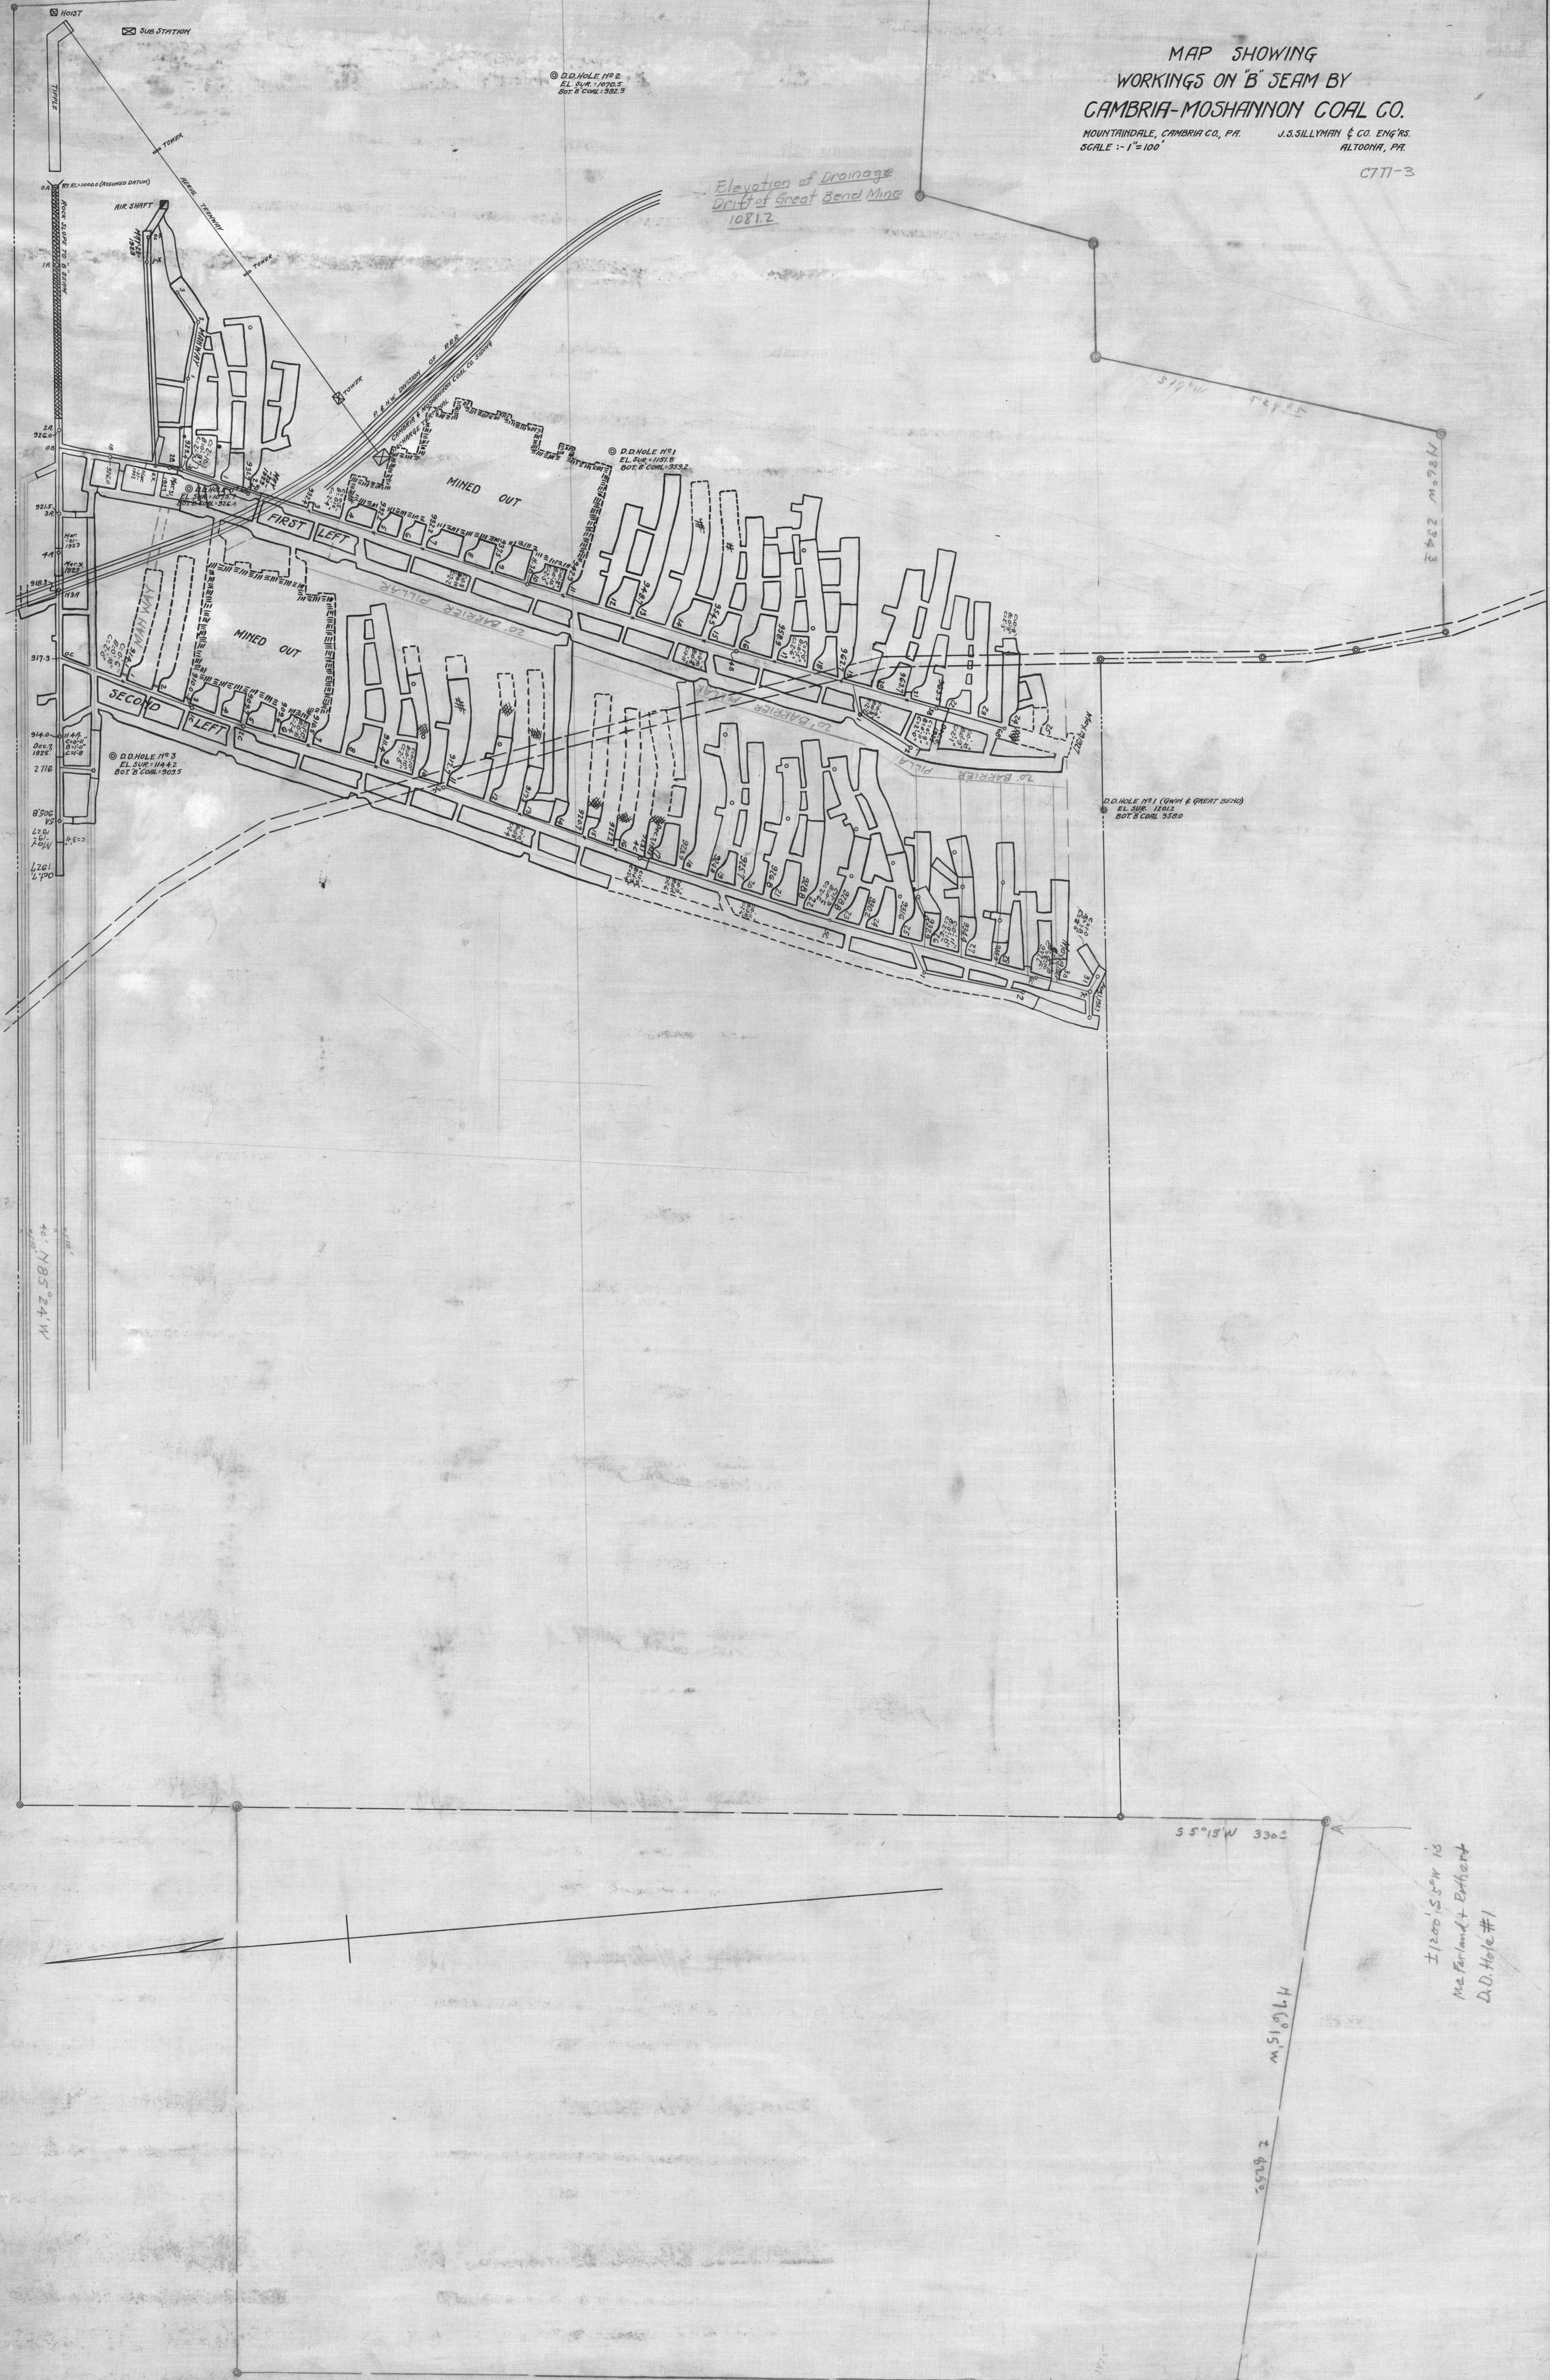

1/2001 S.W. 13  
McFarland & Eckhart  
D.D. Hole #1