

JAMES THOMPSON

JAMES MARTIN


**MINED OUT
No 9 MINE**

WILLIAM BARTON NOW
PA. GAME COMMISSION

SURFACE-STATE GAME COMMISSION
COAL- HIRAM SWANK'S SONS

H. KEPPLER NOW PA. GAME COMMISSION

HWY. RTE. 53 3/4 MILE
NEW RUN

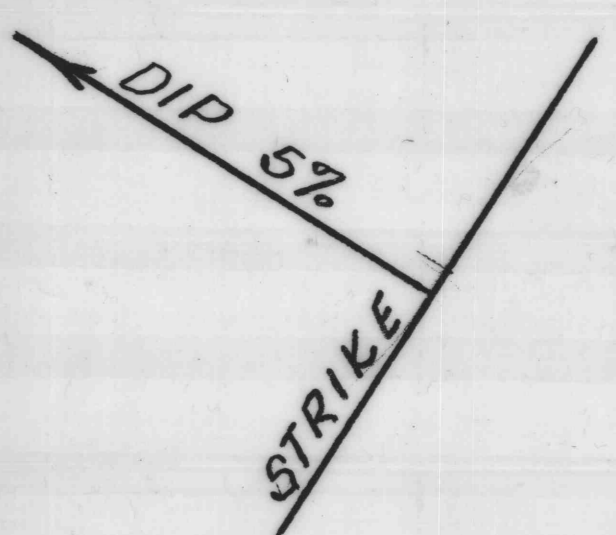

FAULTED AREA

MINED OUT

M. KEPPLER NOW PA. GAME COMMISSION

Mining Area
May 30, 1968 to
Nov 30, 1968

Mined Out to
OCT. 3, 1968

AMENDED
40 ACRES
MAY 1968

WILLIAM TILTON

MINED OUT PREVIOUSLY
FIRST MINING
NO AVAILABLE MAP
CHAIN PILLARS & HEADING STUMPS RECOVERABLE

SURFACE-STATE GAME
COAL- DON BENNIX

EZRA KIEL FARMER

SWANK No 13 MINE
PERMIT No. 158-1
DAVIS COAL CO.
C-PRIME
DEAN TWP., CAMBRIA CO., PA.
SCALE: 1"=200'
8-20-1966 66-11-109