


OWEN JONES TRACT (KATHERINE VOWINCKLE PATENT)
HEIRS OF MAX FRICK

THOMAS CANBY TRACT
F. D. BLAND

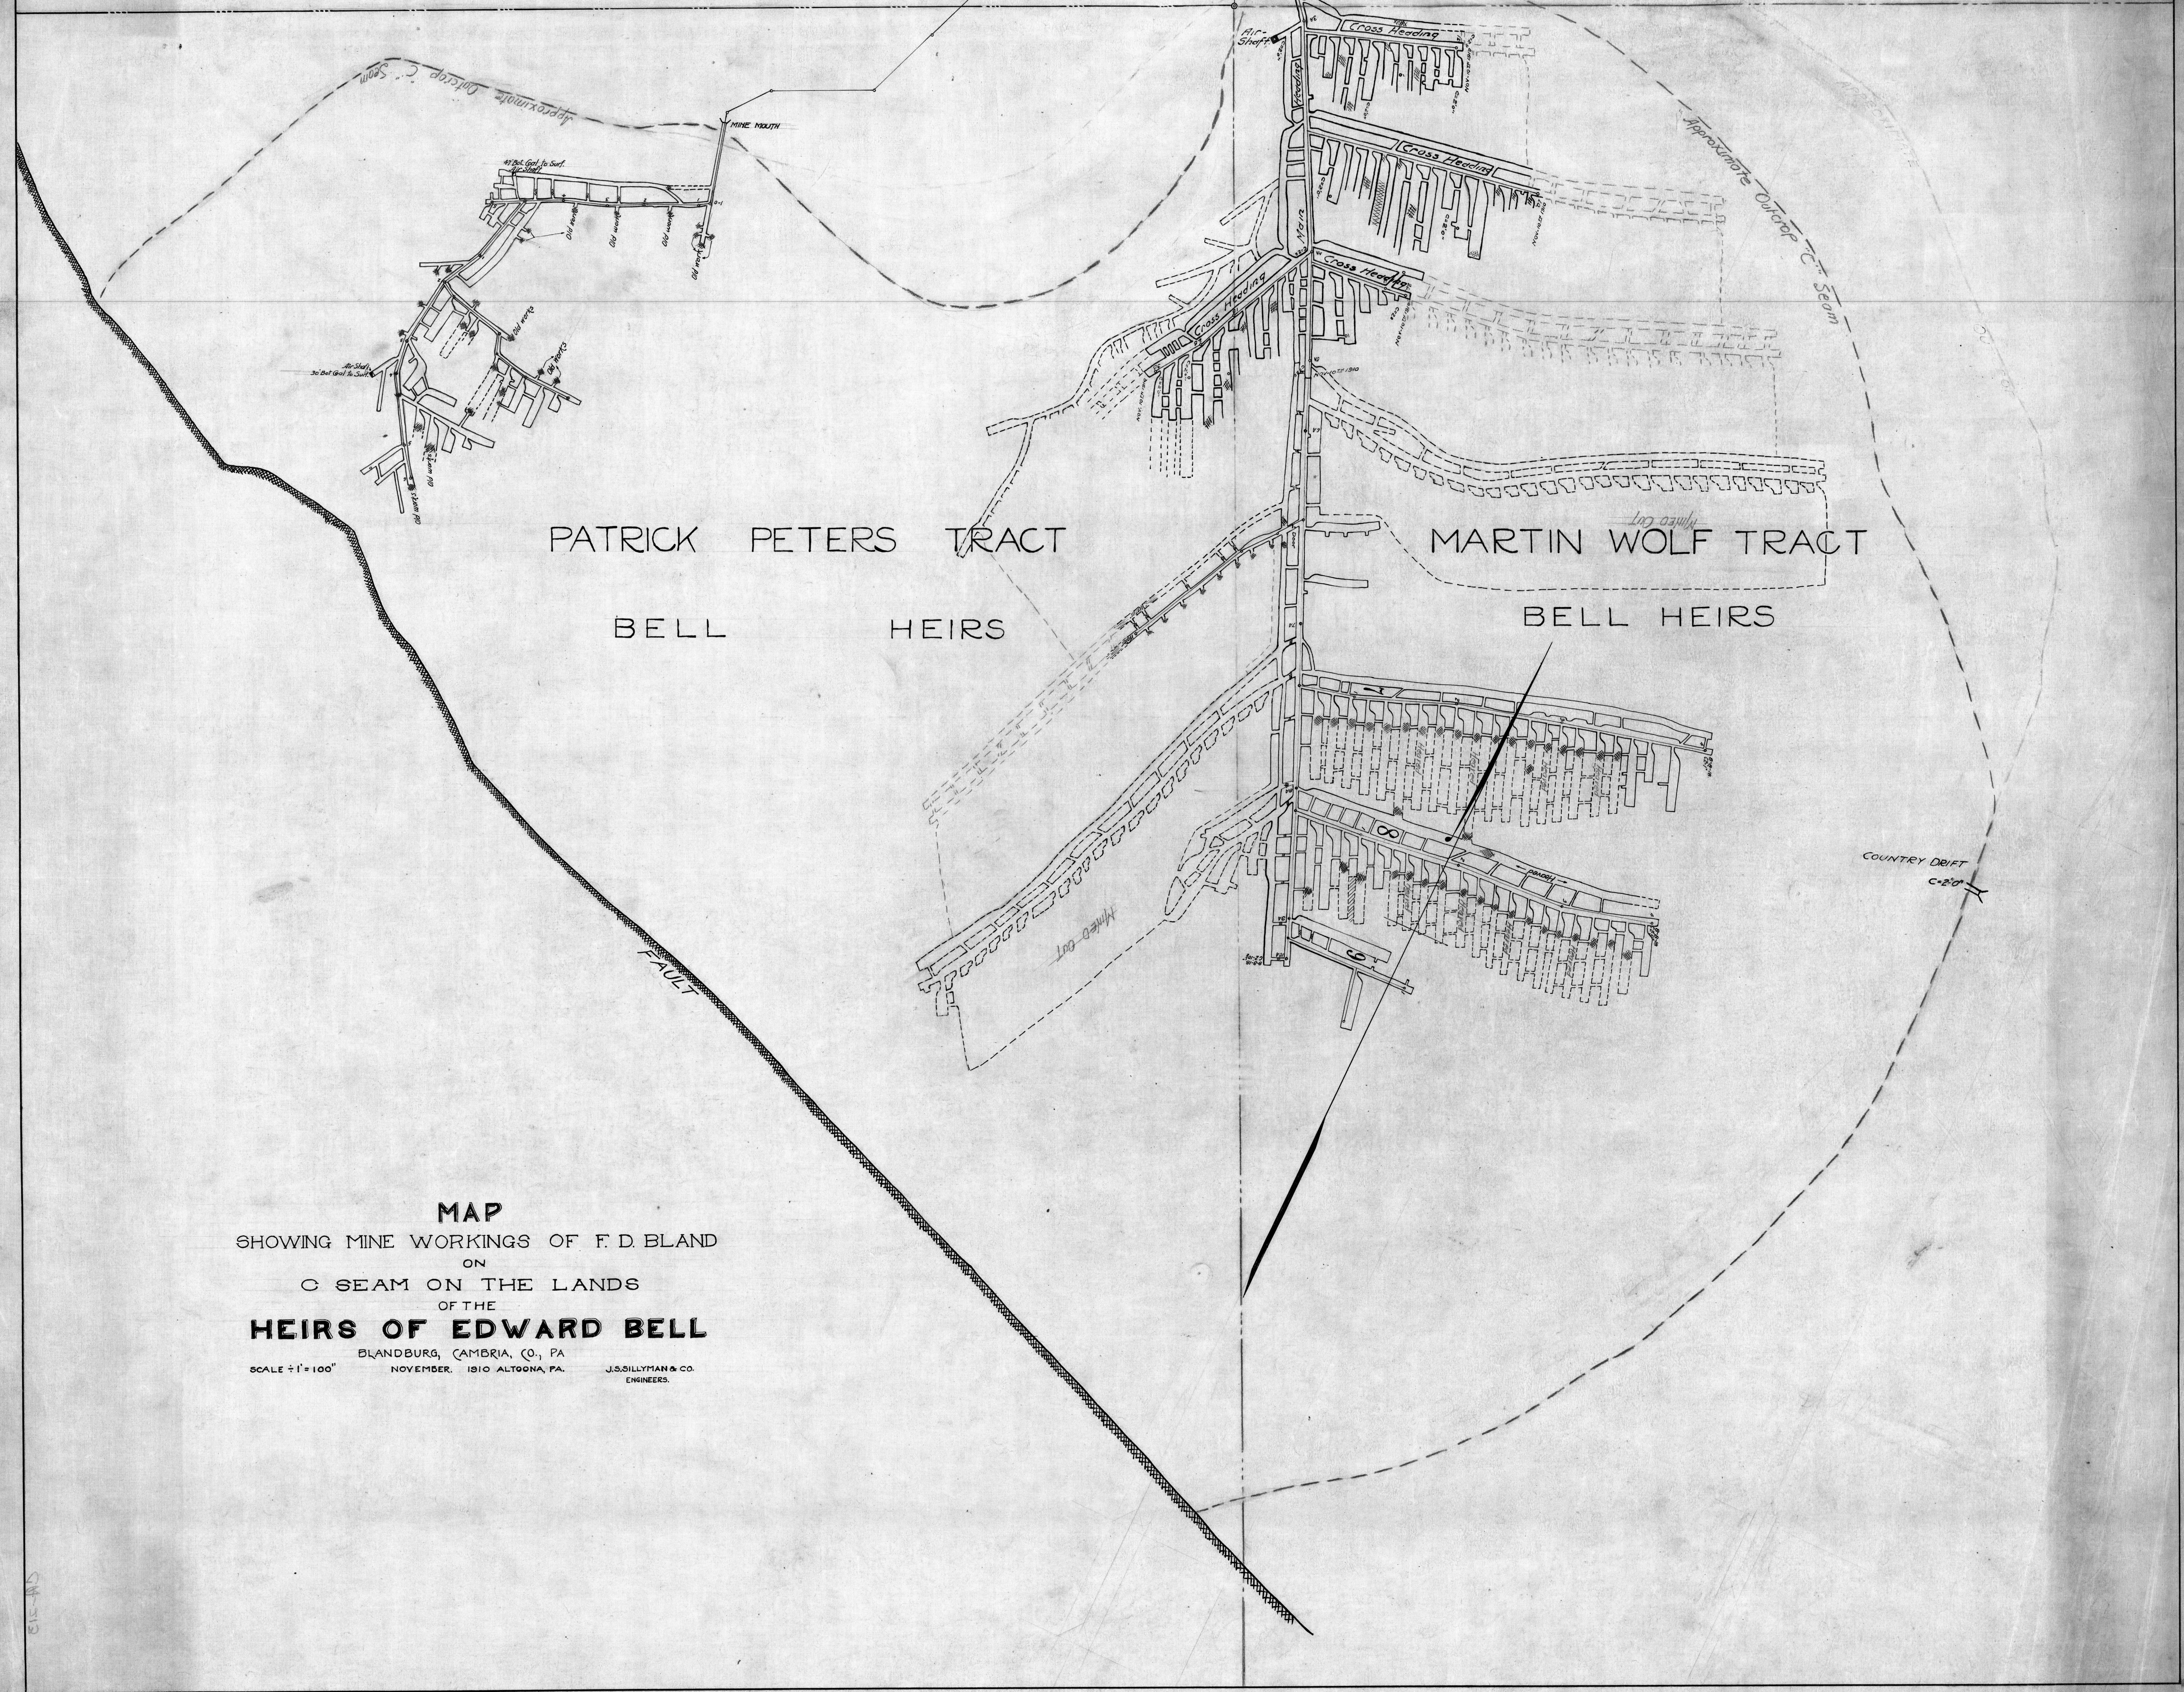

PATRICK PETERS TRACT
BELL HEIRS

MARTIN WOLF TRACT
BELL HEIRS

MAP
SHOWING MINE WORKINGS OF F. D. BLAND
ON
C SEAM ON THE LANDS
OF THE
HEIRS OF EDWARD BELL
BLANDBURG, CAMBRIA CO., PA
SCALE 1" = 100'
NOVEMBER, 1910 ALTOONA, PA. J.S. SILLIMAN & CO. ENGINEERS.