


MAP SHOWING  
 OUTCROP AND FACE OF WORKINGS  
 OF  
**BAKERS DRIFT AND DELANEY NO. 1**  
 DELANEY, GALLITZIN TOWNSHIP, CAMBRIA CO., PENNA.  
 SCALE: 1"=100'  
 W. A. SILLIMAN  
 ENGINEER

TOTAL AREA BY STRIPPING - 6.93 AS.

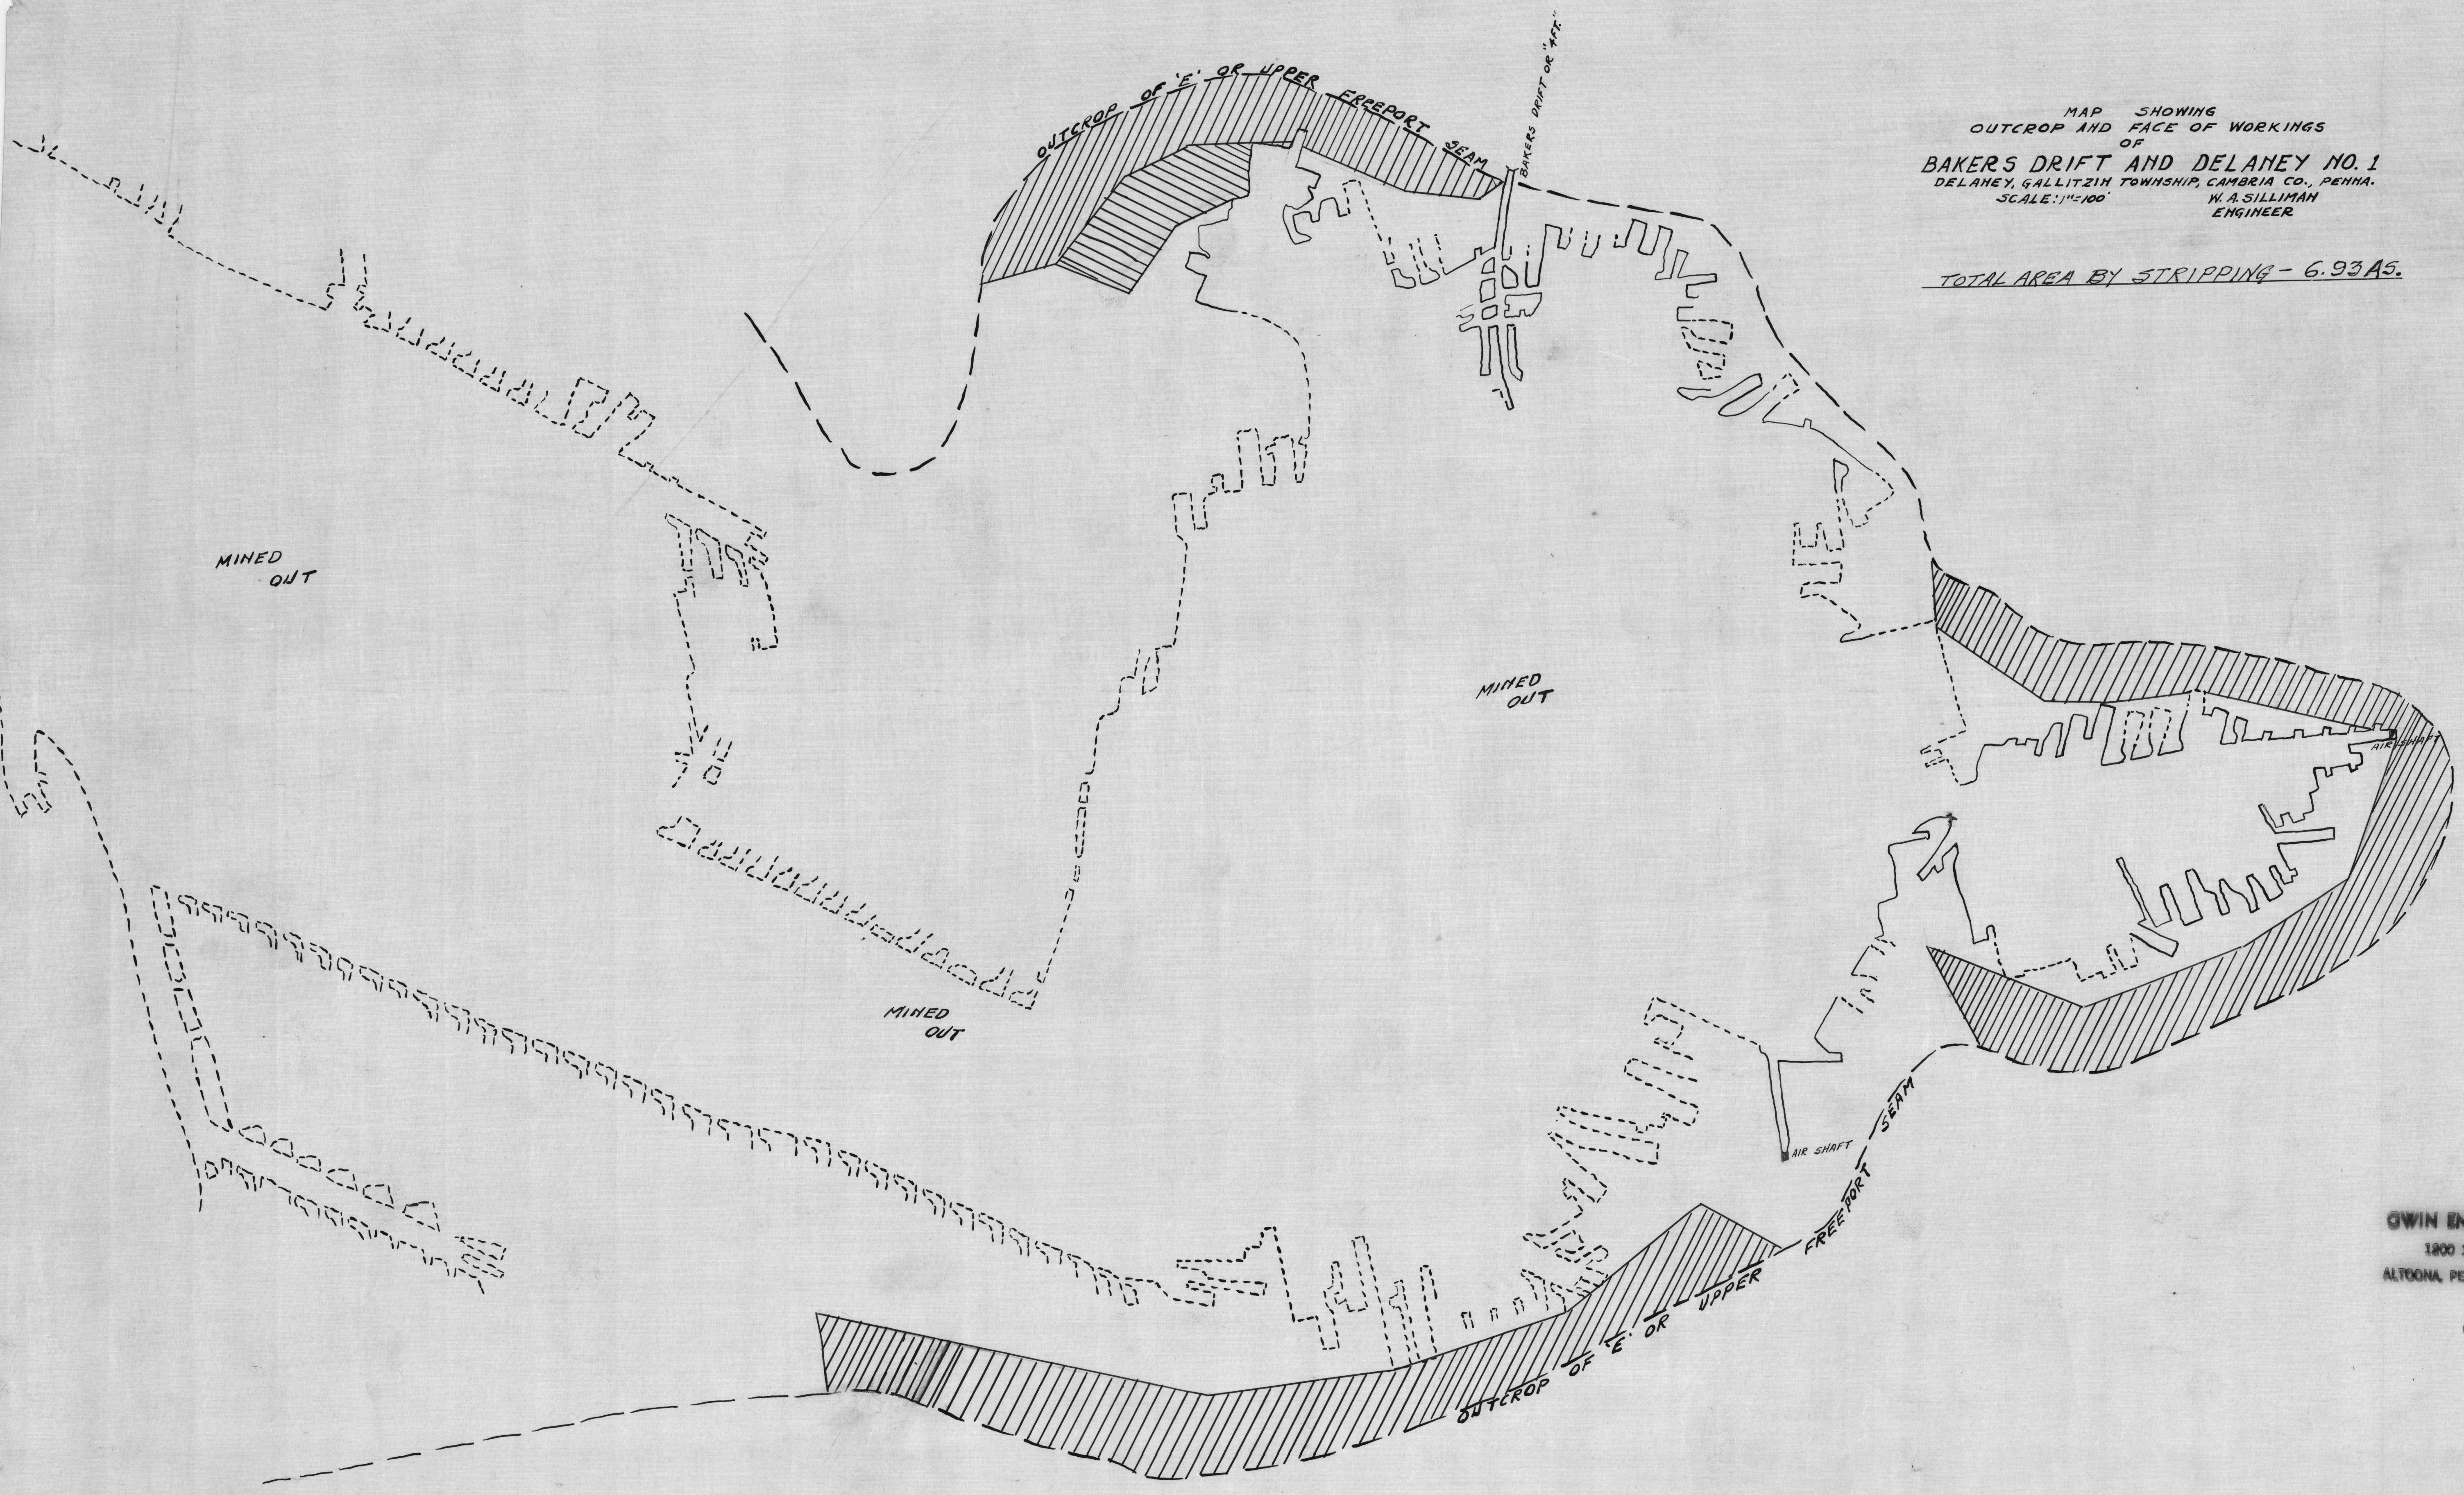

GWIN ENGINEERS INC  
 1200 12th AVENUE  
 ALTOONA, PENNSYLVANIA 16601

8