


CLEARFIELD BITUMINOUS COAL CORPORATION
LEASED TO PENNSYLVANIA COAL & COKE COR'N.

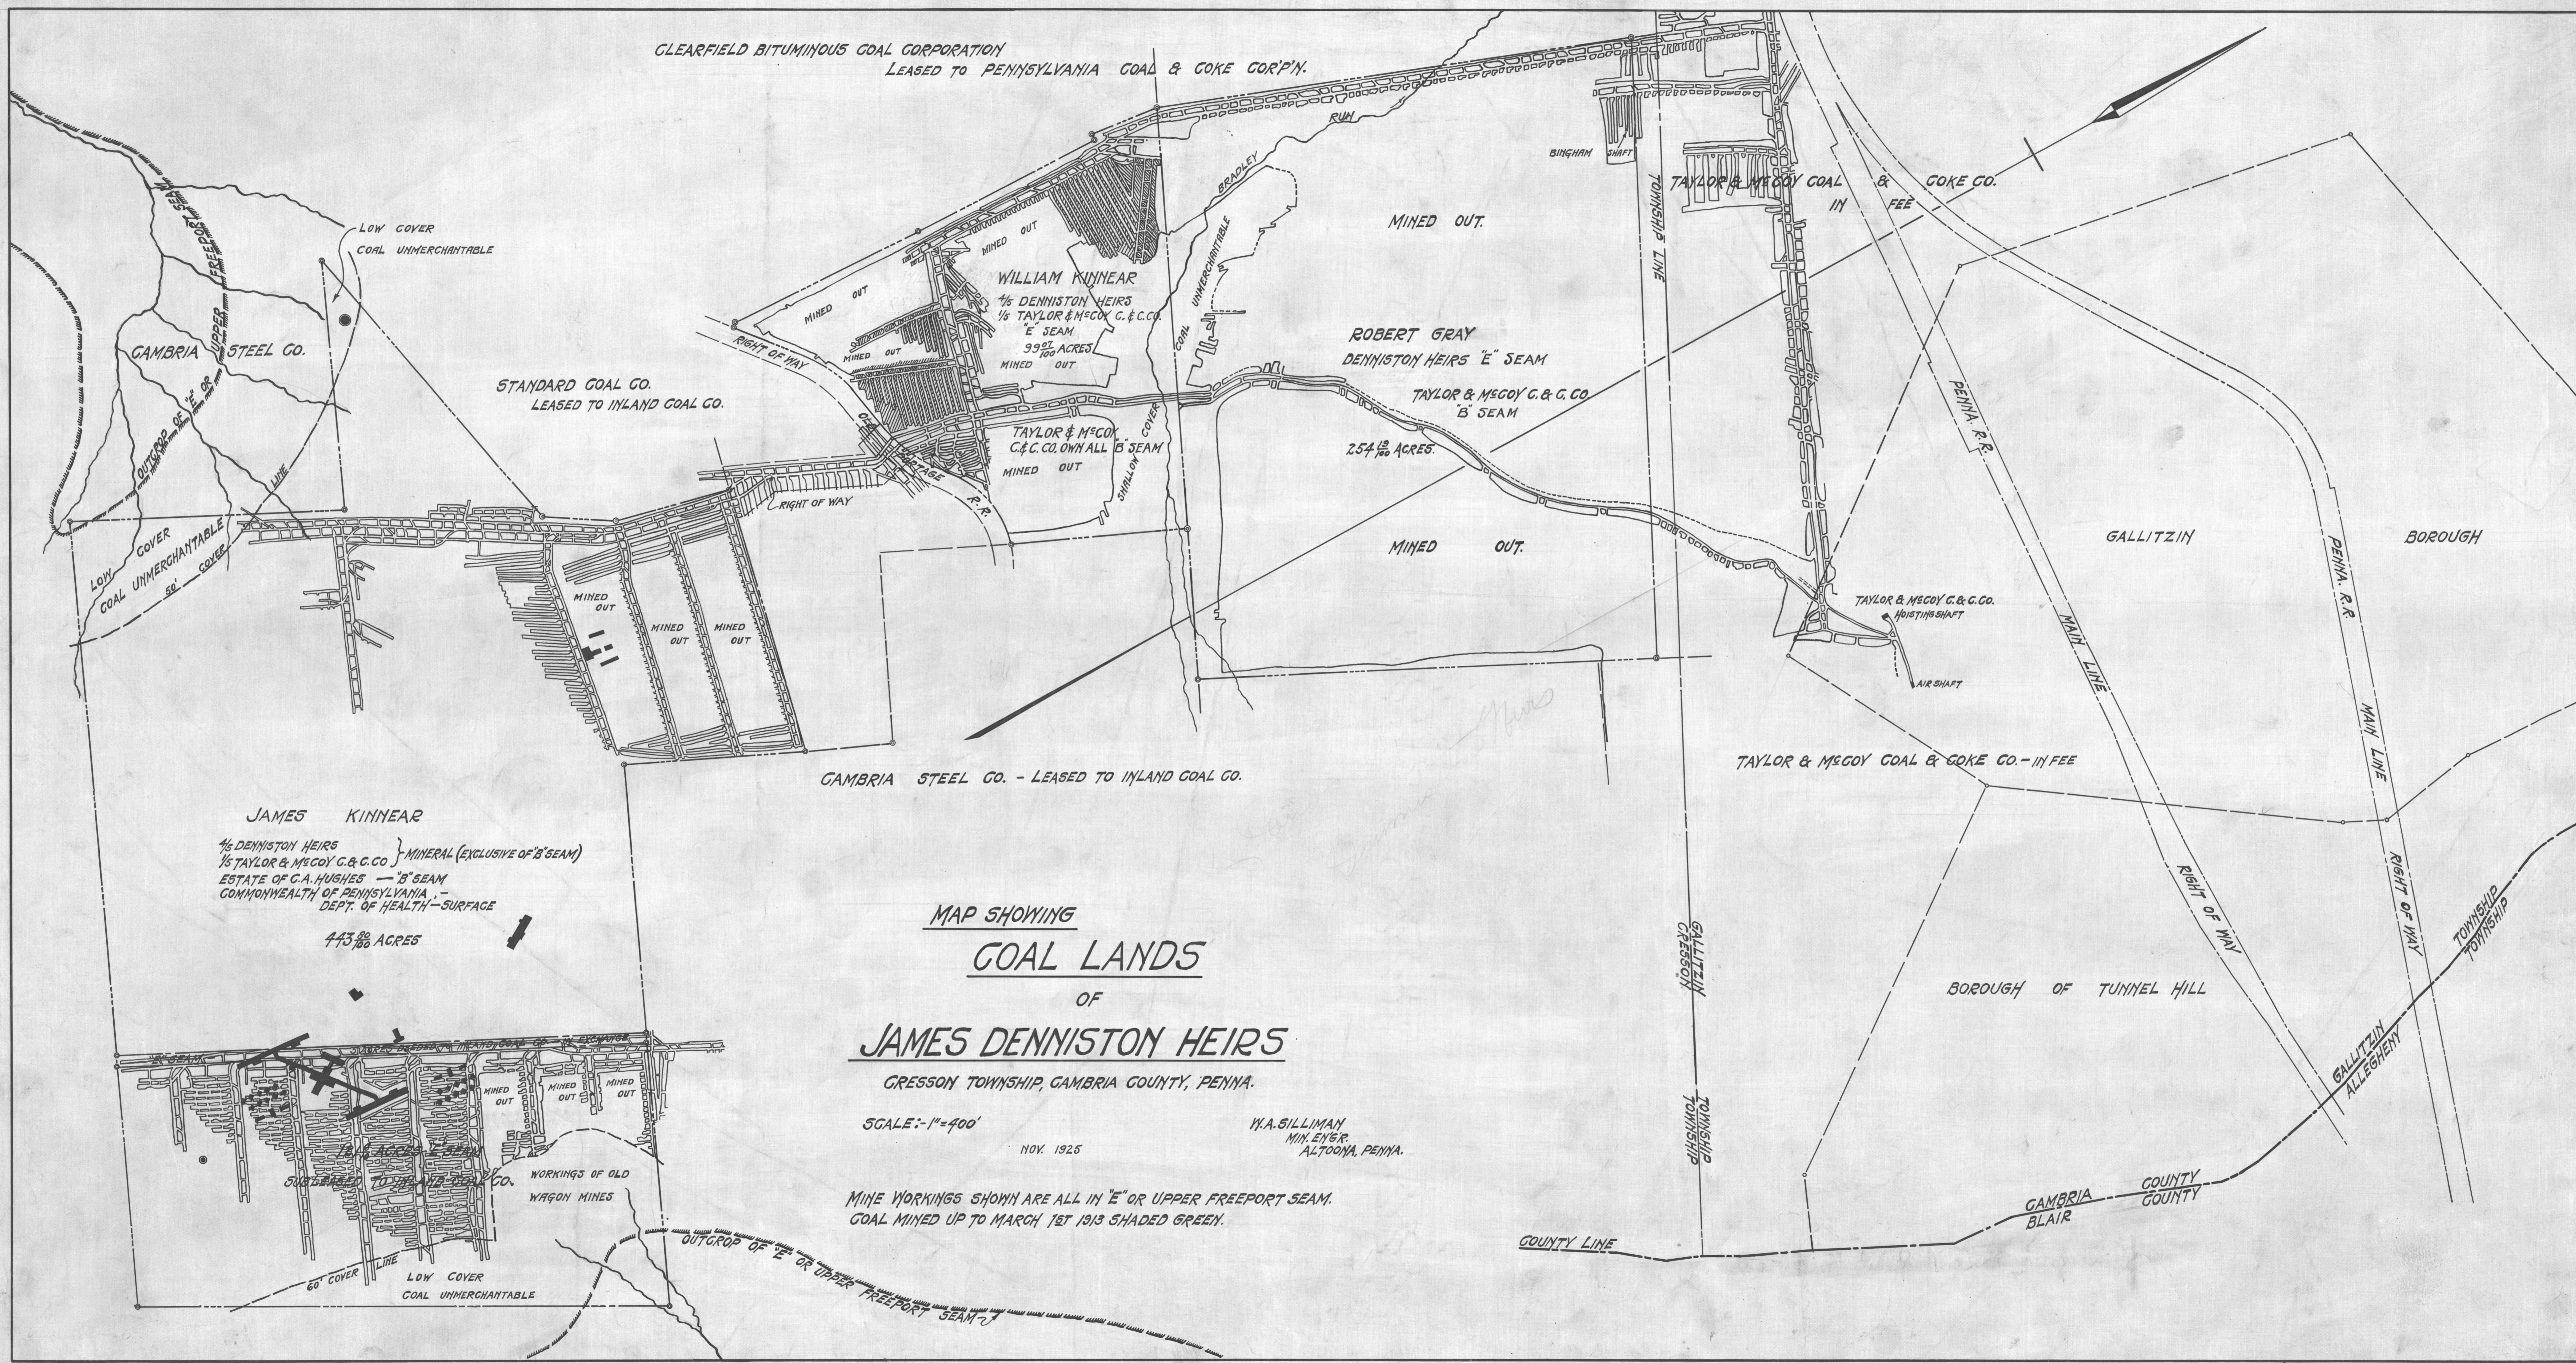

STANDARD COAL CO.
LEASED TO INLAND COAL CO.

WILLIAM KINNEAR
1/4 DENNISTON HEIRS
1/4 TAYLOR & MCGOY C. & C. CO.
E SEAM
99 2/3 ACRES
MINED OUT

ROBERT GRAY
DENNISTON HEIRS "E" SEAM
TAYLOR & MCGOY C. & C. CO.
B SEAM
254 1/2 ACRES

TAYLOR & MCGOY
C. & C. CO. OWN ALL B SEAM
MINED OUT

GAMBRIA STEEL CO. - LEASED TO INLAND COAL CO.

JAMES KINNEAR
1/4 DENNISTON HEIRS
1/4 TAYLOR & MCGOY C. & C. CO. } MINERAL (EXCLUSIVE OF "B" SEAM)
ESTATE OF C.A. HUGHES - "B" SEAM
COMMONWEALTH OF PENNSYLVANIA, -
DEPT. OF HEALTH - SURFACE
443 2/3 ACRES

MAP SHOWING
GOAL LANDS
OF
JAMES DENNISTON HEIRS
GRESSON TOWNSHIP, GAMBRIA COUNTY, PENNA.

SCALE: 1" = 400'

NOV. 1925

W.A. SILLIMAN
MIN. ENGR.
ALTOONA, PENNA.

MINE WORKINGS SHOWN ARE ALL IN "E" OR UPPER FREEPORT SEAM.
GOAL MINED UP TO MARCH 1ST 1913 SHADED GREEN.

