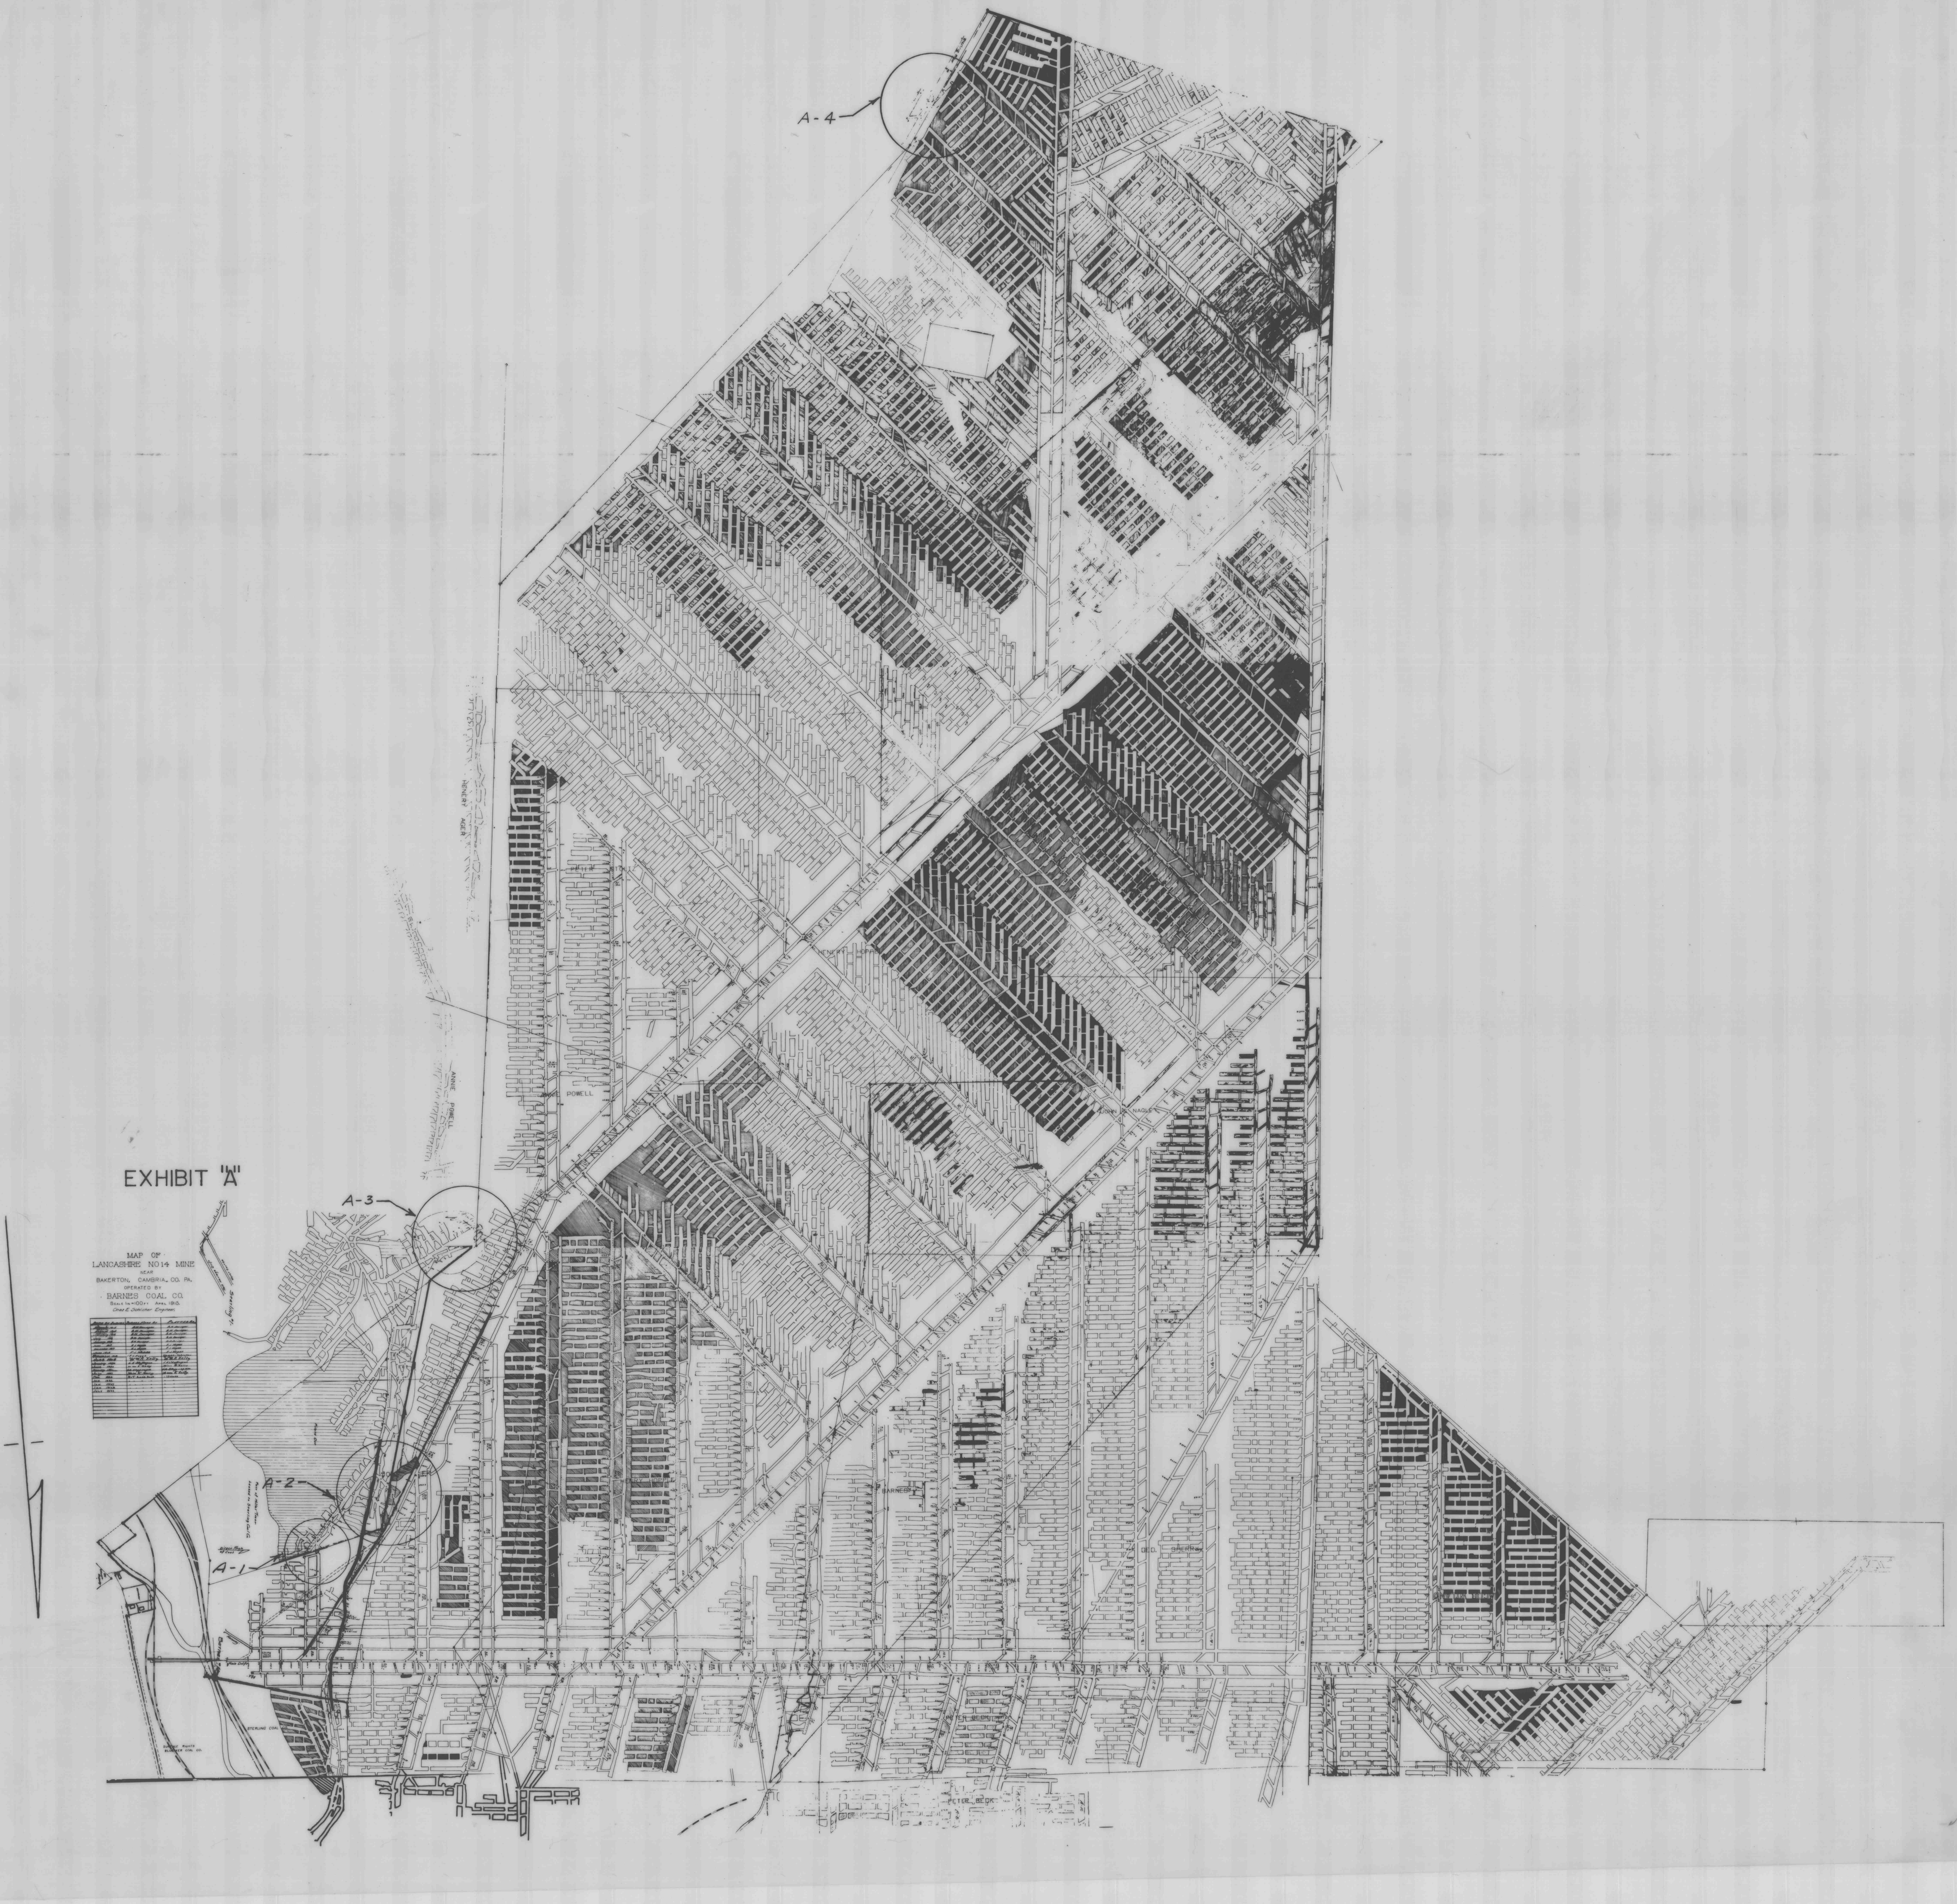
EXHIBIT "A"
MAP OF
LANCASHIRE NO 14 MINE
NEAR
BAKERTON, CAMBRIA CO. PA.
OPERATED BY
BARNES COAL CO.
SCALE 1 IN = 100 FT APRIL 1915.
Chas E. Schlicher Engineer.
A-1
A-2
A-3
A-4
HENERY AGER
PETER STOLTZ
ANNIE POWELL
HENRY HOPPLE
JOHN NAGLE
BARNES
GEO. SHERRY
PETER BECK
STERLING COAL CO.
Sterling #1
15-L
14-L
13-L

CL3/4-5