


DRILL HOLE RECORDS

Pennsylvania Coal & Coke Co.

Patton Engineering Division.

Patton Group.

Drawing No. A655-1
A-430-1

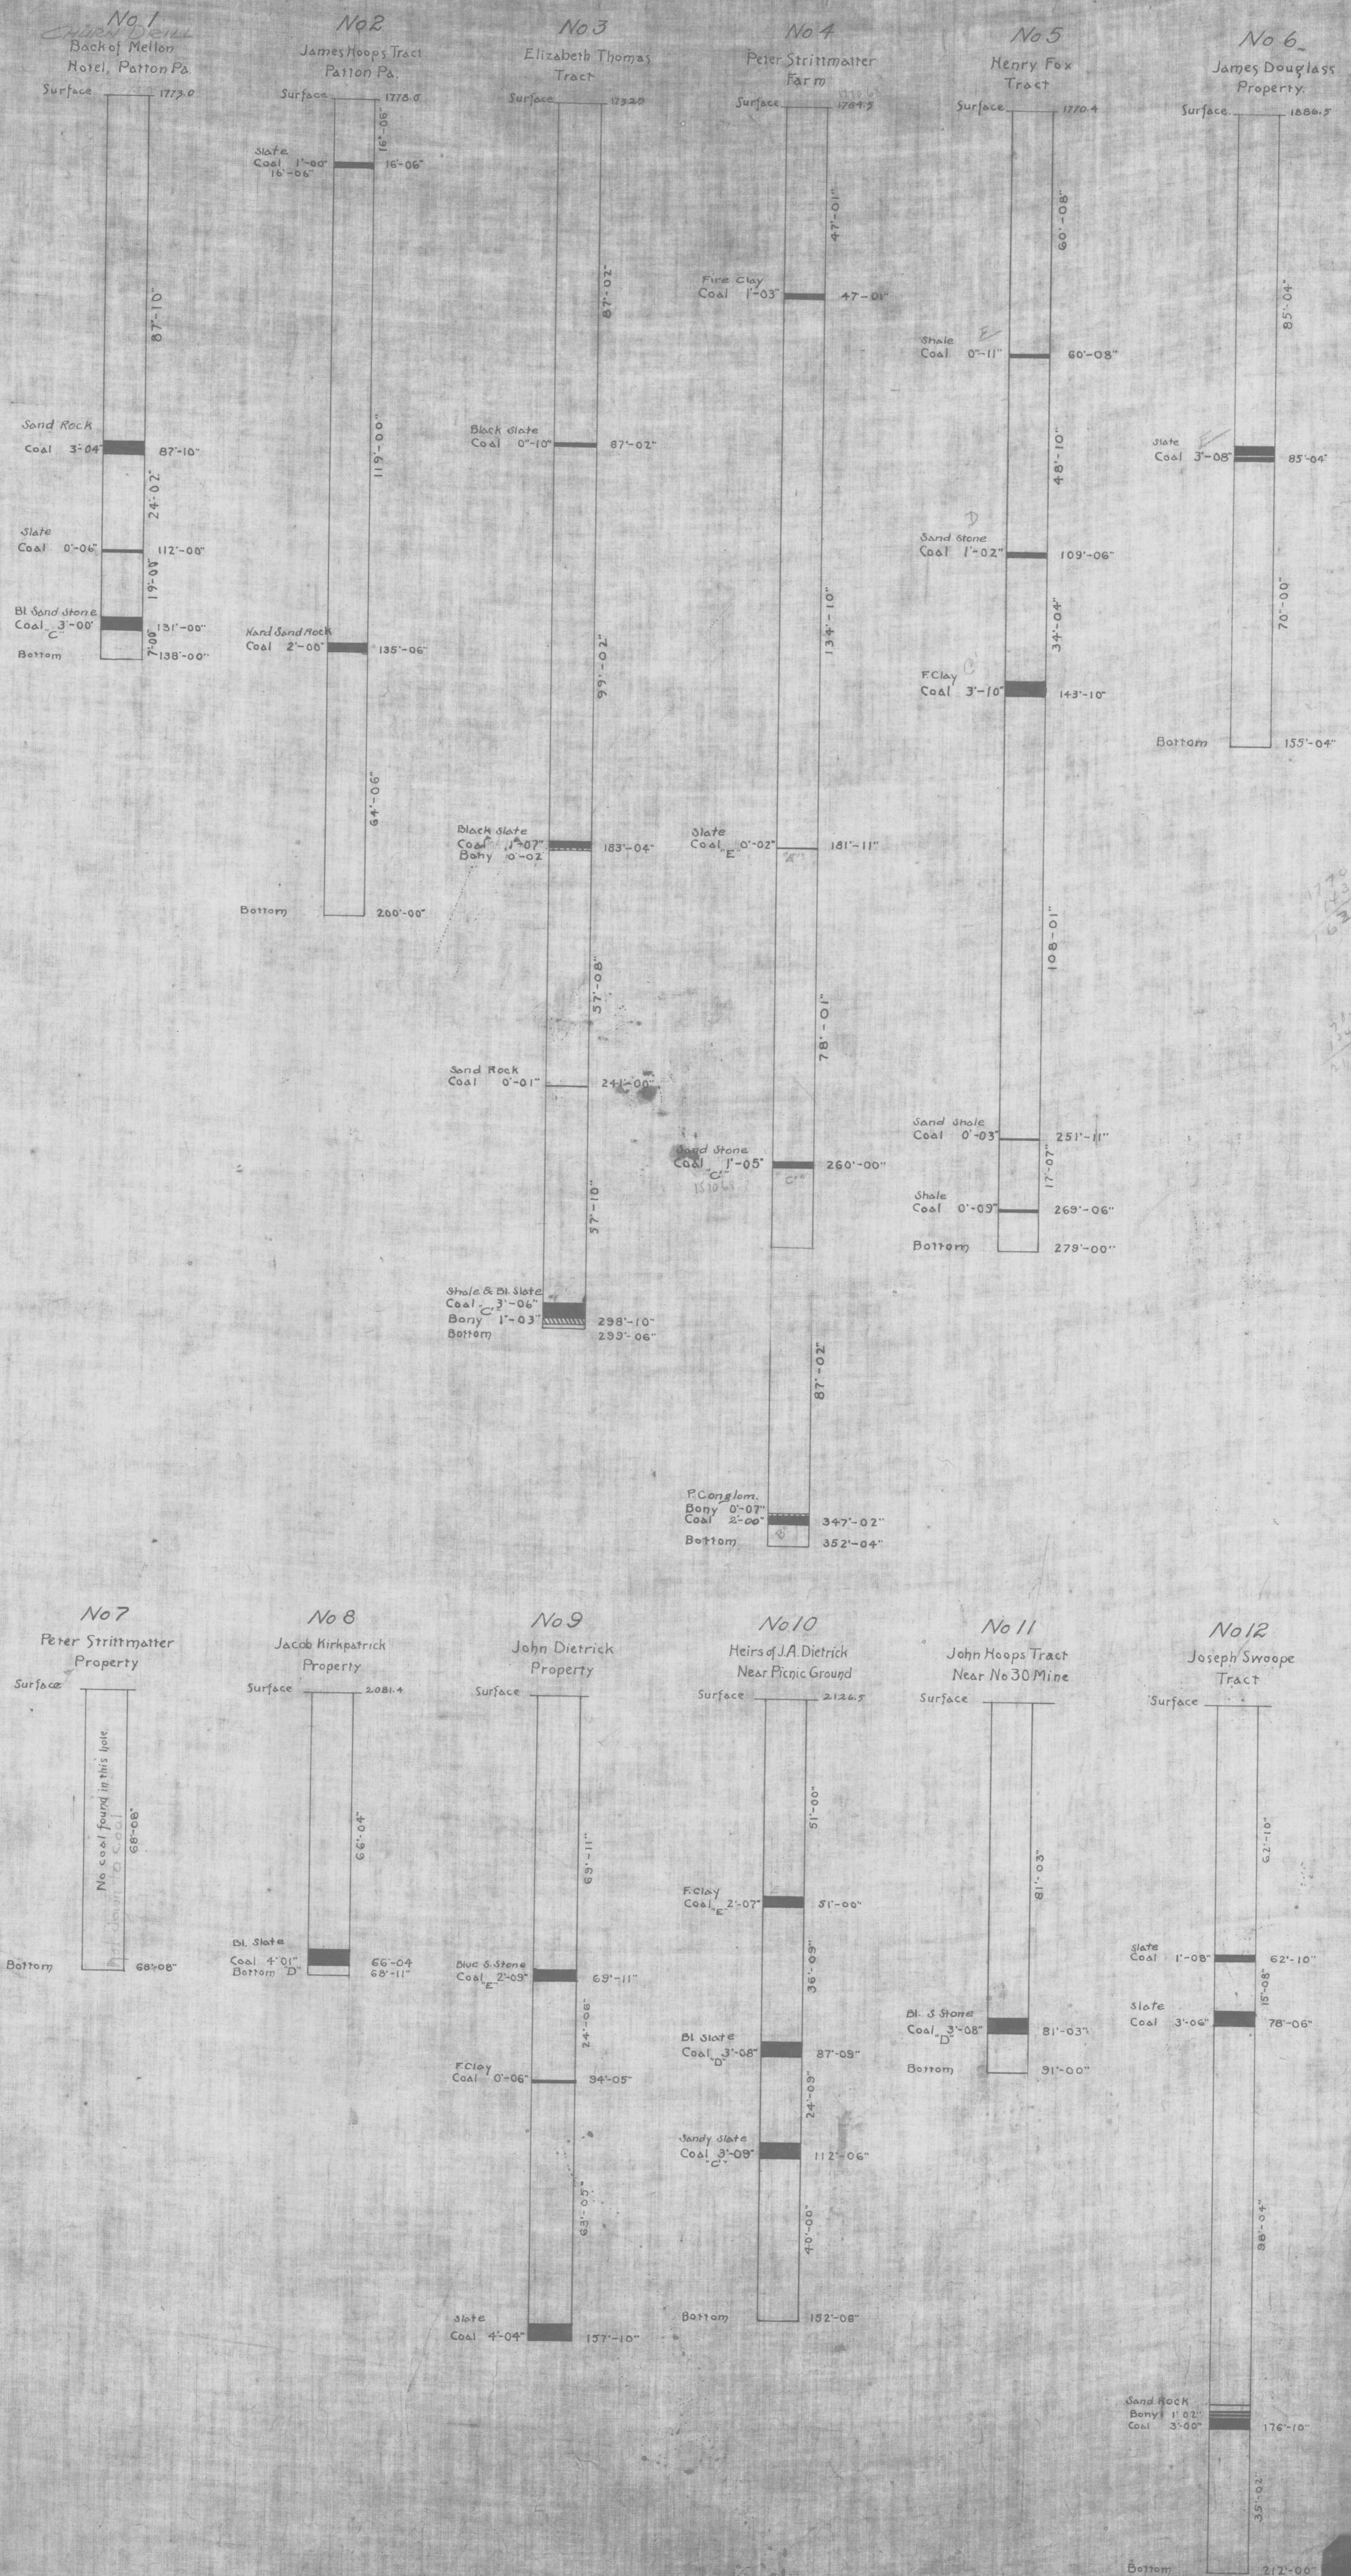

A-430-1
A-430-1