


DRILL HOLE RECORDS

Pennsylvania Coal & Coke Co.

Patton Engineering Division.

Patton Group.

Drawing No. A-430-2
A-430-2

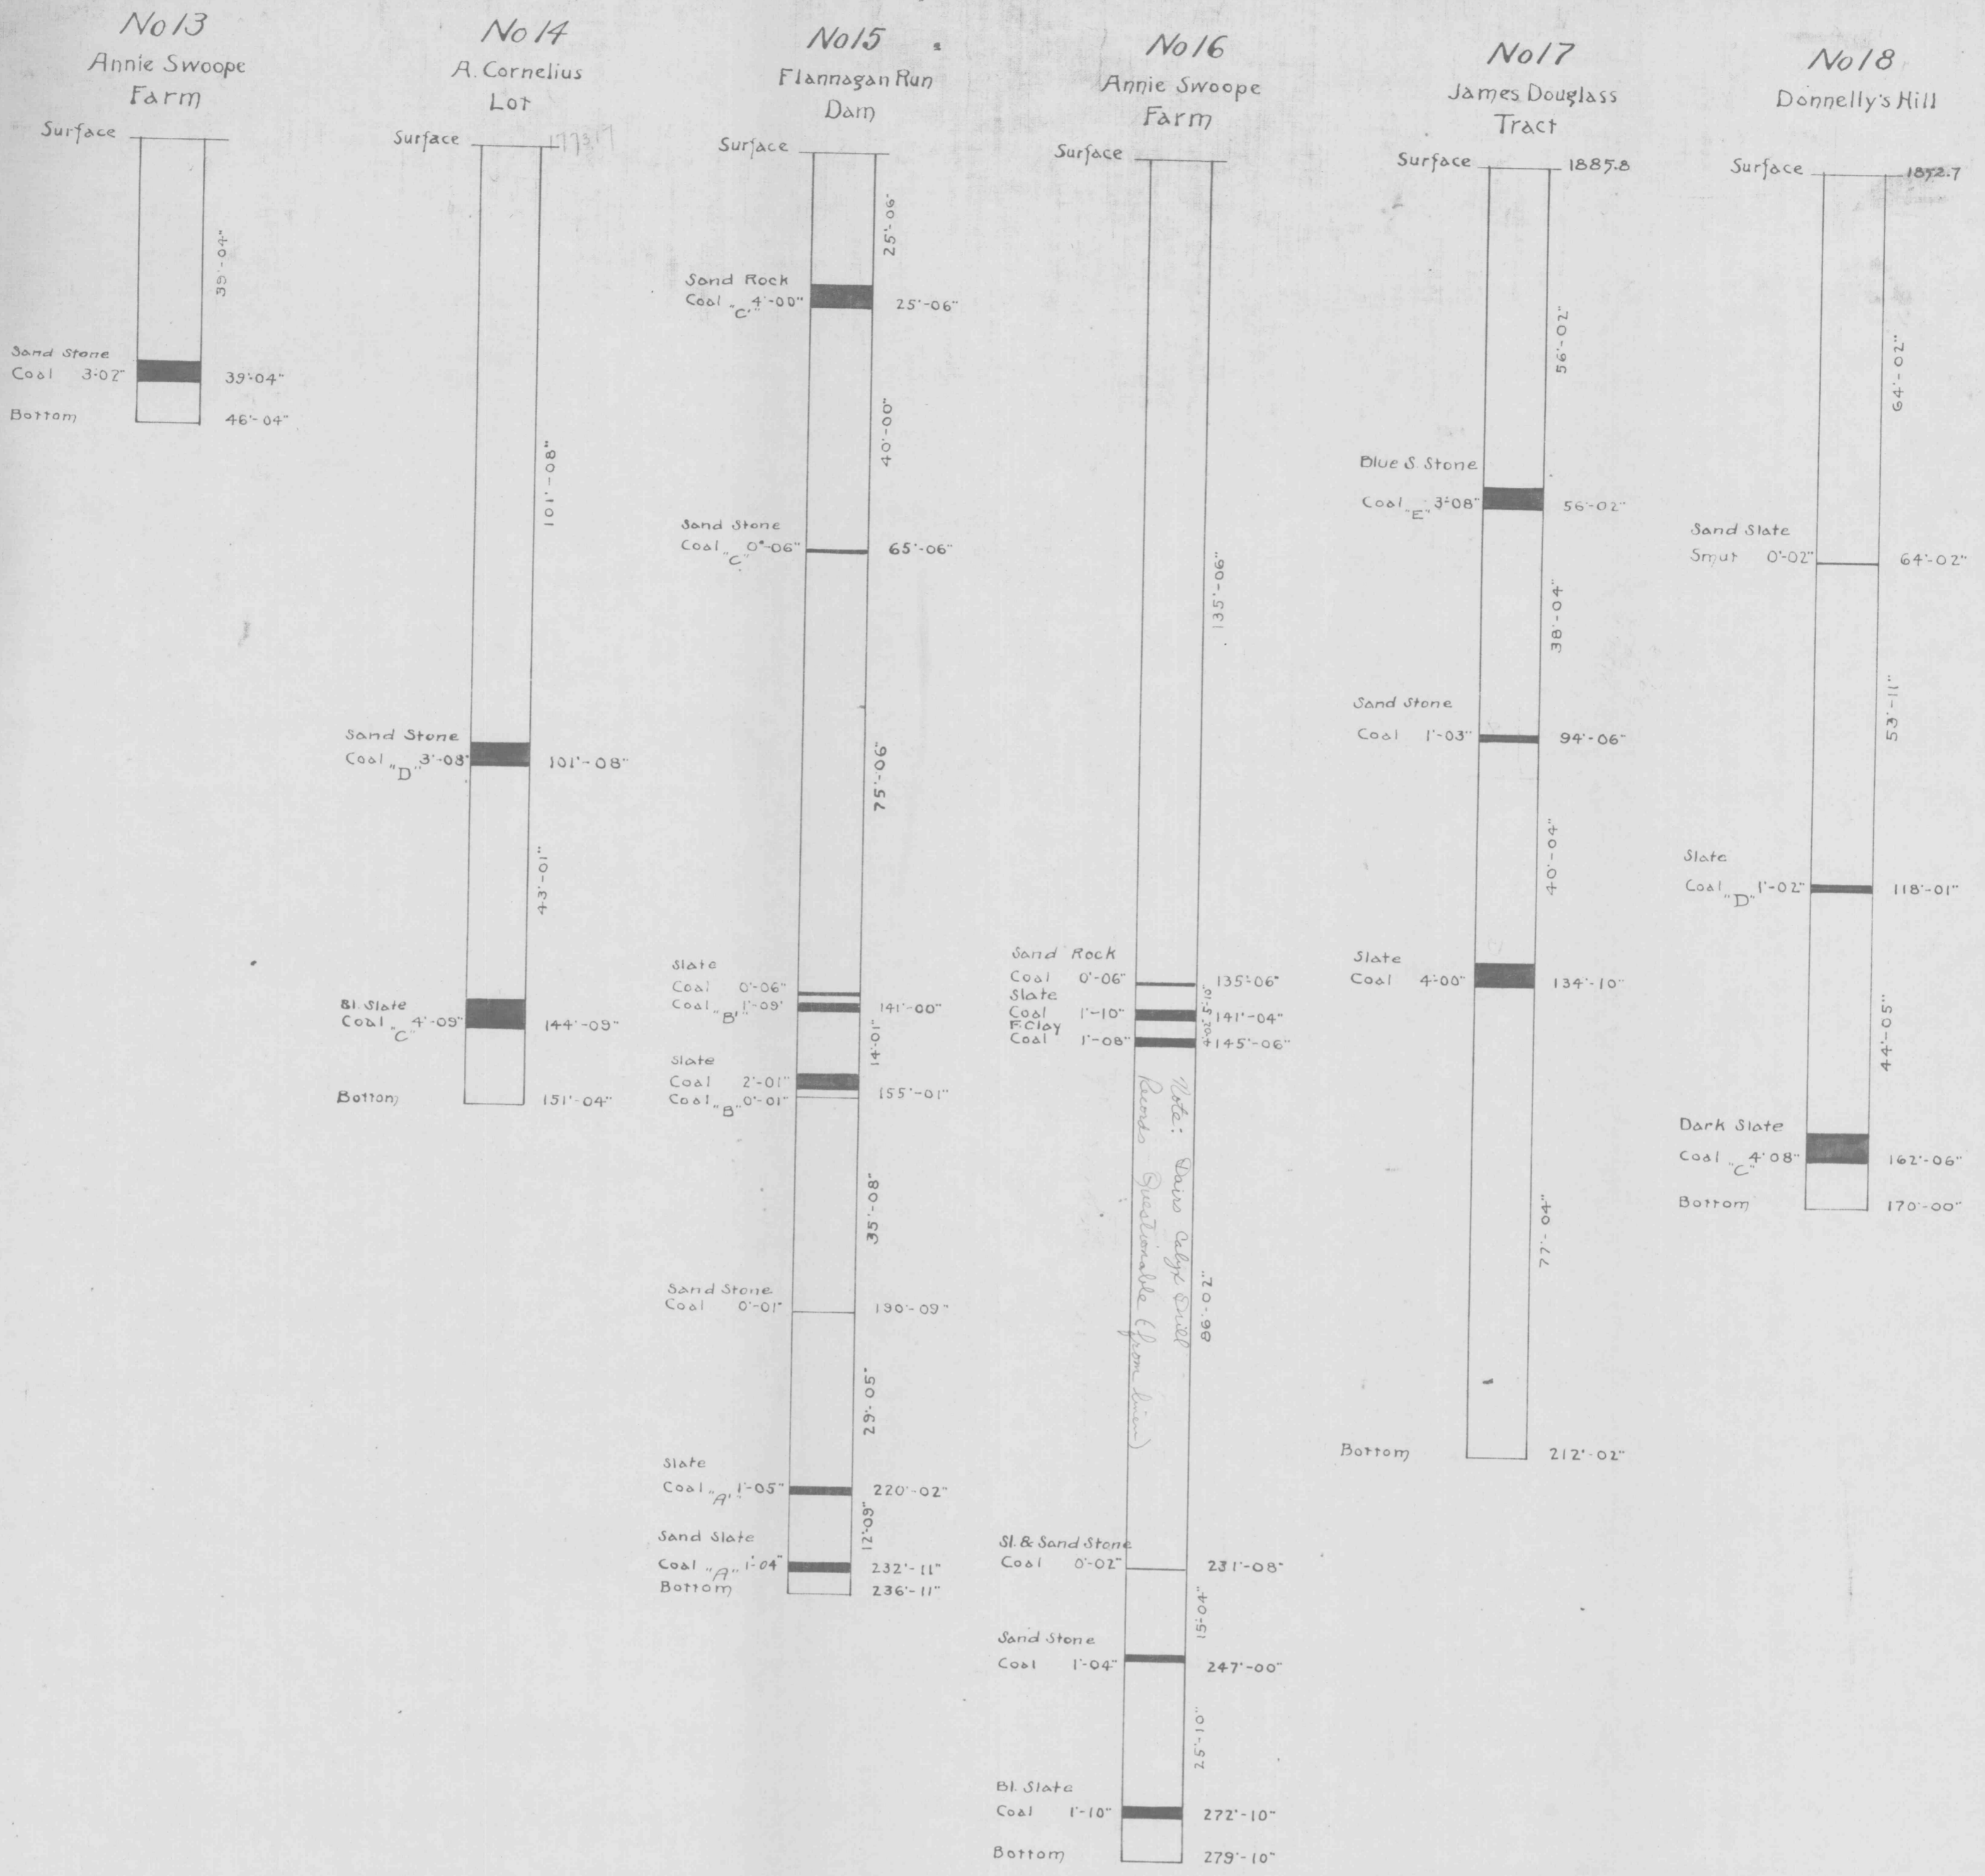

A-430-5
A-430-2