


DRILL HOLE RECORDS

Pennsylvania Coal & Coke Co.

Patton Engineering Division

Patton Group

Drawing No. 4655-3
A-430-3

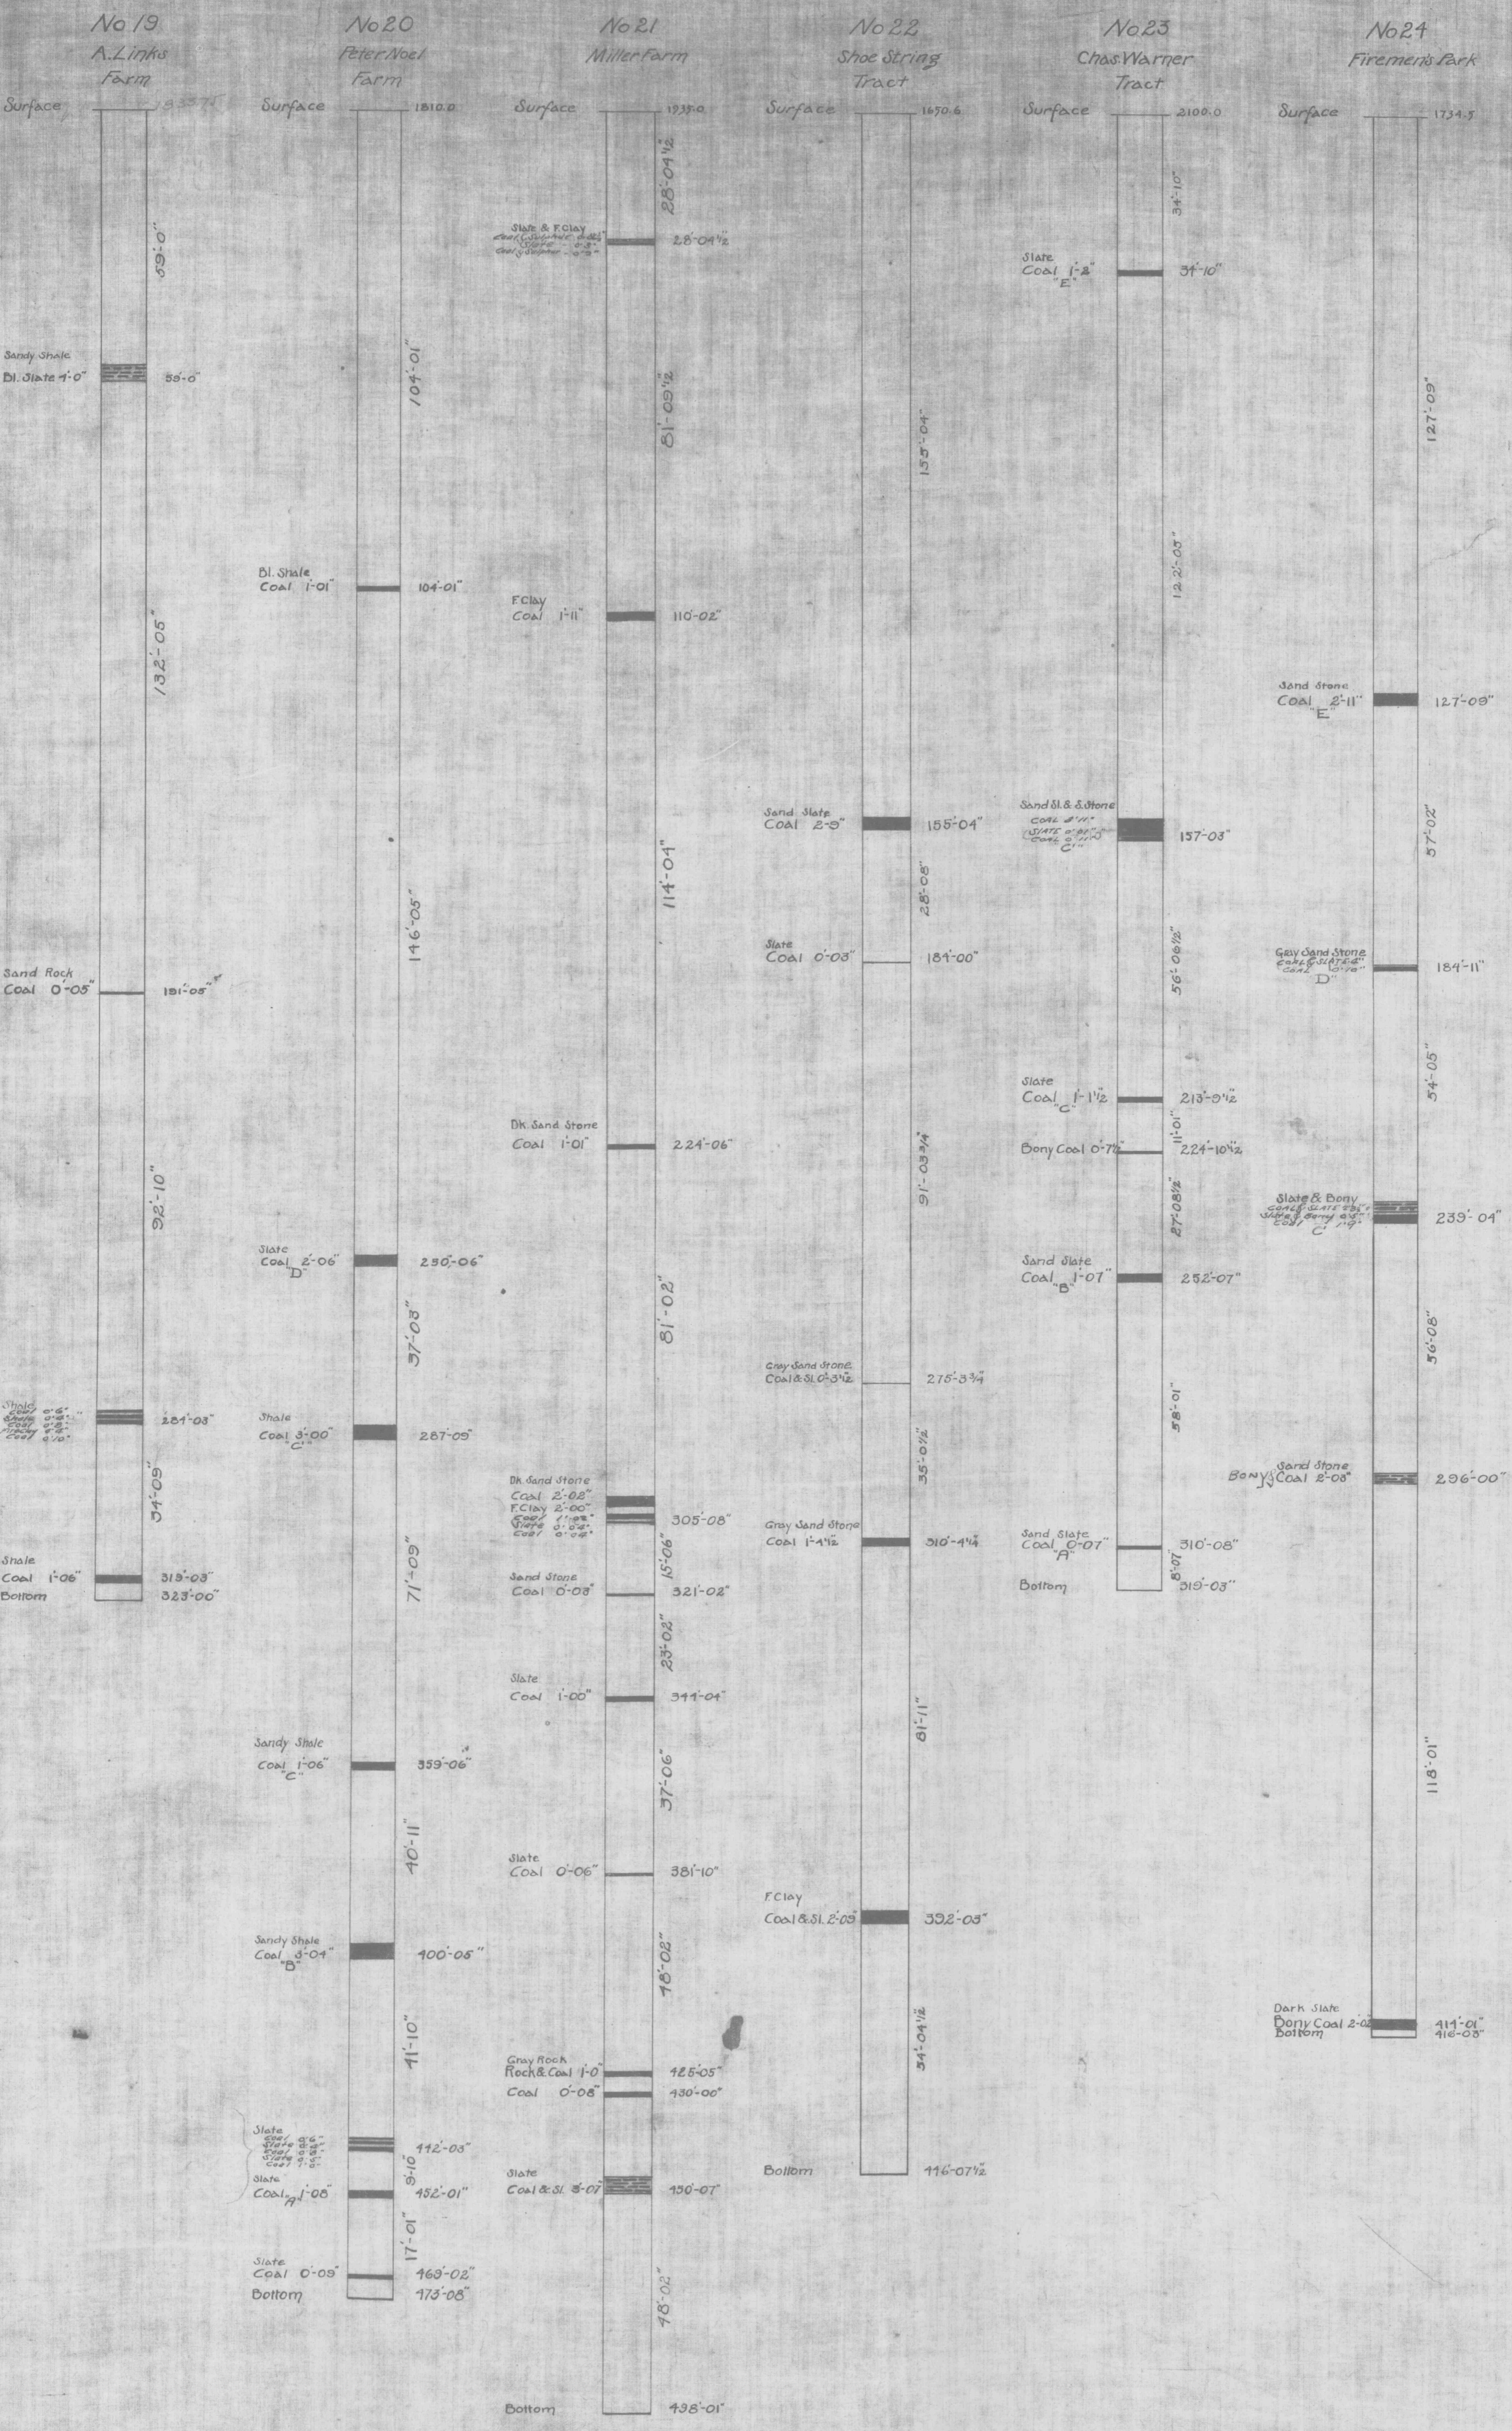

A-430-3
A-430-3