


DRILL HOLE RECORDS

Pennsylvania Coal & Coke Co.

Patton Engineering Division

Patton Group

Drawing No. A430-4
A-430-4

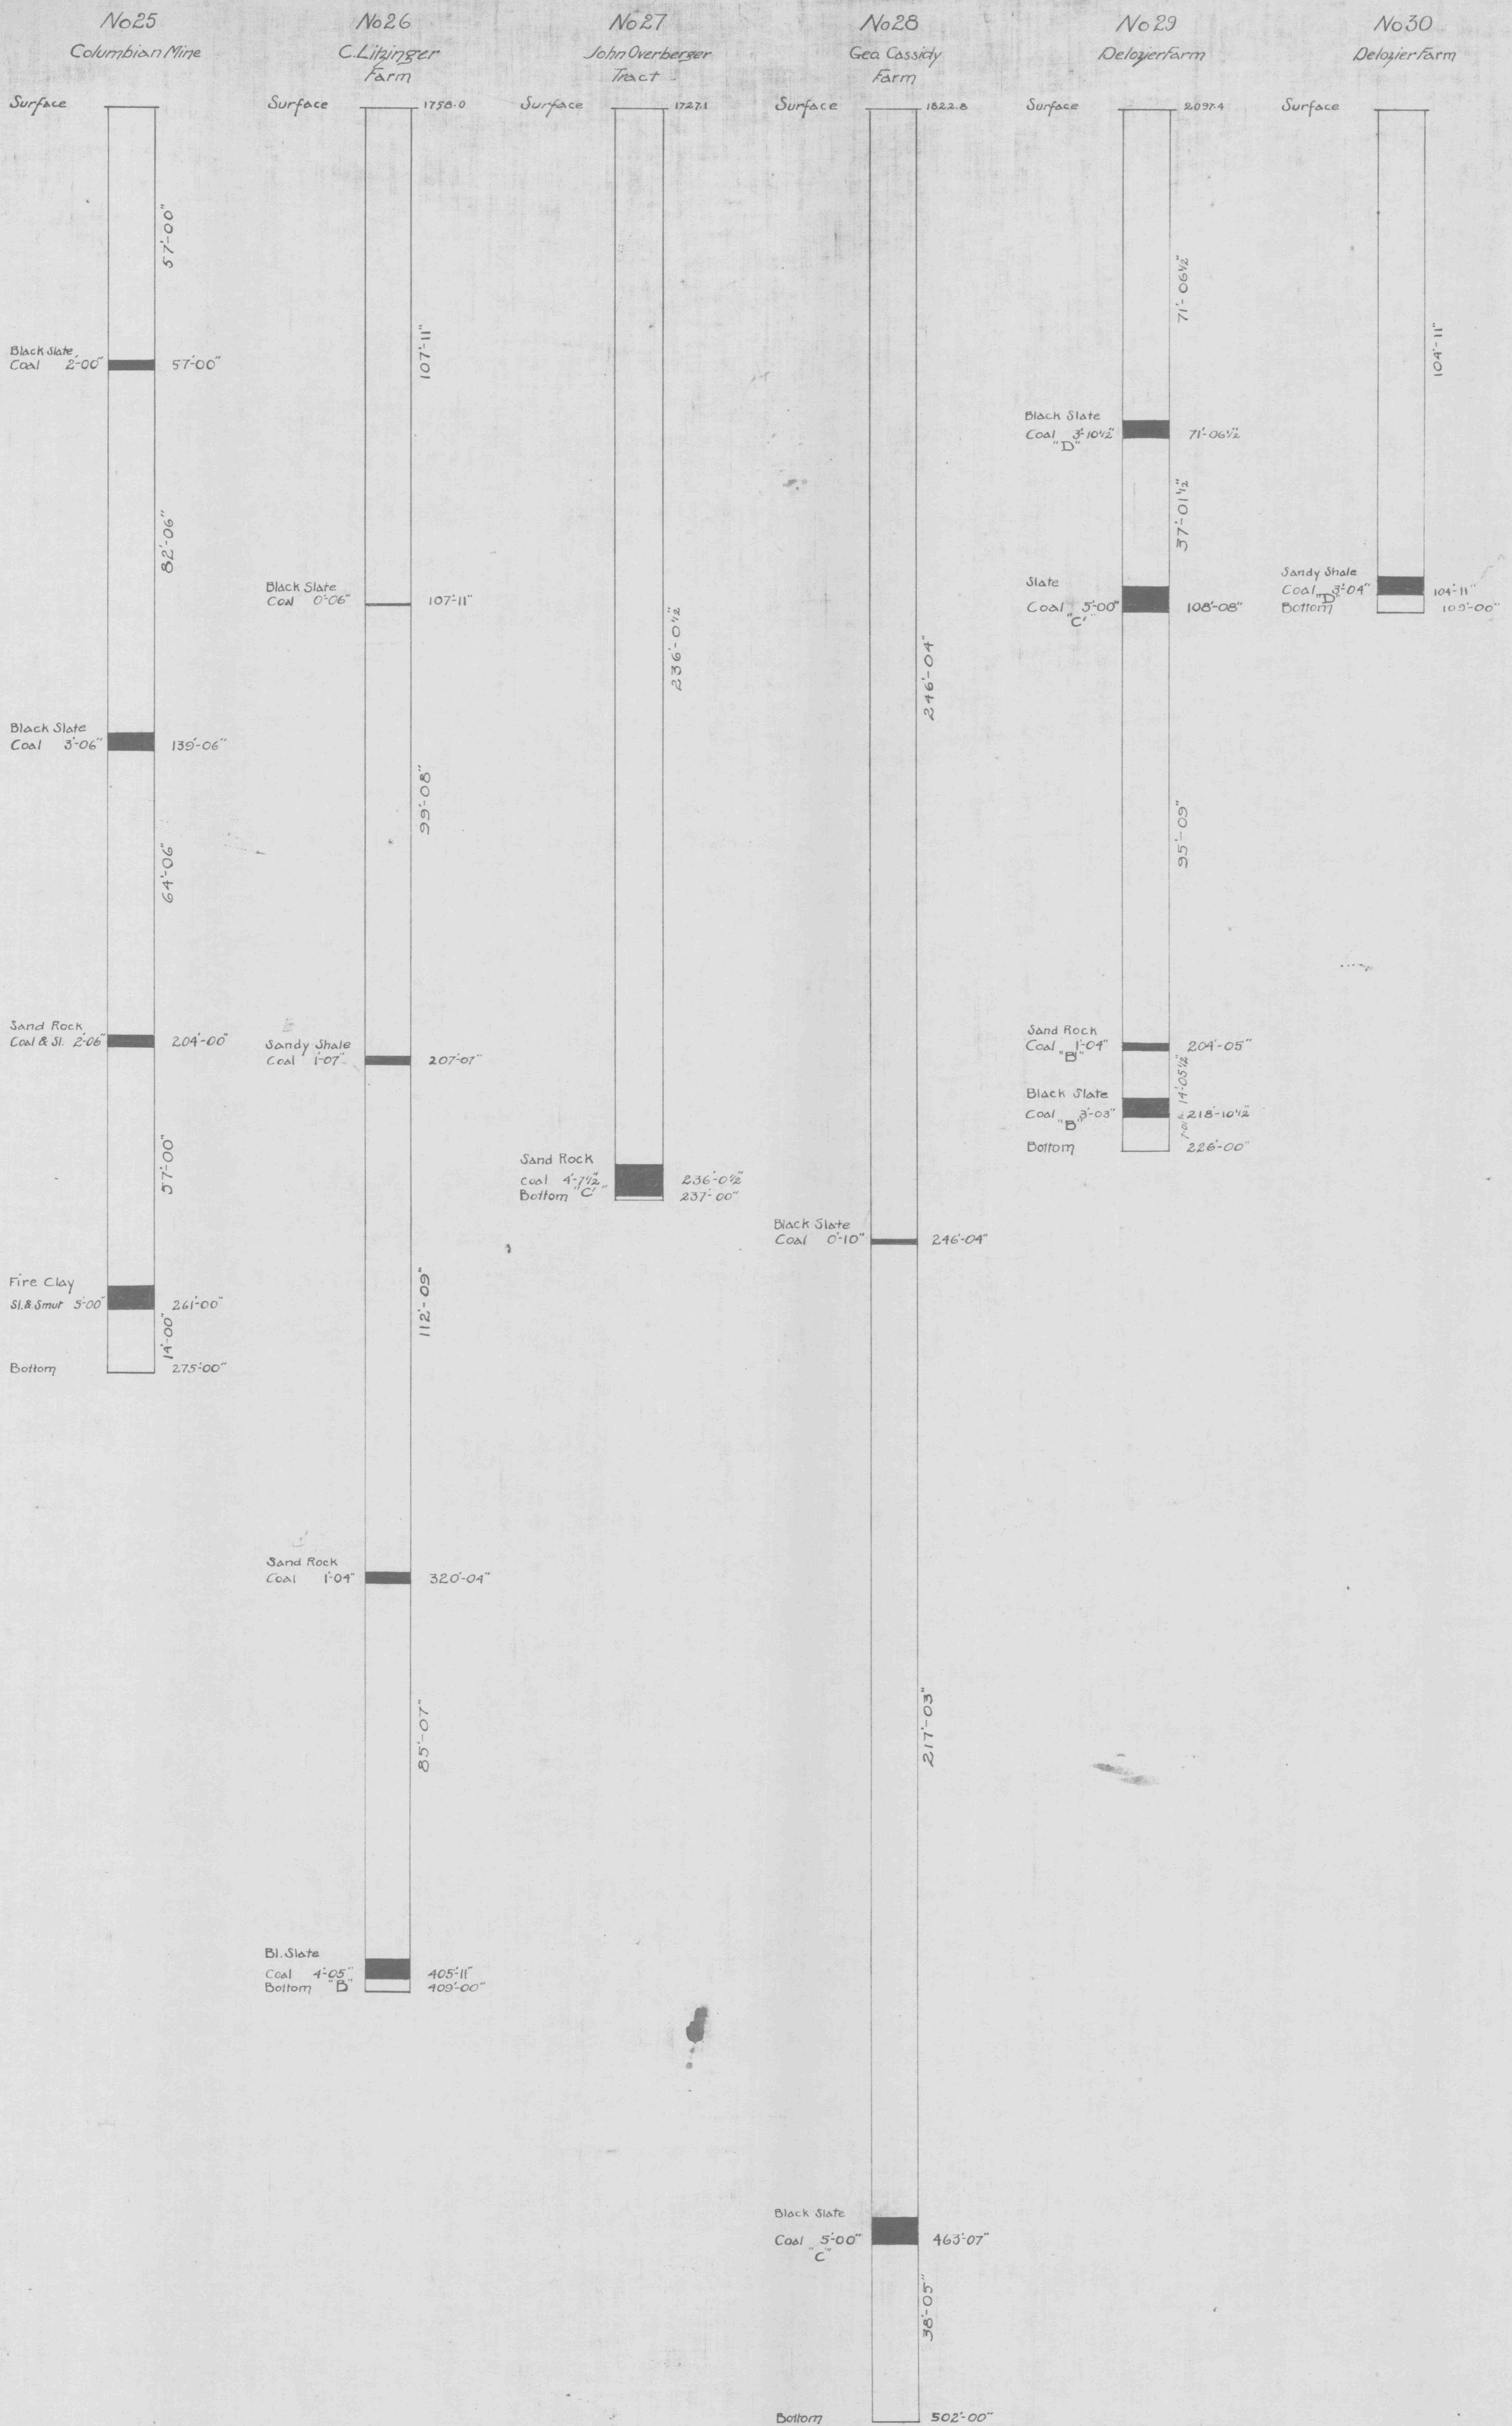

A-430-4
A-430-4