


55-A-2

9091 19107 0 240 2 160 10/15/05 2 102217
Cresson & Clearfield C. & C. Co.

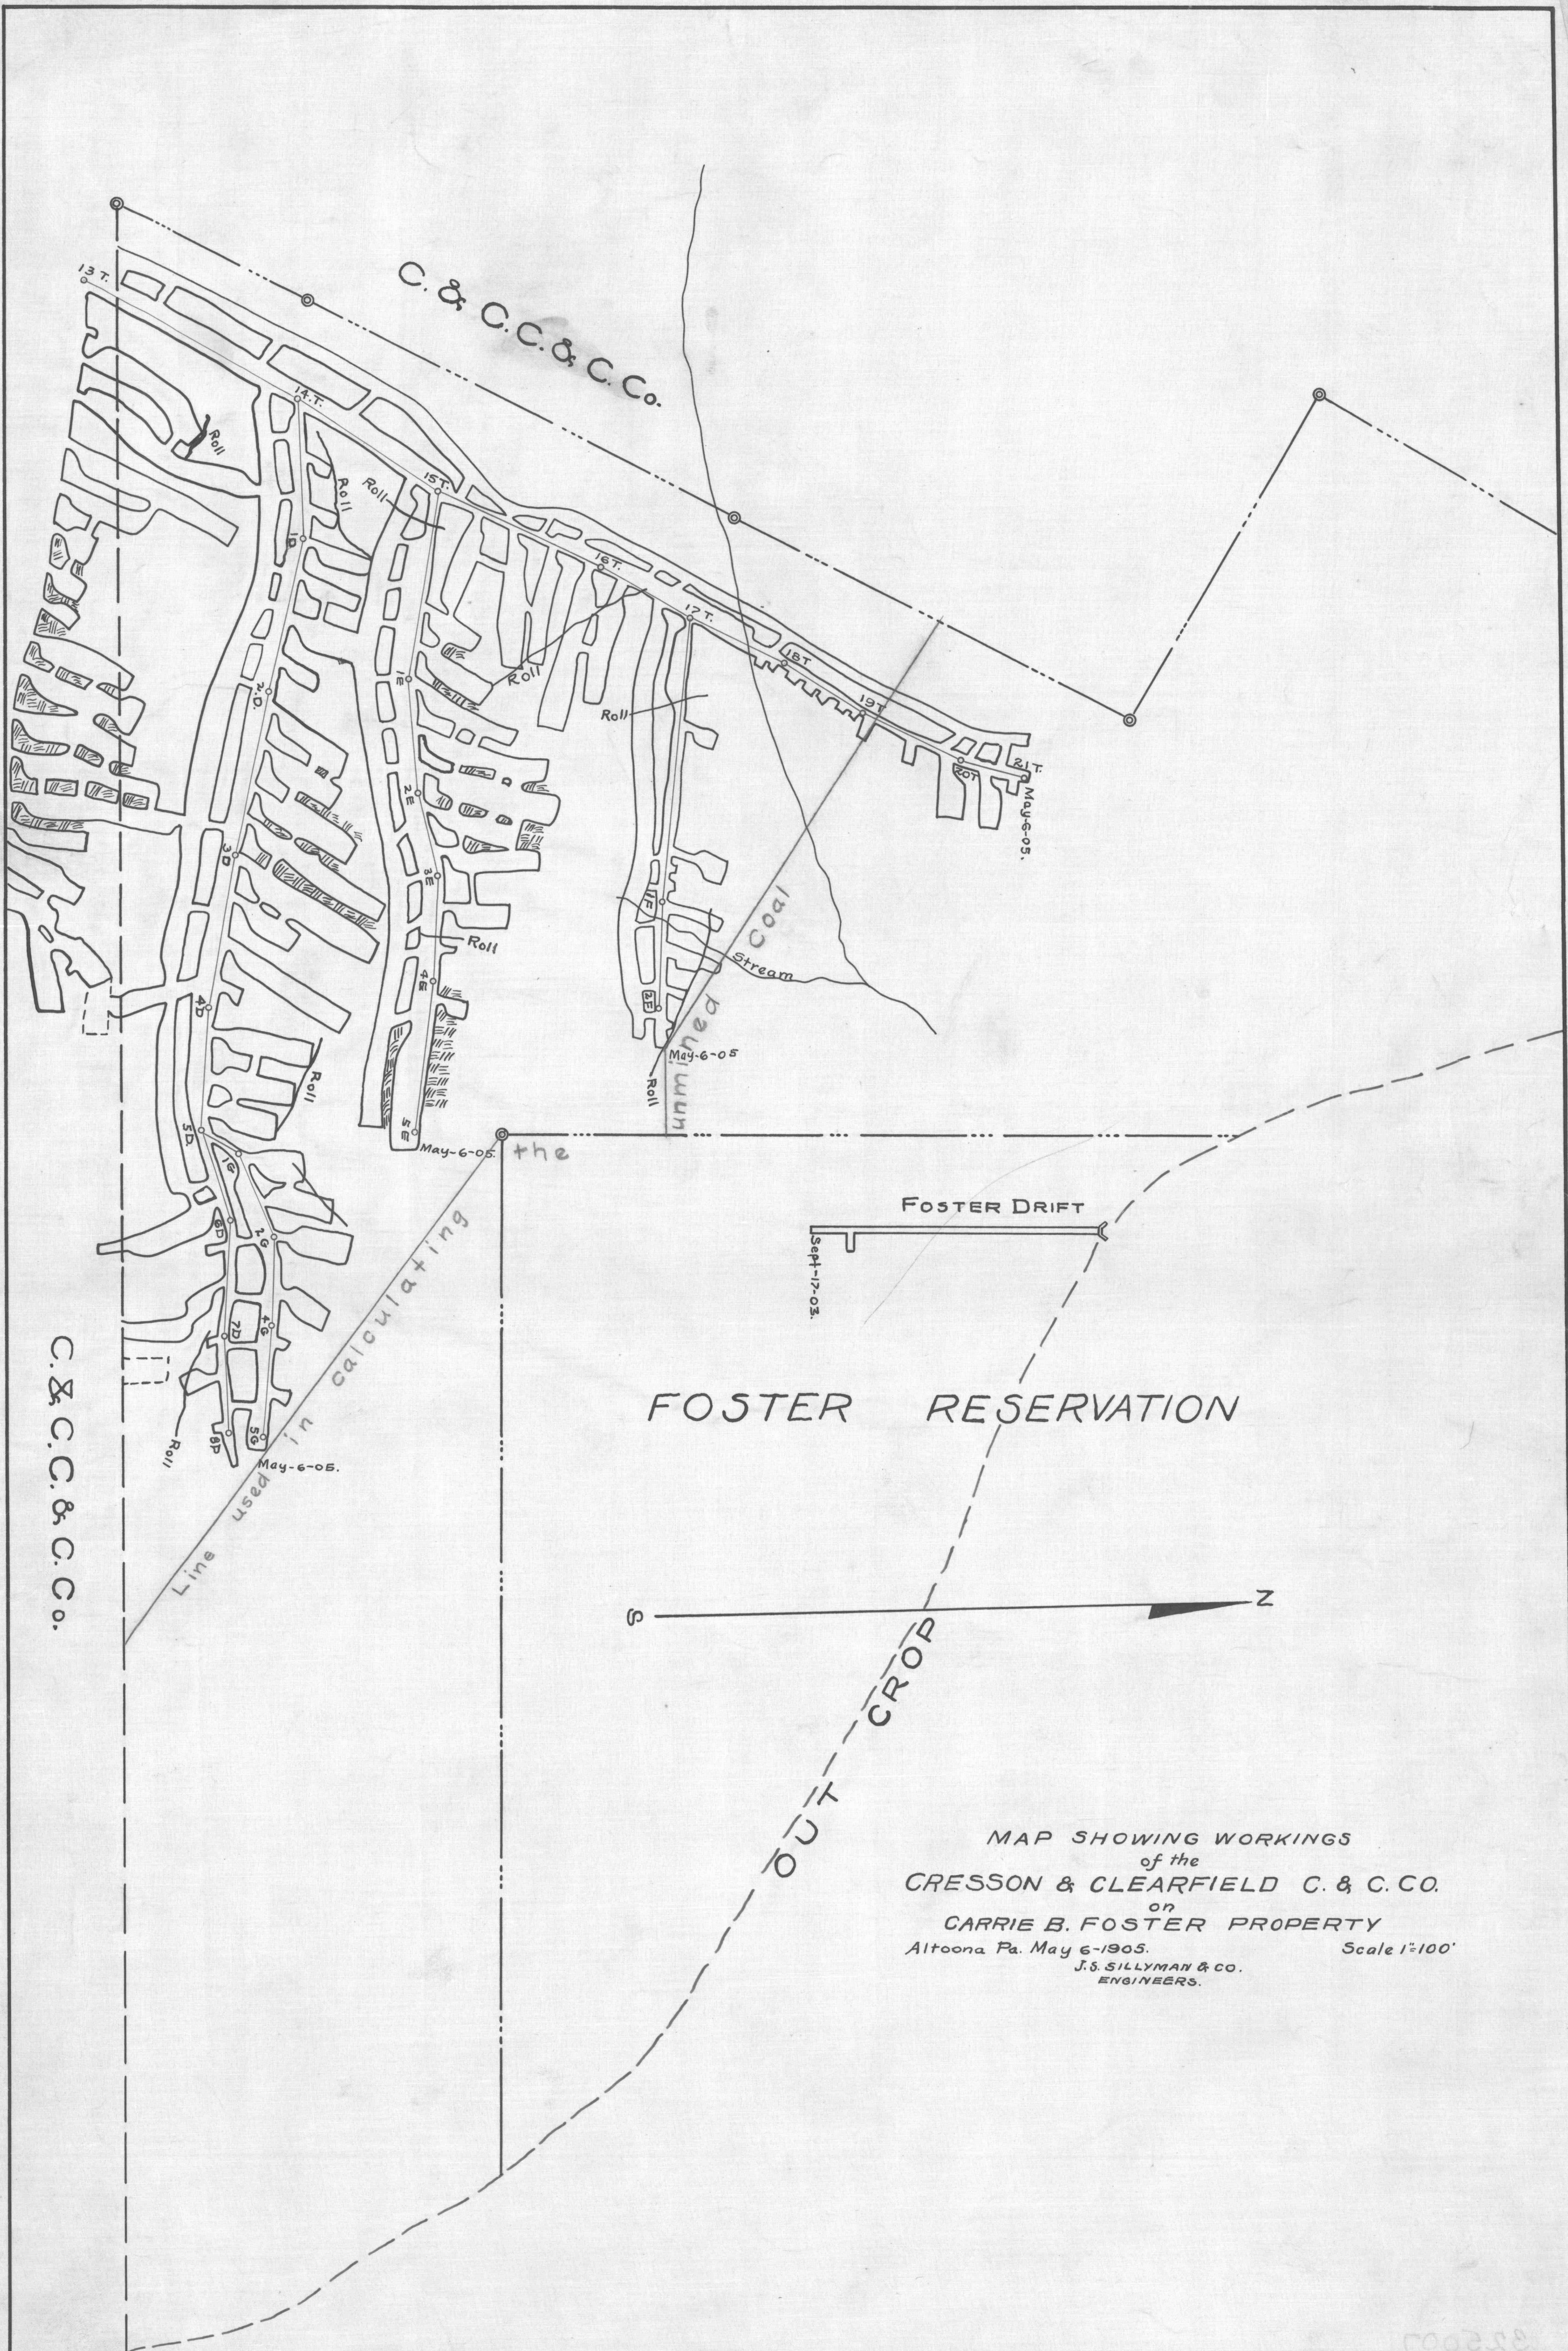

C. & C. C. & C. Co.

C. & C. C. & C. Co.

FOSTER RESERVATION

FOSTER DRIFT

Sept-17-05

S N

CROP

MAP SHOWING WORKINGS
of the
CRESSON & CLEARFIELD C. & C. CO.
on
CARRIE B. FOSTER PROPERTY
Altoona Pa. May 6-1905. Scale 1"=100'
J.S. SILLYMAN & CO.
ENGINEERS.

Line used in calculating

DM-96
B-18

10/15/05 #32

32002