71900
26200
1245600
122800 - 50' scale
5700 sq. ft.

5700 sq. ft. × 3.6667 × 1/27 = 774 Gr. Tons - 11-20-26
5700 sq. ft. × 44/12 × 1/27 = 774 gr. tons 11-20-26
1485 sq. ft. × 3.75 × 1/27 = 206 gr. tons - 12-21-27
1st Enc. 774 G.T. 1st Min.
2nd " 206 G.T. "

3-8
3-6½
3-9
3-10½
3-7
5 | 18-41
3-8" Av.

774 G.T. 1st Mining 11-20-26
160 G.T. Pillars Std. 11-20-26
934 G.T. Total 11-20-26
206 " 1st Mining 12-21-27
1140 G.T. Total - 12-21-27

STATEMENT OF COAL MINED BY AND REMAINING IN PILLARS DUE TO EDWARD J. LIPNIC ENCROACHMENT

ENCROACHMENTS	FIRST MINING (GROSS TONS)	PILLARS ROBBED (GROSS TONS)	PILLARS REMAINING (GROSS TONS)	TOTAL (GROSS TONS)
FIRST	774	—	—	774
SECOND	206	(a) 81	239	526
TOTAL	980	81	239	1300

(a) Pillars in which the coal is either robbed or lost by caves.

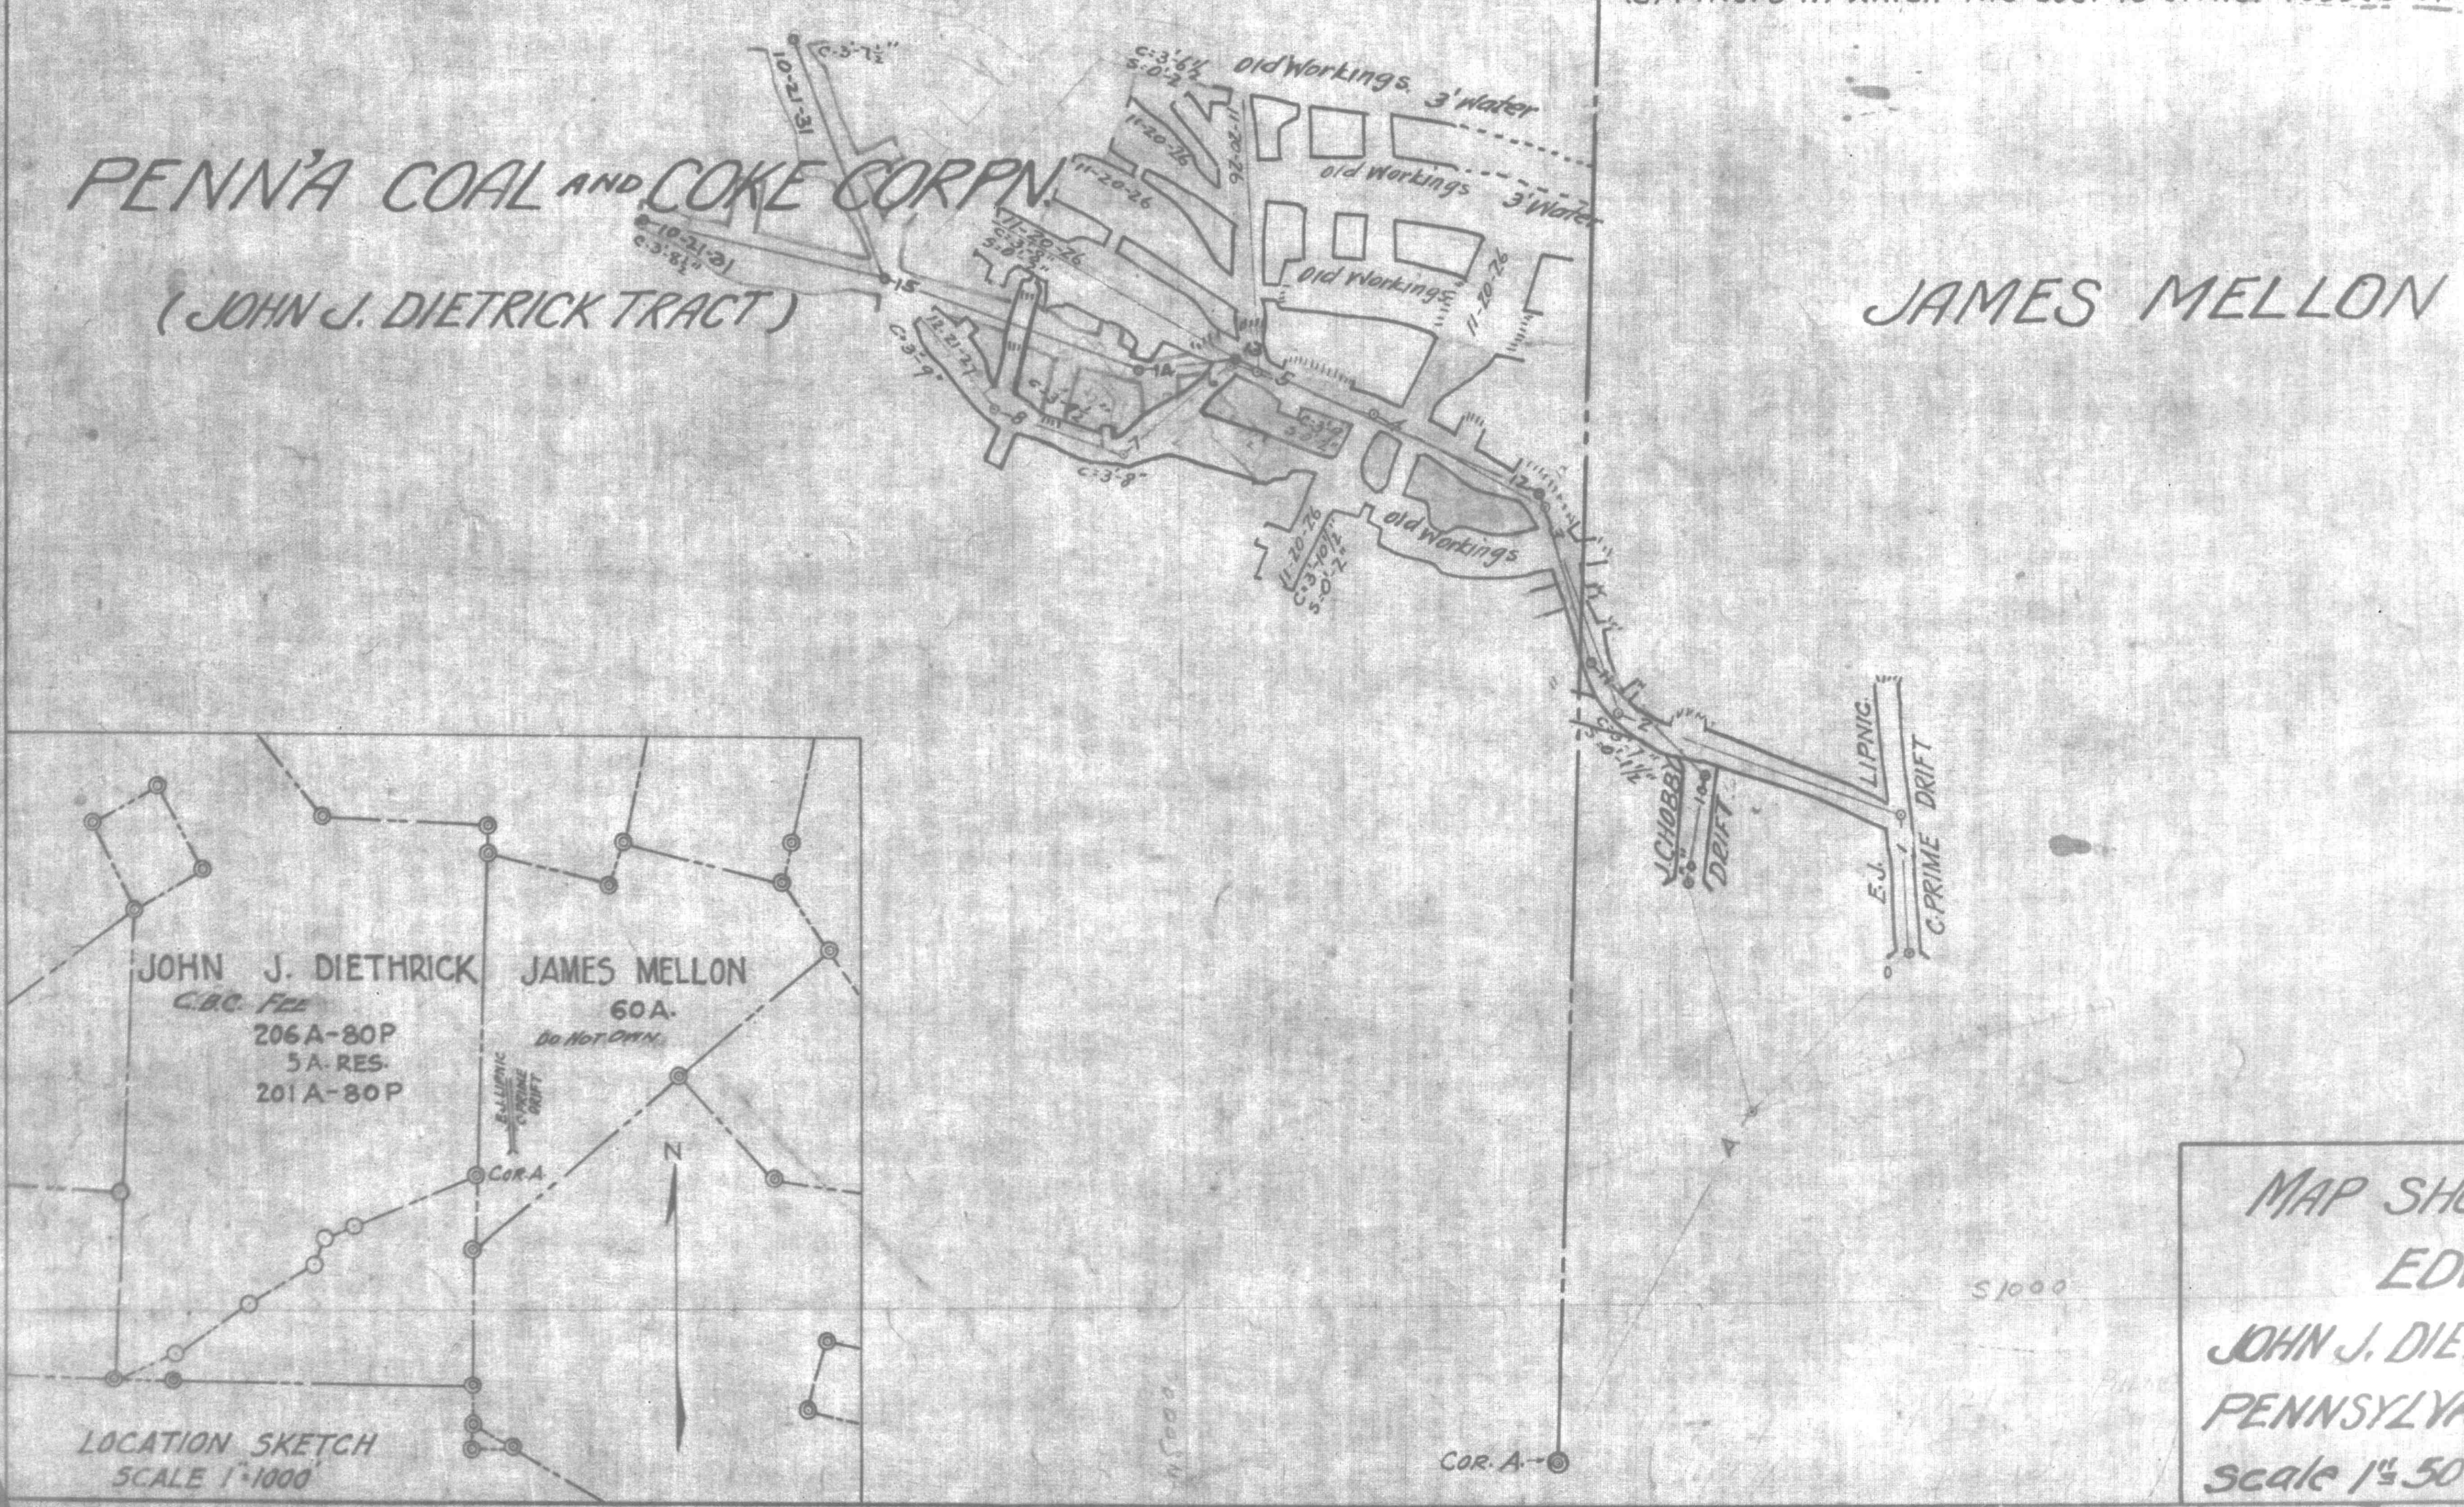

MAP SHOWING MINE WORKINGS OF EDWARD J. LIPNIC ON THE JOHN J. DIETRICK TRACT, PROPERTY OF THE PENNSYLVANIA COAL AND COKE CORPN.

Scale 1" = 50' Patton, Pa., Nov. 27, 1926

JOHN CHOBBY ENCROACHMENT 10-21-31 : 344 G.T.