


GEORGE & CHARLES KIBLER
62A.32P.

All seams Leased to Penna. Coal and Coke Corp'n.
by Clearfield Bituminous Coal Corp'n.

391 47 Mine owned by
Frank Schwab
9-21-36

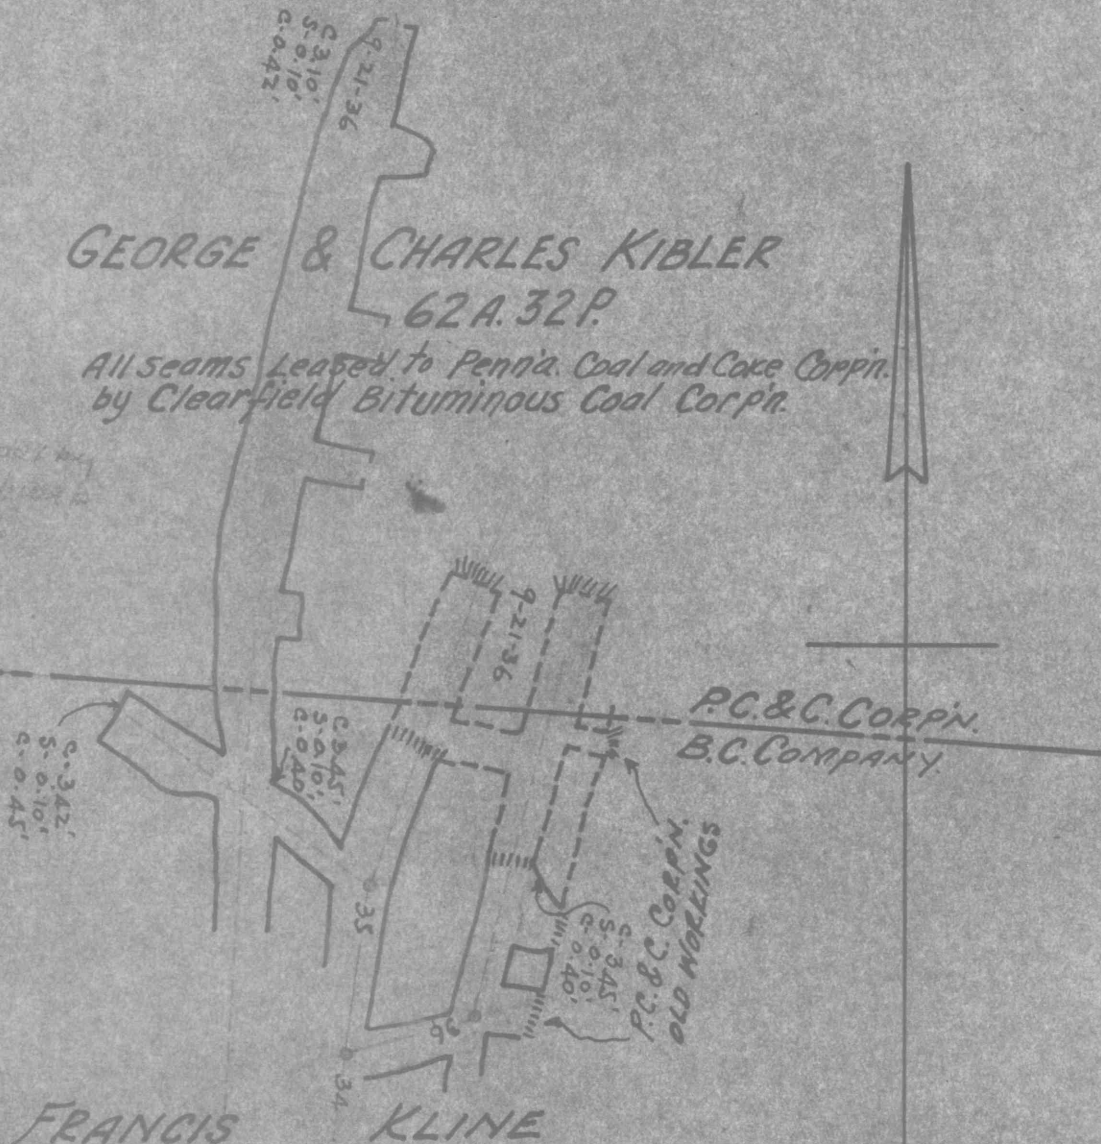

PENNSYLVANIA COAL AND COKE CORPORATION

MAP SHOWING ENCROACHMENT
MADE BY THE D-SEAM MINE WORKINGS OF
FRANK SCHWAB, PATTON, PA.

ON THE
GEORGE & CHARLES KIBLER 62A.32P TRACT
Elder Township, Cambria County, Penn'a.
Engr. Dept. P.C. & C. Corp'n. Cresson, Pa.
Scale 1"=40' Sept. 23, 1936.

DWG. 6-1-64