


GEO. M. WALTZ.

PAUL YAHNER.

HEIRS OF JAMES DELOZIER.

J. H. WEAVER.

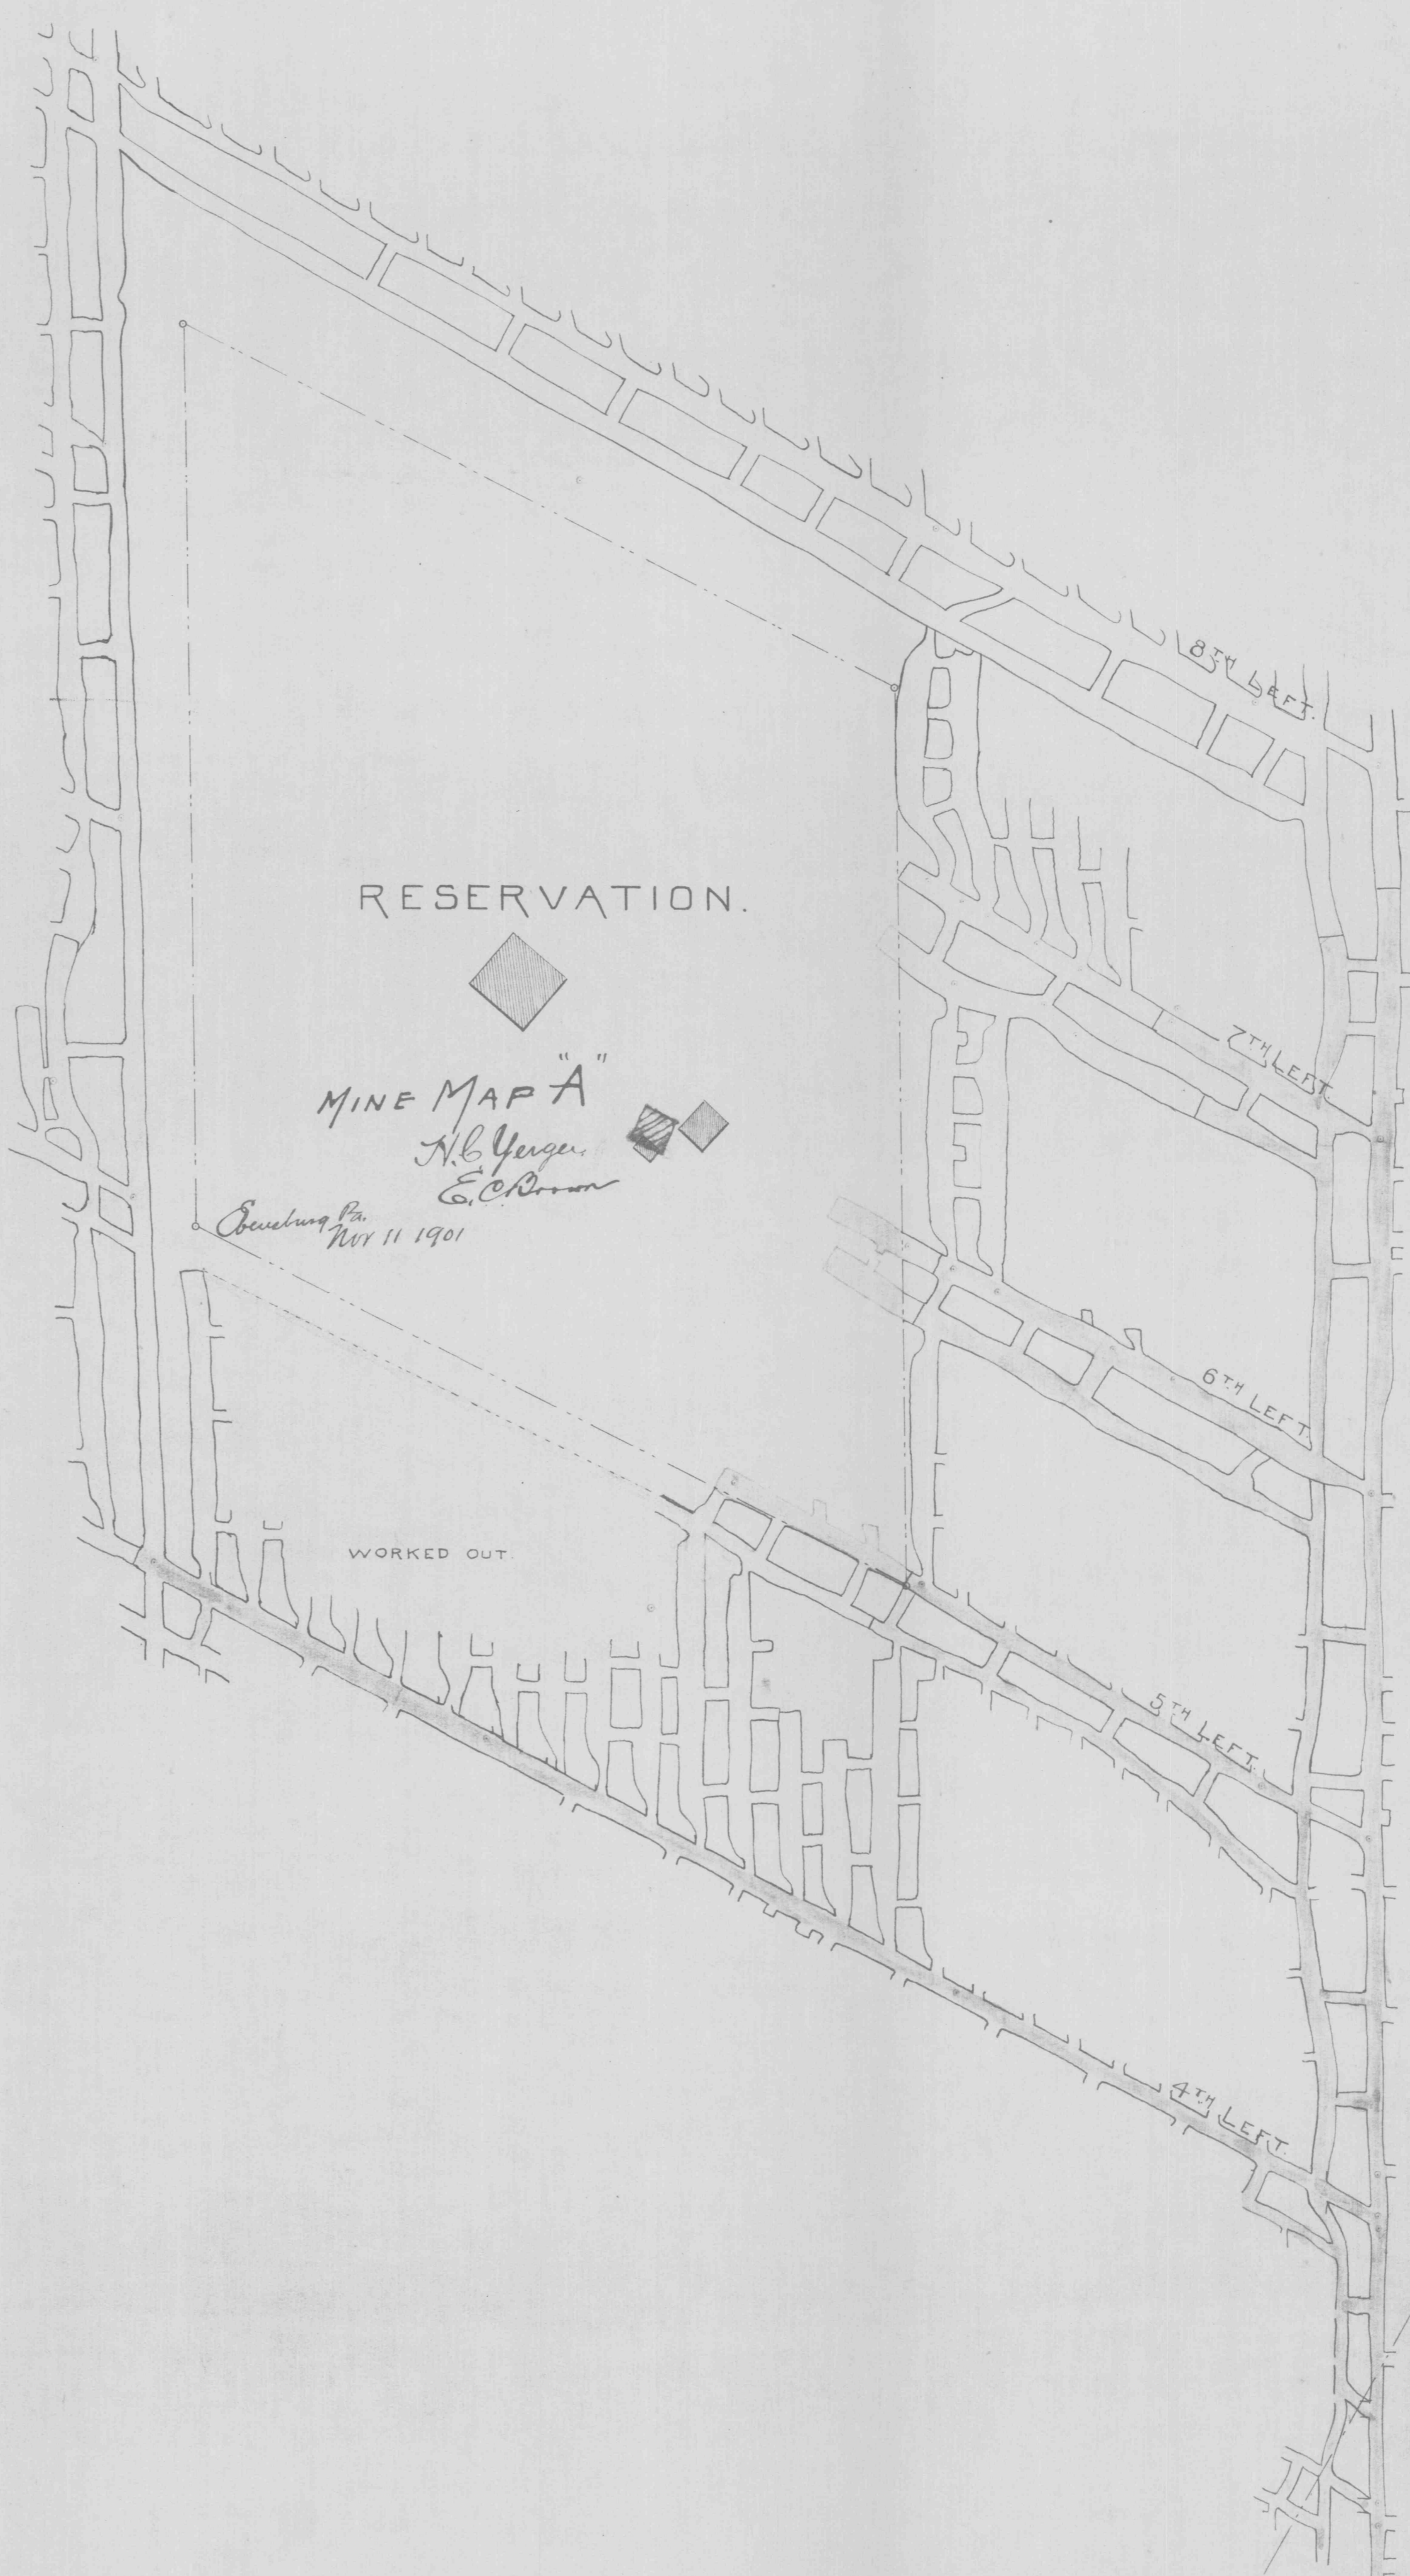

RESERVATION.

MINE MAP "A"

H. B. Yeager.

E. C. Brown

Nov 11 1901

WORKED OUT





C. G. L. & I. Co.

CHAS. ANNA.

MAP SHOWING MINE WORKINGS
OF
PATTON COAL CO. COLLIERY
ADJACENT TO
10 ACRE RESERVATION ON PROPERTY
OF
JAMES DELOZIER'S HEIRS
ELDER TOWNSHIP, CAMBRIA CO., PA.

PIT MOUTH