


N11,400

N11,000

N12,200

66

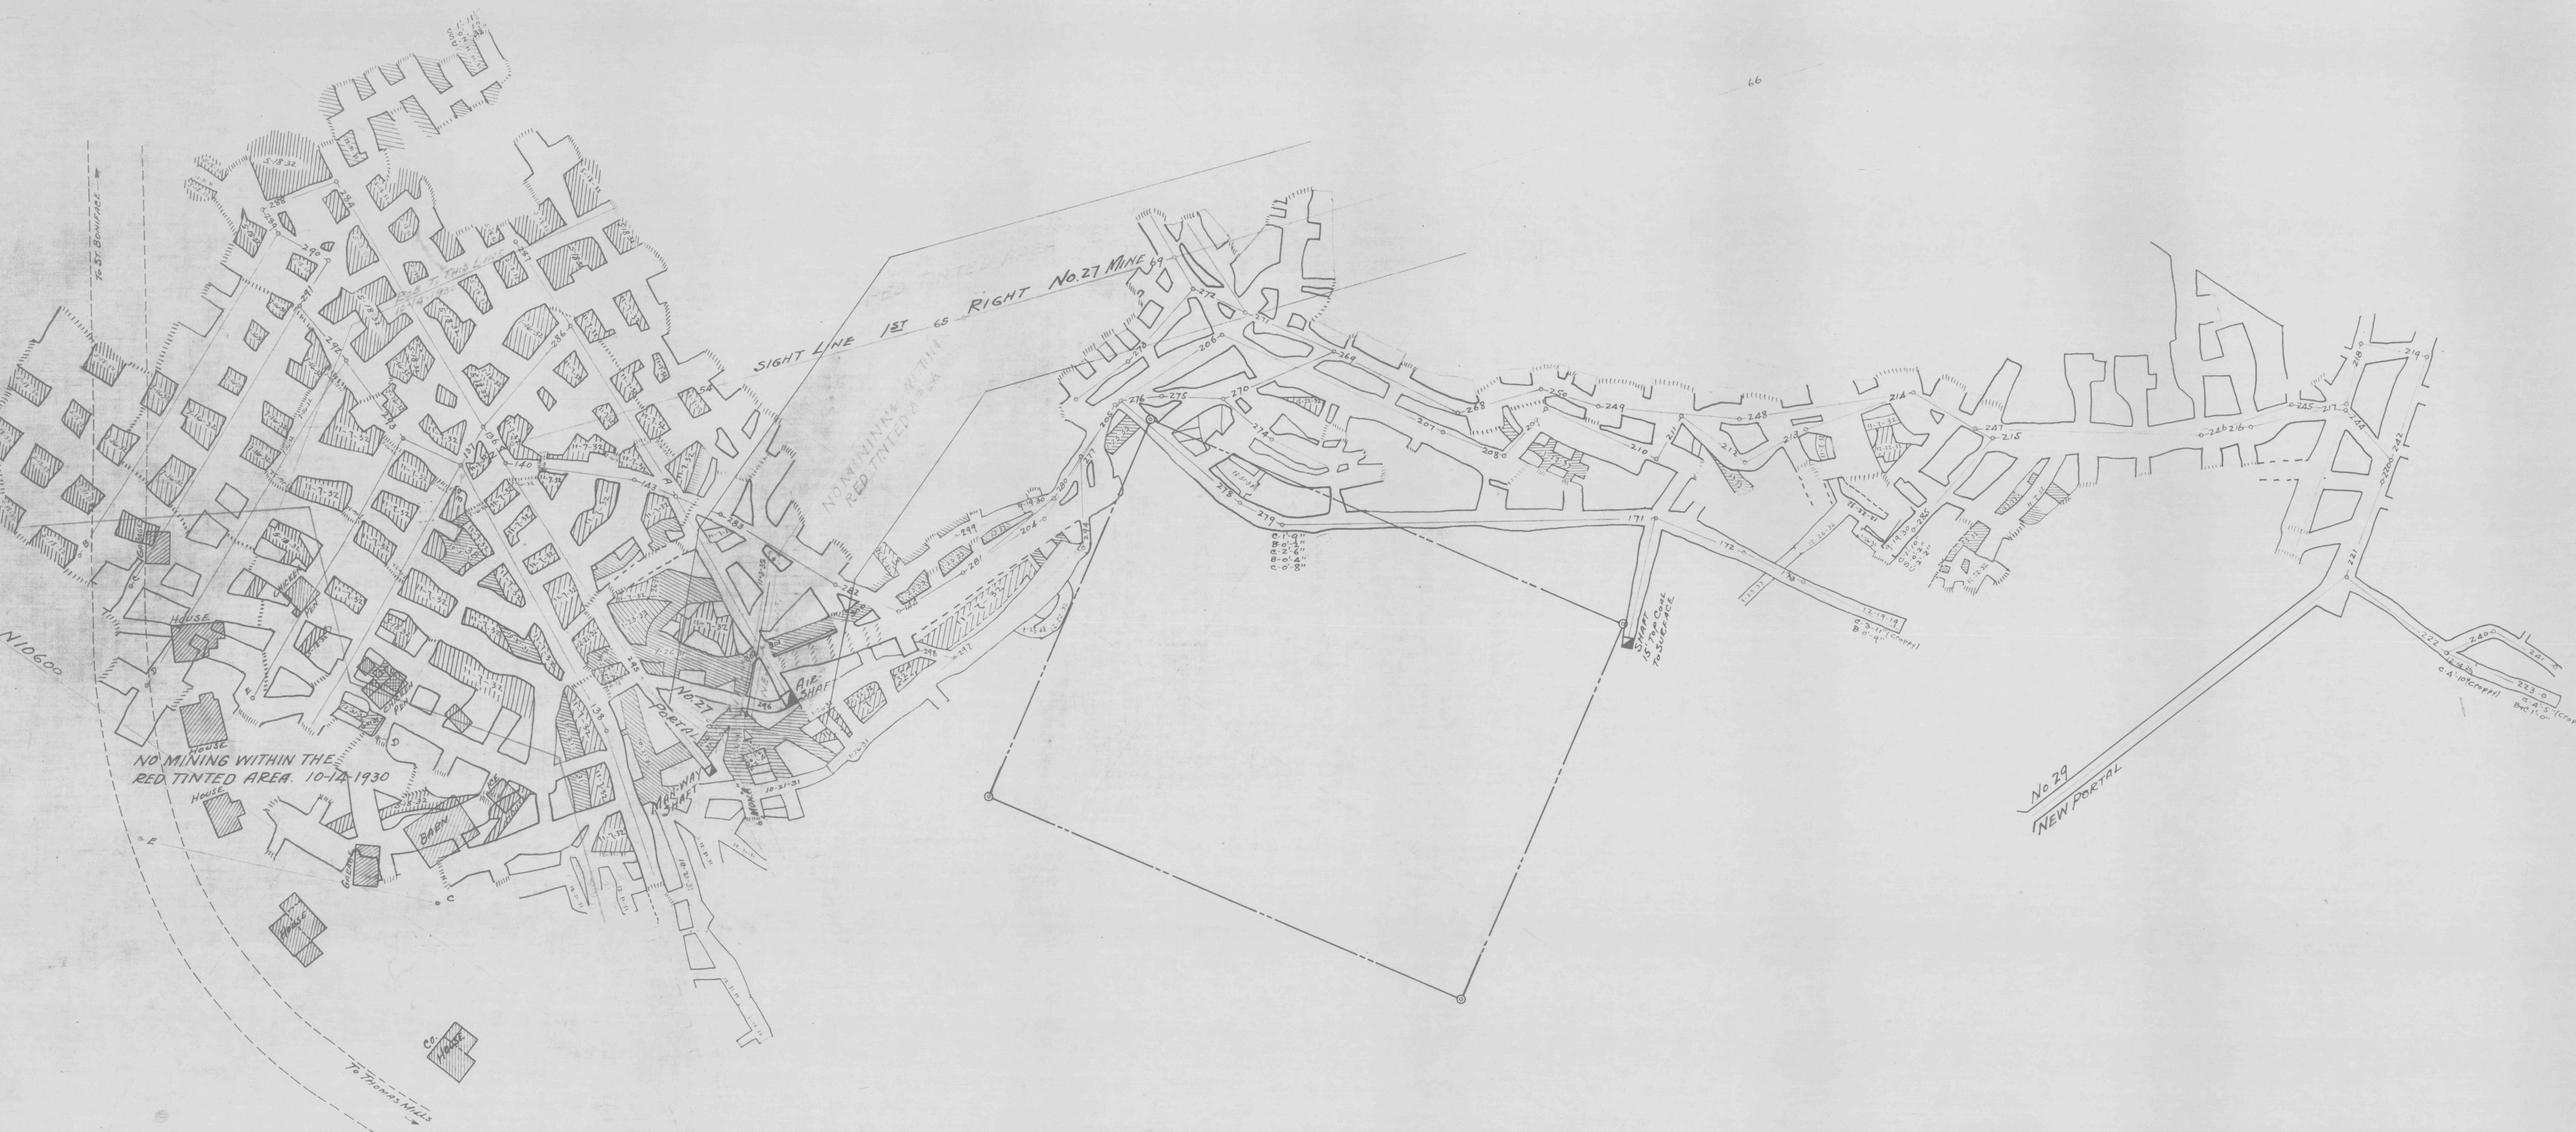

N10,600

NO MINING WITHIN THE RED TINTED AREA. 10-17-1930

No. 29
NEW PORETAL

N11,800

W8,000

W7,600

W8,500

W7,200

W6,800

N11,000

W6,400

N11,400