


ELIZABETH THOMAS

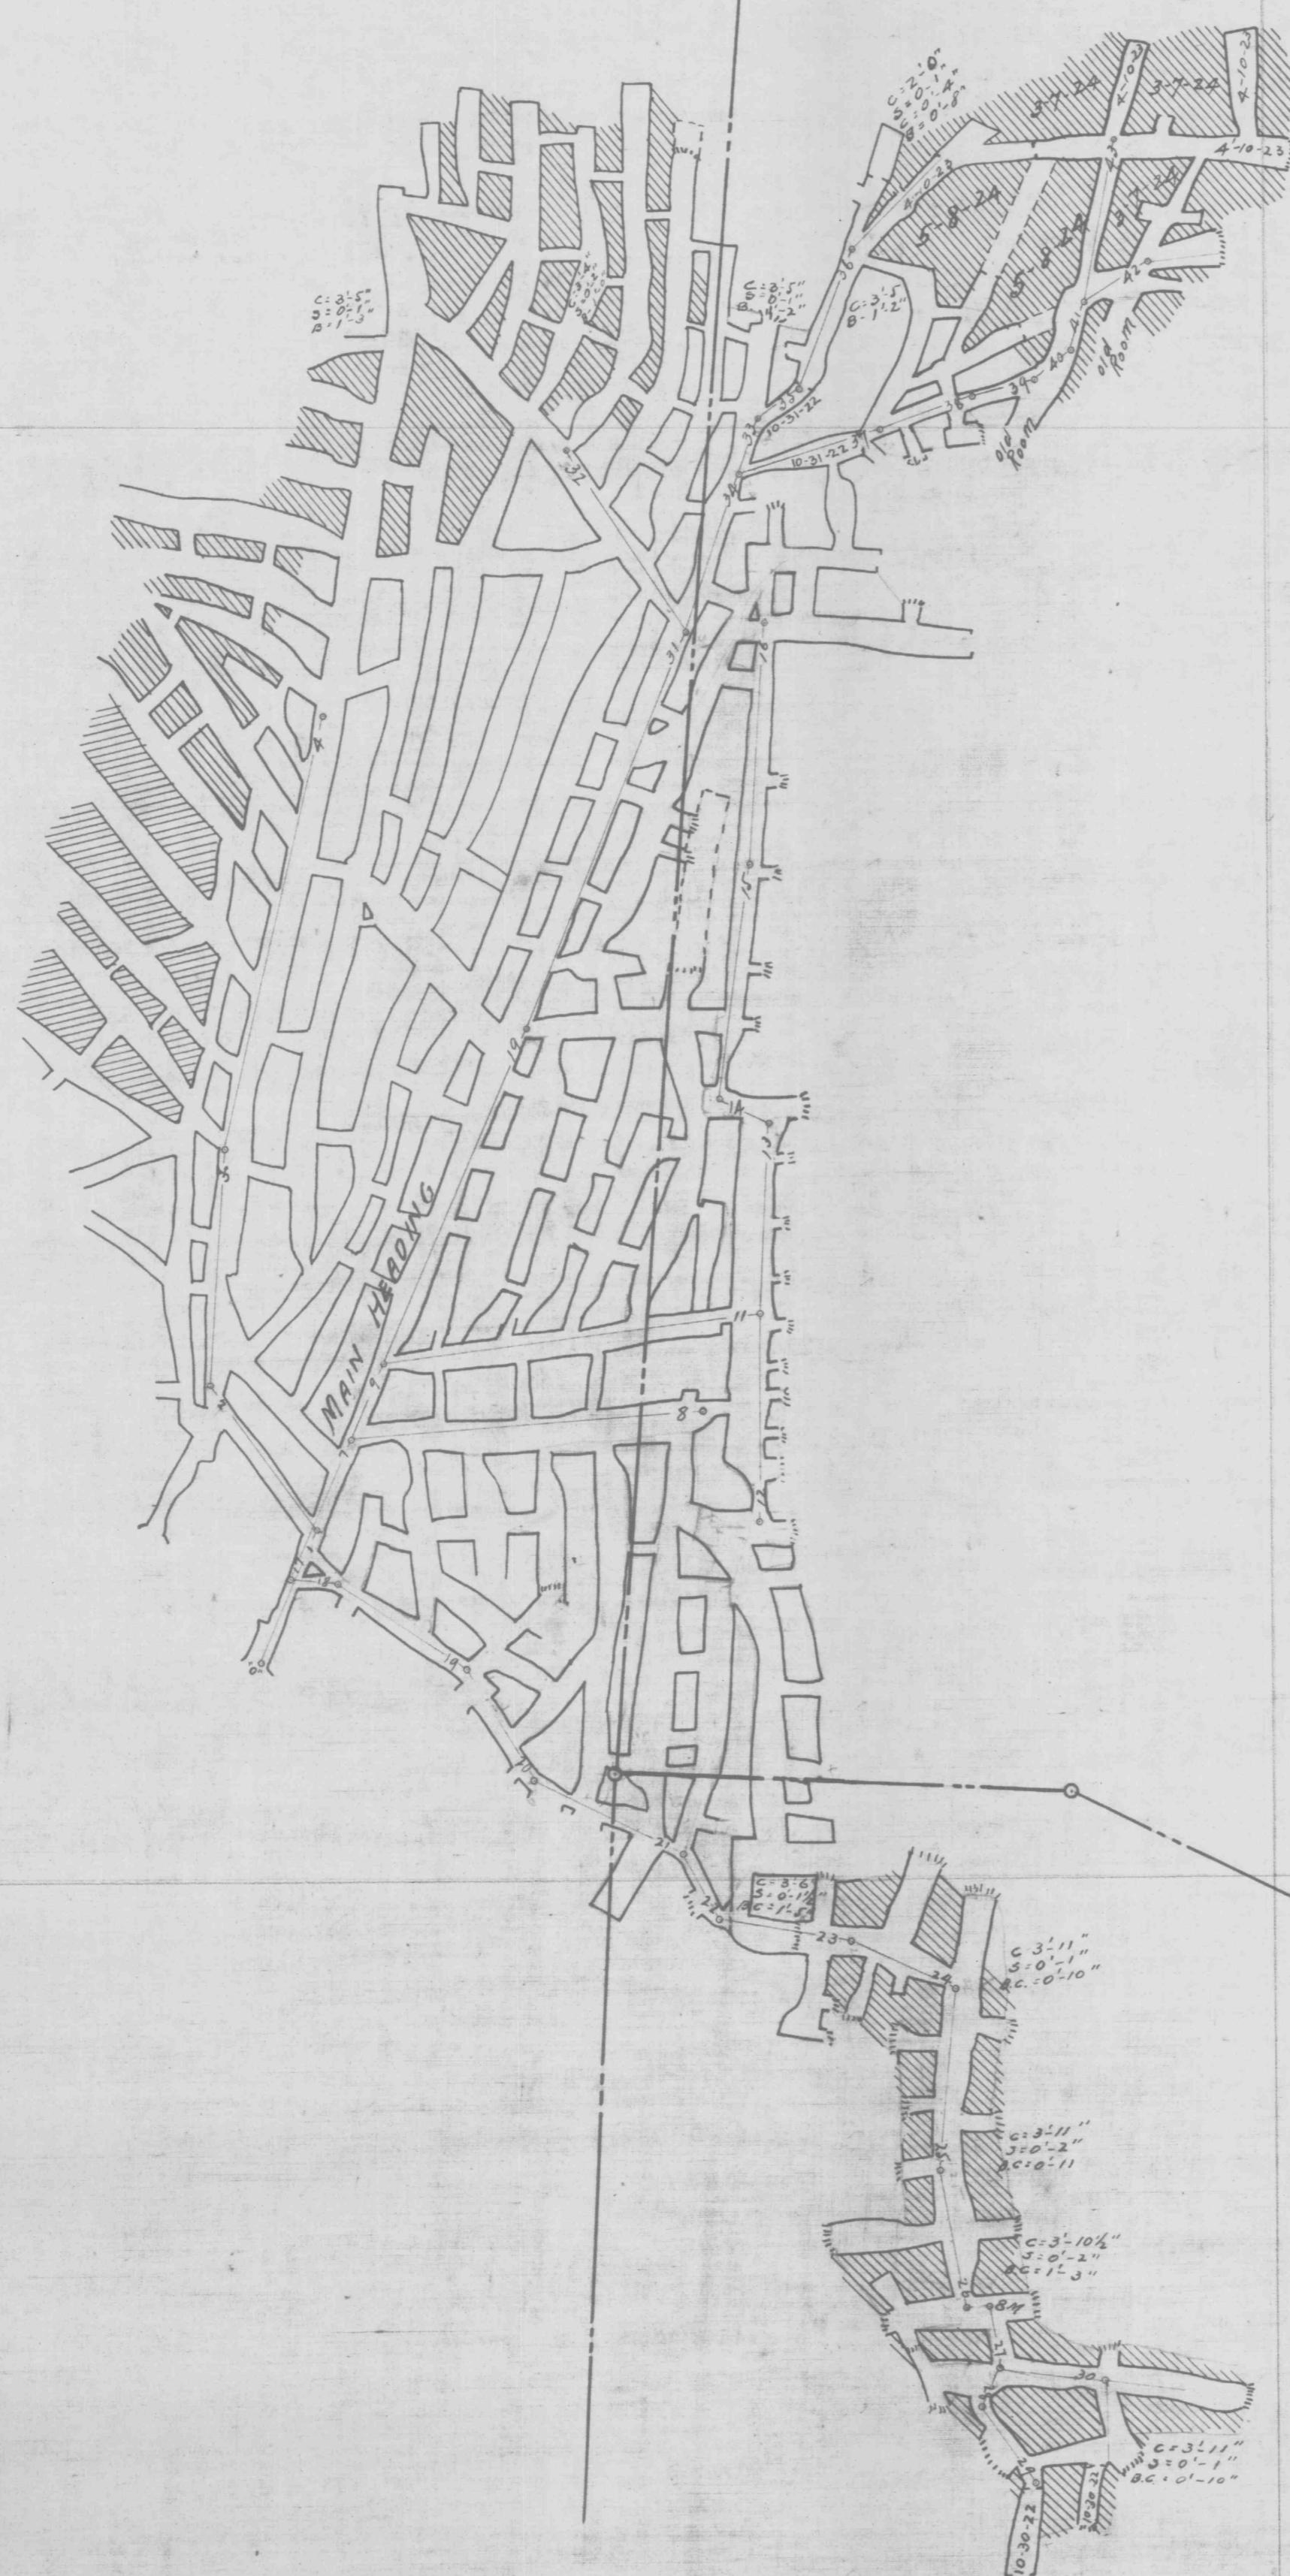

HENRY SWOPE

JACOB YAHNER

PENNSYLVANIA COAL & COKE CORPORATION
THOMAS MILLS COAL CO.
MINE NO. 1
WORKINGS IN RELATION TO THE TRACTS OF
HENRY SWOPE AND JACOB YAHNER
ENGINEERING DEPARTMENT PATTON, PA.
SURVEYED BY W.S.E. DATE DEC. 21-1918
PLATTED BY W.S.E. SCALE 1"-100'
CHECKED BY H.L.G. REVISED MAY 10-1924
APPROVED

DRAWING NO. P-422

N10000

N9000

N8000

W4-3000

W4-2000