

N-24000

N-22000

N-20000

N-18000

N-16000

N-14000

N-12000

N-10000

N-8000

N-6000

N-4000



A. D. LIBBY

JOHN POPE

PHILLIP CRONAUER

HENRY FODTER


CHAS. POPE

FRANCOIS YEAGER

ADAM HAAS

PETER BORN

Geo. Hoops

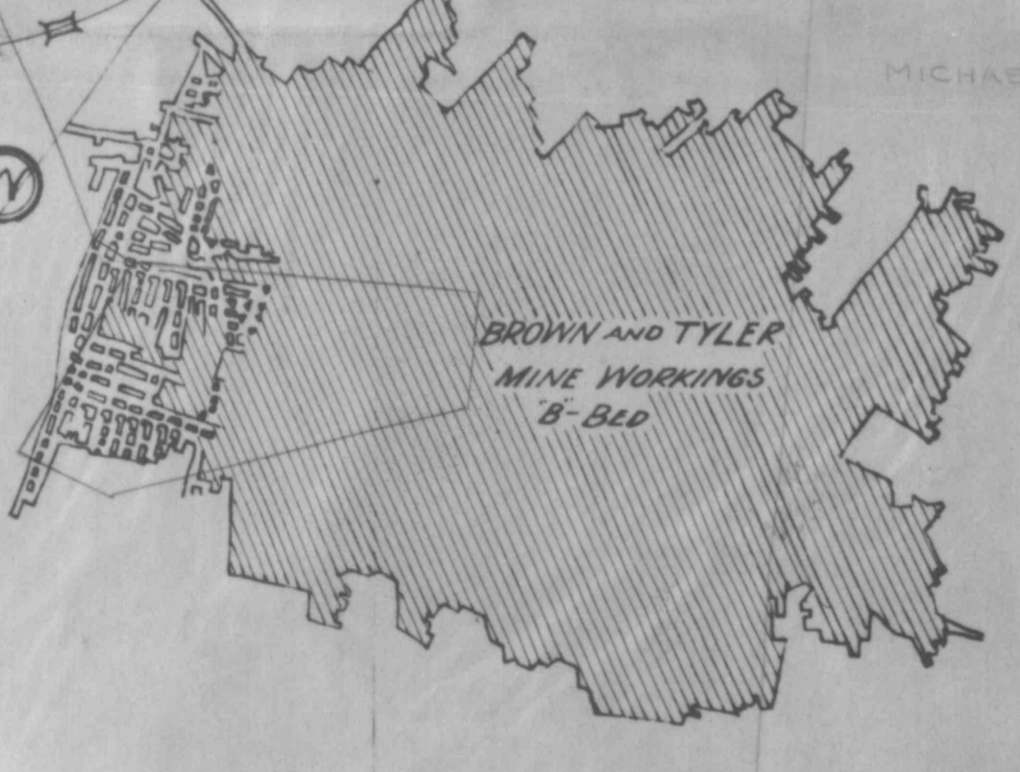

MICHAEL THOMAS

LEWIS ENHLER
M. ANDREWS

AUGUSTINE
SIMMELBERGER ET AL
1738A

J. SIMMELBERGER

ANDREW HAHN
34A. 8P

ANDREW HAHN
34A. 8P

JACOB REININGER

ELIZABETH

THOMAS

GEORGE KIBLER
4215 A
200A (25A)
4015A

JACOB HARTMAN
16A. 100P

JACOB HARTMAN
29A. 76P

GEORGE & CHARLES KIBLER
62A. 32P

FRANK X. OT
5A

F. L. KLINE

JOHN SCHELL
105A. 48P

PEOPLES NATURAL GAS CO.
197-100L NO. 125

FRANCIS HUBER

JAMES KIRKPATRICK

JAMES KIRKPATRICK
16A. 117P

LEWIS SCHIMPF
72A. 105P
61A. 105P

JOHN HAHN
42A. 8P

FRANCIS YAHNER
77A. 87P
15A. 87P

JOHN H. WEAVER
146A. 1

GEORGE M. WALTZ
15A. 17P

LOUIS SCHIMPF
112A
112A

JACOB KIRKPATRICK
M1A. 55P

CHARLES DELOZIER ESTATE
165A. 18P
155A. 8P

10 ACES
TA DELOZIER ET AL

JOHN HOOPS
170A. 113P

ANDREW WESTRICK

A. S. J. WESTRICK

A. WEAKLAND

PAUL YAHNER
17A. 76P

CHARLES ANNA
166A. 44P

W-14000

W-12000

W-10000

W-8000

W-6000

W-4000

