


B 134

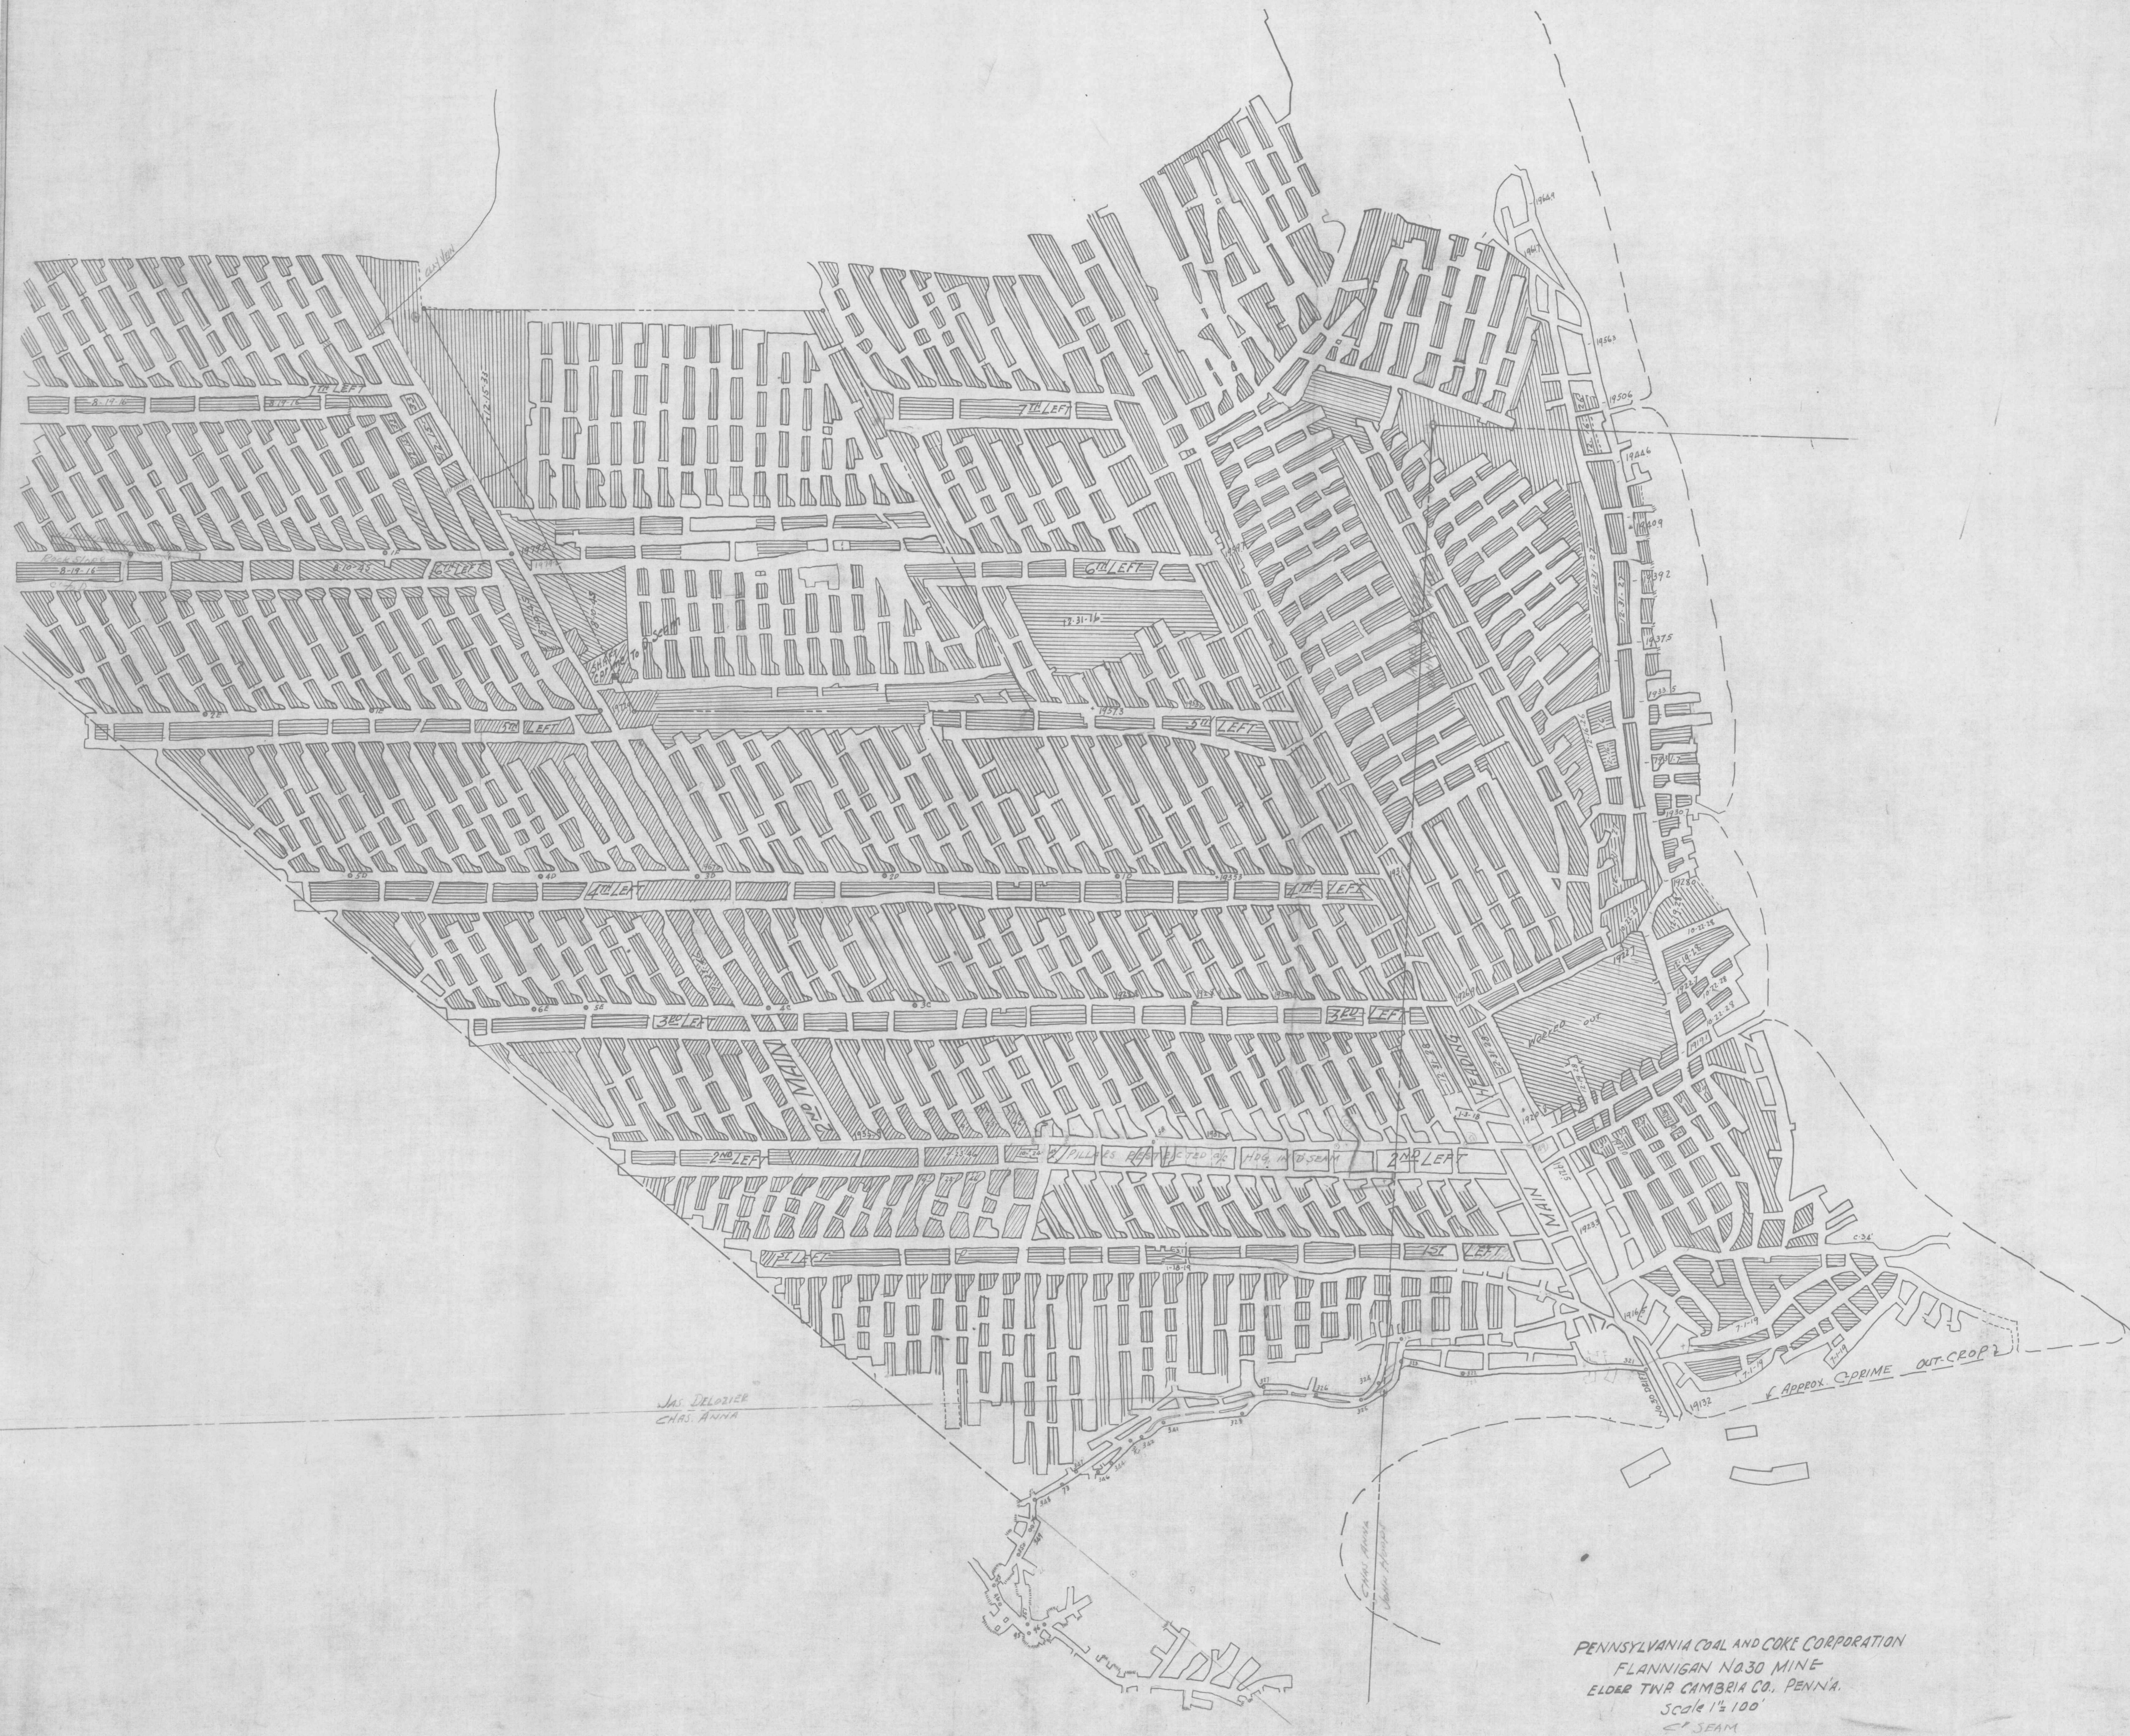

PENNSYLVANIA COAL AND COKE CORPORATION  
FLANNIGAN No 30 MINE  
ELDER TWR CAMBRIA CO., PENN'A.  
Scale 1" = 100'  
SEAM