


W-14000 W-15000 W-16000 W-17000

N-8000

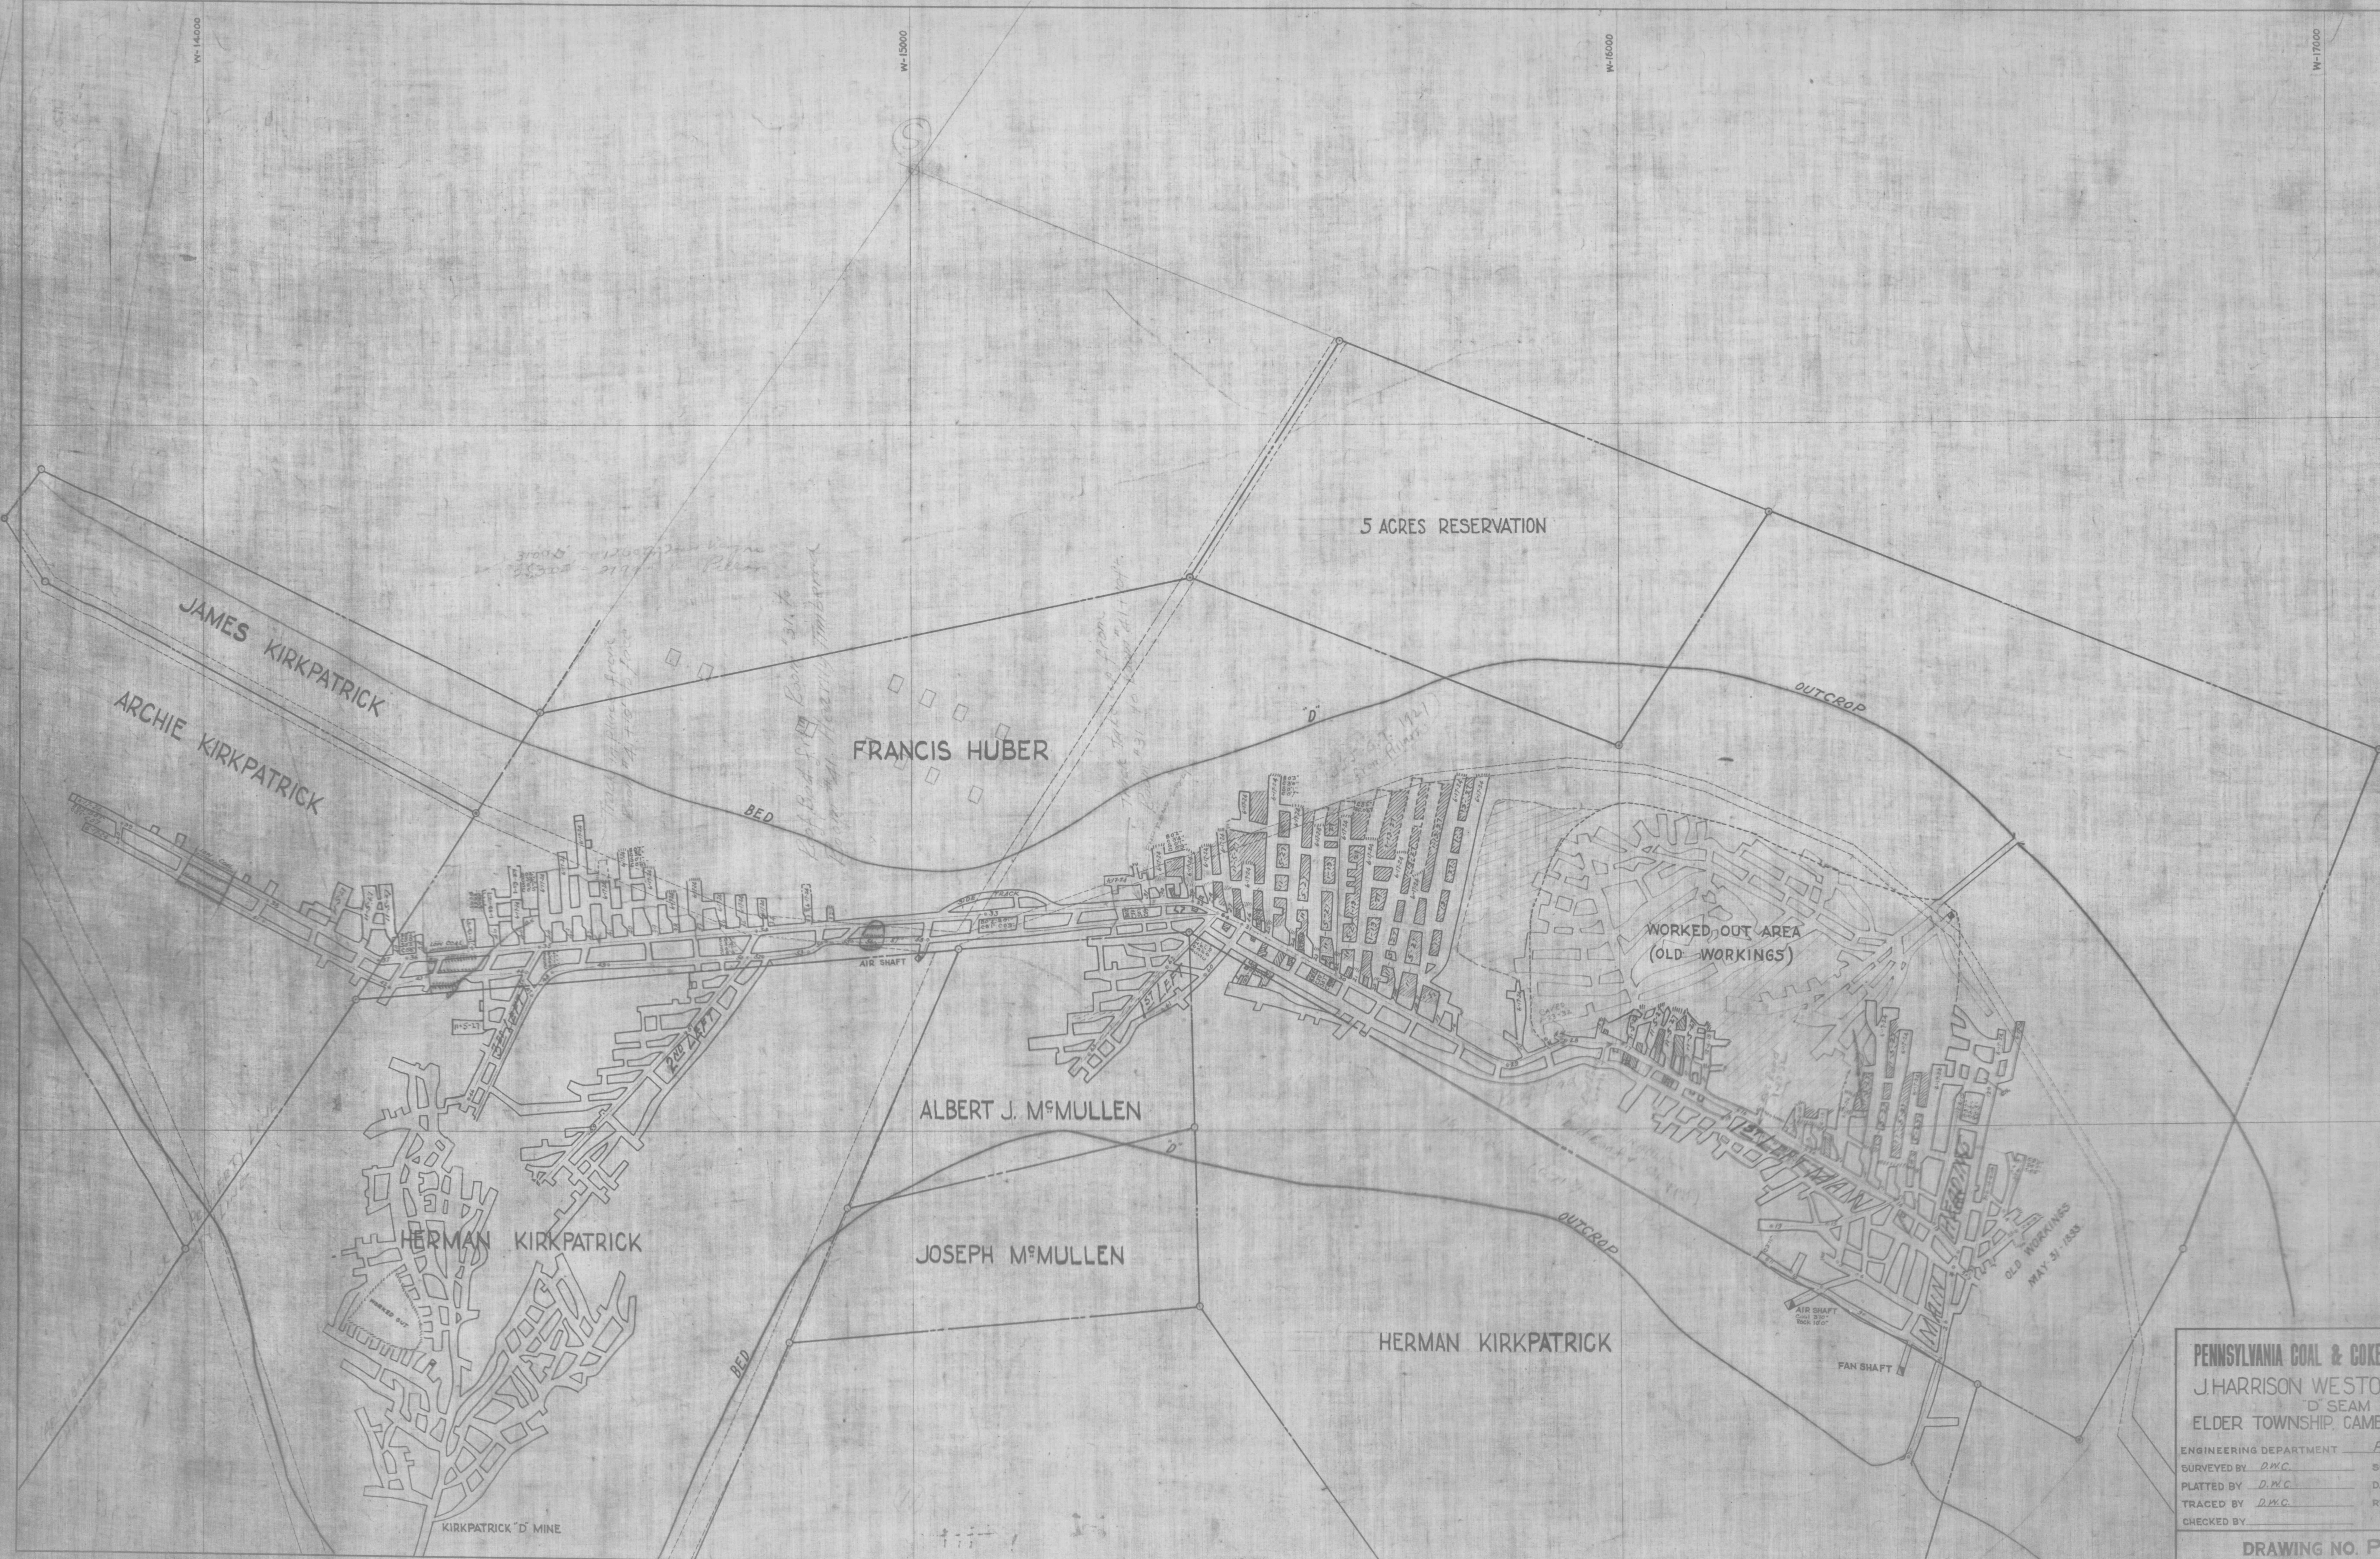

PENNSYLVANIA COAL & COKE CORPORATION
 J. HARRISON WESTOVER MINE
 D' SEAM
 ELDER TOWNSHIP, CAMBRIA CO., PA.
 ENGINEERING DEPARTMENT PATTON, PA.
 SURVEYED BY D.W.C. SCALE 1"=100'
 PLATTED BY D.W.C. DATE 12-4-19
 TRACED BY D.W.C. REVISED 8-17-24
 CHECKED BY _____

DRAWING NO. P-423